

Revision 1 - September 2001



December 16, 1999


To: See Distribution

Re: City of Chattanooga and Hamilton County Design and Construction Standards

Enclosed is a set of Design and Construction Standards for your use on all future projects within Hamilton County and the City of Chattanooga. These standards were prepared through a collaborative effort of the Engineering Division, Department of Public Works, City of Chattanooga and the Engineering Department, Public Works Division, Hamilton County.

We intend that this be a 'live' document with the City of Chattanooga maintaining the master copy and providing periodic revisions as required. Please use the attached comment sheet to inform us of suggested additions and of any changes that may be needed. Your comments are very important to keeping this document up to date.

Sincerely,

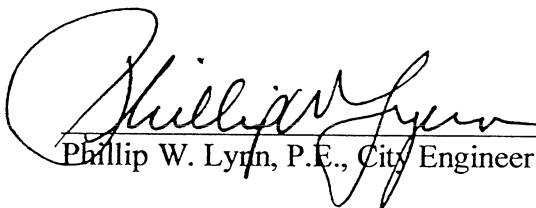
Phillip W. Lynn, P.E., City Engineer


Mike Howard, P.E., County Engineer

NAM

Enclosure

Distribution:



September 28, 2001

To: Persons Having Copies of Design and Construction Standards

Re: Revision-One Issue


The first revisions have been made to sheets in the City of Chattanooga and Hamilton County's manual Design and Construction Standards, and four sheets with new drawings have been added to it. Please find attached a copy of the cover sheet stamped to indicate the latest revision level and a copy of each of the referenced sheets with a complete listing of them on revised index sheets 1-3.


Because the changes and additions are now in effect, add the sheets to your manual, and remove the corresponding, unrevised ones. Also, there is a comment sheet for your use if you want to suggest additions or changes for a future issue of the manual.

Included too is a copy of the current back sheet (SD-703.01) to replace the one you have should it be damaged when you remove the tape to insert other sheets.

We hope that you have found the manual to be convenient and useful and that these revisions and additions will make it even better.

Sincerely,


Phillip W. Lynn, P.E., City Engineer

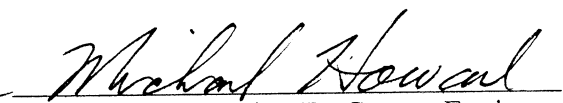
Michael L. Howard, P.E., County Engineer

ELB/ck

Enclosures:

Revised Sheets (39)
New Sheets (4)
Comment Sheet
Cover Sheet
Back Sheet (SD-703.01)

Mail to
the following:

Department of Public Works
Engineering Division
Development Resource Center
1250 Market Street
Chattanooga, TN 37402-2713

Phone: (423)757-5117

Fax: (423)757-0586

Attention: Ed Bowen

STANDARD DRAWING NUMBER(S):

COMMENTS:


CITY OF CHATTANOOGA
AND
HAMILTON COUNTY
TENNESSEE



DESIGN AND
CONSTRUCTION
STANDARDS



CITY OF CHATTANOOGA
DEPARTMENT OF PUBLIC WORKS
ENGINEERING DIVISION

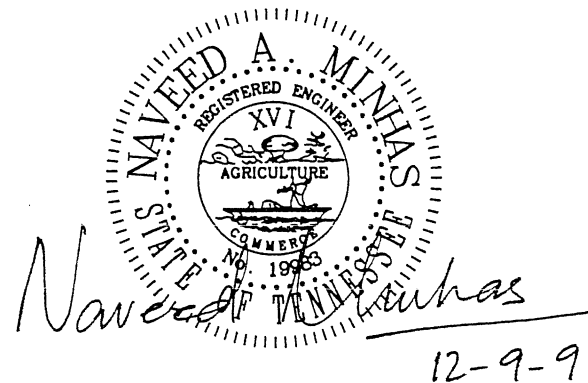

NAVEED A. MINHAS, P.E.
ENGINEERING MANAGER
STATE LICENSE NO. 19983

APPROVED FOR RELEASE


PHILLIP W. LYNN, P.E.
CITY ENGINEER

DATE

DATE

REVISION LEVEL		
NO.	DATE	APPROVED
1	8/24/01	NMA

HAMILTON COUNTY
PUBLIC WORKS DIVISION
ENGINEERING DEPARTMENT

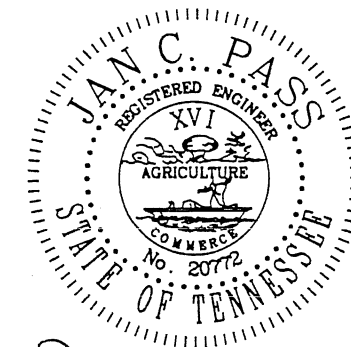

JAN C. PASS, P.E.
ENGINEERING PROJECTS MANAGER
STATE LICENSE NO. 20772

APPROVED FOR RELEASE

MICHAEL L. HOWARD, P.E.
COUNTY ENGINEER

DATE

DATE

INDEX OF DRAWINGS



DRAWING NUMBER

TITLE

REVISION NUMBER

DATE

GENERAL			
SD-100.01	GENERAL NOTES	1	8-24-01
SD-100.02	GENERAL NOTES	1	8-24-01
SD-101.01	UTILITY OWNERS	1	8-24-01
HIGHWAYS, ROADS, AND STREETS			
SD-200.01	ROADWAY SECTIONS	1	8-24-01
SD-200.02	ROADWAY SECTIONS	1	8-24-01
SD-201.01	CONCRETE CURBS (6" DETACHED AND HEADER)	1	8-24-01
SD-202.01	CONCRETE CURB AND GUTTER (TYPE "A")	1	8-24-01
SD-202.02	CONCRETE CURB AND GUTTER (TYPE "A")	1	8-24-01
SD-203.01	CONCRETE CURB (RESIDENTIAL)	1	8-24-01
SD-203.02	CONCRETE CURB (RESIDENTIAL)	0	12-10-99
SD-204.01	PRIVATE DRIVEWAY APPROACH (RESIDENTIAL)	1	8-24-01
SD-205.01	HANDICAP RAMP DETAILS	0	12-10-99
SD-205.02	HANDICAP RAMP DETAILS	1	8-24-01
SD-206.01	MOUNTABLE ISLAND CURB	0	8-24-01
SANITARY SEWERS			
SD-300.01	SANITARY/STORM MANHOLE (PRECAST)	1	8-24-01
SD-301.01	SANITARY/STORM MANHOLE DETAILS	1	8-24-01
SD-301.02	SANITARY/STORM MANHOLE DETAILS	0	12-10-99
SD-301.03	SANITARY/STORM MANHOLE DETAILS	1	8-24-01
SD-301.04	SANITARY/STORM MANHOLE DETAILS	1	8-24-01
SD-302.01	SANITARY MANHOLE DROP CONNECTION	1	8-24-01
SD-303.01	SANITARY SEWER SERVICE CONNECTION AND LATERAL DETAIL	1	8-24-01
SD-304.01	HIGHWAY CROSSING FOR SANITARY SEWERS	1	8-24-01
SD-305.01	CREEK AND DITCH CROSSINGS FOR SANITARY SEWERS	0	12-10-99
SD-306.01	TRENCH CHECK DAM	1	8-24-01
SD-307.01	TRENCH DETAILS AND BEDDING (SANITARY SEWERS/STORM SEWERS)	1	8-24-01
SD-308.01	TRENCH DETAILS (CONCRETE PROTECTION)	1	8-24-01
SD-308.02	TRENCH DETAILS (CONCRETE PROTECTION)	1	8-24-01
SD-309.01	SEWER SERVICE TAP (15" OR LARGER SEWER MAIN)	0	8-24-01
SD-310.01	OIL SKIMMER	0	8-24-01

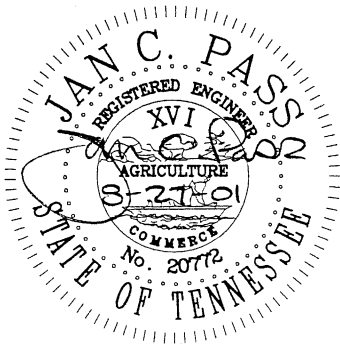
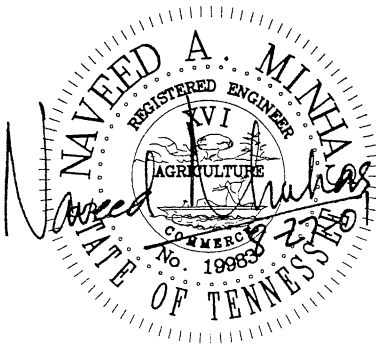


			CITY OF CHATTANOOGA AND HAMILTON COUNTY	
			INDEX OF DRAWINGS - 1/3	
1	ADDED SD-206.01, 309.01, 310.01;			
	OTHER REVISIONS AS NOTED	8/24/01	DATE OF ORIGINAL ISSUE	STANDARD NUMBER : (INDEX - 1/3)
0	INITIAL ISSUE	12/10/99	DECEMBER 10, 1999	
NO.	REVISION	DATE		

INDEX OF DRAWINGS

DRAWING NUMBER	TITLE	REVISION NUMBER	DATE
STREETSCAPE			
SD-500.01	TREEWELL DETAILS	1	8-24-01
SD-500.02	TREEWELL DETAILS	1	8-24-01
SD-501.01	PAVER LAYOUT	1	8-24-01
SD-501.02	PAVER LAYOUT	1	8-24-01
SD-502.01	STREETSCAPE UTILITY COLLAR DETAILS	0	12-10-99
SD-503.01	PAVER EDGE DETAILS AND COLOR CHART	1	8-24-01
SD-504.01	PAVER INTERSECTION DETAIL	1	8-24-01
SD-505.01	STREETSCAPE GUARDRAIL DETAIL	0	12-10-99
SD-506.01	FOUNDATION DETAILS (39' STREETLIGHT POLE)	1	8-24-01
SD-507.01	FOUNDATION DETAILS (12' PEDESTRIAN LIGHT POLE)	1	8-24-01
SD-508.01	PARKING METER DETAILS	0	12-10-99
SD-509.01	PERVIOUS CONCRETE PAVER DETAIL	0	8-24-01
DRAINAGE			
SD-300.01	SANITARY/STORM MANHOLE (PRECAST)	1	8-24-01
SD-301.01	SANITARY/STORM MANHOLE DETAILS	1	8-24-01
SD-301.02	SANITARY/STORM MANHOLE DETAILS	0	12-10-99
SD-301.03	SANITARY/STORM MANHOLE DETAILS	1	8-24-01
SD-301.04	SANITARY/STORM MANHOLE DETAILS	1	8-24-01
SD-307.01	TRENCH DETAILS AND BEDDING (SANITARY SEWERS/STORM SEWERS)	1	8-24-01
SD-308.01	TRENCH DETAILS (CONCRETE PROTECTION)	1	8-24-01
SD-308.02	TRENCH DETAILS (CONCRETE PROTECTION)	1	8-24-01
SD-310.01	OIL SKIMMER	0	8-24-01
SD-600.01	STORM MANHOLE (BRICK/CAST-IN-PLACE)	0	12-10-99
SD-601.01	CONCRETE ENDWALL (TYPE "S")	0	12-10-99
SD-602.01	CONCRETE ENDWALL (TYPE "L")	0	12-10-99
SD-603.01	CONCRETE ENDWALL (TYPE "U")	0	12-10-99
SD-604.01	CONCRETE ENDWALL (TYPE "W")	0	12-10-99
SD-605.01	CONCRETE ENDWALL (PRECAST/FLARED)	0	12-10-99
SD-606.01	DROP INLET	0	12-10-99
SD-607.01	DROP INLET (PRECAST CONCRETE)	1	8-24-01
SD-608.01	CATCH BASIN (STANDARD), FRAME, AND GRATE	1	8-24-01
SD-608.02	CATCH BASIN (STANDARD), FRAME, AND GRATE	1	8-24-01
SD-609.01	CURB INLET (CONCRETE/BRICK)	0	12-10-99
SD-609.02	CURB INLET (CONCRETE/BRICK)	1	8-24-01
SD-610.01	CURB INLET (PRECAST CONCRETE)	0	12-10-99
SD-610.02	CURB INLET (PRECAST CONCRETE)	1	8-24-01

F:\STDDWG\StdIndexPg\INDEXPG_2.dwg

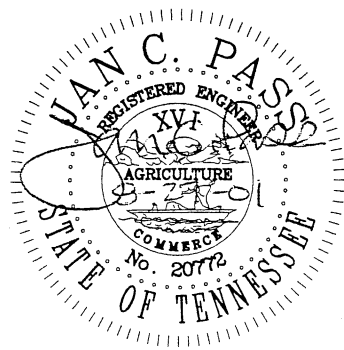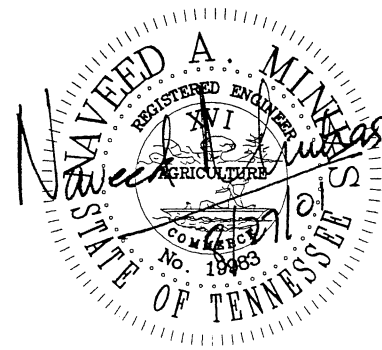

CITY OF CHATTANOOGA AND HAMILTON COUNTY			
INDEX OF DRAWINGS - 2/3			
1	ADDED SD-310.01 AND SD-509.01;	8/24/01	STANDARD NUMBER: (INDEX - 2/3)
0	OTHER REVISIONS AS NOTED	12/10/99	
0	INITIAL ISSUE	12/10/99	
NO.	REVISION	DATE	
DATE OF ORIGINAL ISSUE		DECEMBER 10, 1999	



INDEX OF DRAWINGS

DRAWING NUMBER TITLE REVISION NUMBER DATE

REPAIRS			
SD-700.01	REPAIR DETAILS (ROADWAY)	1	8-24-01
SD-700.02	REPAIR DETAILS (ROADWAY)	0	12-10-99
SD-701.01	REPAIR DETAILS (CURB AND GUTTER/SIDEWALK)	0	12-10-99
SD-702.01	REPAIR DETAILS (SIDEWALK) - POLE REPLACEMENT	0	12-10-99
SD-703.01	REPAIR DETAILS (DRIVEWAY/PARKING LOT)	0	12-10-99

1

F:\STDDWGS\StdIndexPg\INDEXPG_3.dwg

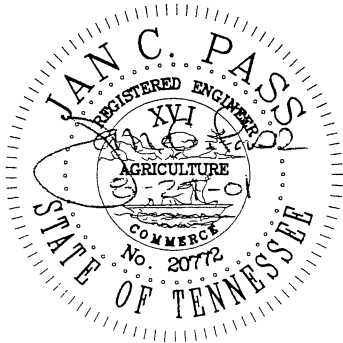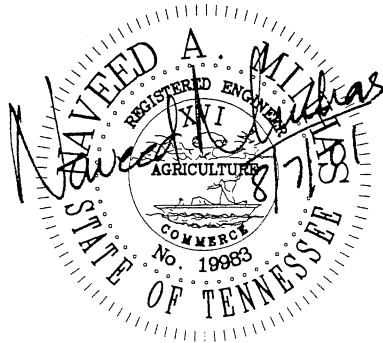

			CITY OF CHATTANOOGA AND HAMILTON COUNTY	
			INDEX OF DRAWINGS - 3/3	
1	REVISION 1 ISSUE	8/24/01	DATE OF ORIGINAL ISSUE DECEMBER 10, 1999	STANDARD NUMBER: (INDEX - 3/3)
0	INITIAL ISSUE	12/10/99		
NO.	REVISION	DATE		

GENERAL

GENERAL NOTES

GRADING AND EXCAVATION

1. FINISHED GRADES ON PROFILES ARE THE SAME AS FINISHED GRADES SHOWN ON TYPICAL SECTIONS AND ON CROSS SECTIONS.
2. WHEN SPECIFIED GRADING REQUIREMENTS ARE NOT SHOWN ON THE DRAWINGS, THE CONTRACTOR SHALL GRADE TO DRAIN ALL AREAS WITHIN THE LIMITS OF CONSTRUCTION, OR OTHERWISE DISTURBED BY CONSTRUCTION, AND ALSO TO MATCH THE EXISTING, ADJACENT GROUND.
3. THE CONTRACTOR SHALL PERFORM ALL NECESSARY STRIPPING OF EXISTING TOPSOIL ON THE JOBSITE.
4. ON THE PROJECT, NEWLY GRADED, EARTH AREAS NOT TO BE PAVED, RIP-RAPPED, OR STABILIZED, SHALL BE SEEDED IN ACCORDANCE WITH THE CITY OR COUNTY SPECIFICATIONS. PRIOR TO SEEDING, A FOUR-INCH (4") LAYER OF TOPSOIL SHALL BE PLACED ON THESE AREAS IN ACCORDANCE WITH SAID SPECIFICATIONS. ALL EXISTING ROADS OR RAMPS TO BE ABANDONED WITHIN THE RIGHT-OF-WAY SHALL BE SCARIFIED AND OBLITERATED, THEN HAVE TOPSOIL AND SEED ADDED.
5. THE CONTRACTOR IS TO DISPOSE OF, AT HIS OWN EXPENSE, ALL UNSUITABLE AND/OR SURPLUS, EXCAVATED MATERIAL AS DIRECTED BY THE ENGINEER. ALL SUITABLE, EXCAVATED MATERIAL SHALL BE USED AS DIRECTED BY THE ENGINEER.
6. THE CONTRACTOR SHALL BE REQUIRED TO REMOVE SECTIONS OF EXISTING CURB, OR CURB AND GUTTER, THAT ARE RENDERED OBSOLETE.
7. EXCAVATION ADJACENT TO EXISTING PAVEMENT SHALL BE MADE TO A NEAT LINE.

EROSION/POLLUTION CONTROL



8. THE CONTRACTOR SHALL TAKE ALL NECESSARY MEASURES TO CONTROL EROSION AND WATER POLLUTION THROUGH THE CONSTRUCTION PERIOD. ALL TEMPORARY EROSION CONTROL MEASURES SHALL BE IN PLACE BEFORE EARTH MOVING OPERATIONS BEGIN. CLEARING AND GRUBBING SHALL BE HELD TO A MINIMUM WIDTH NECESSARY TO ACCOMMODATE ROADWAY SLOPES. EMBANKMENTS AND EXCAVATED AREAS SHALL BE PROMPTLY STABILIZED TO MINIMIZE EROSION. BALED STRAW EROSION CHECKS AND SILT FENCING SHALL BE USED ALONG THE TOE OF FILL SLOPES, IN DITCHES, AND IN OTHER AREAS WHERE EROSION IS A PROBLEM AND SILT-LADEN RUNOFF MAY ENTER A STREAM OR ADJACENT PROPERTY.
9. ANY STOCKPILED SOIL OR FILL MATERIAL SHALL BE LOCATED AND TREATED IN A MANNER TO PREVENT SILT'S ENTERING STREAMS. NO EXCAVATED MATERIAL SHALL BE DISCHARGED INTO DITCHES. THE CONTRACTOR SHALL DISPOSE OF ALL EXCAVATED MATERIAL IN A LOCATION, APPROVED BY THE ENGINEER, ABOVE THE NORMAL HIGH WATER ELEVATION.
10. THE CONTRACTOR IS RESPONSIBLE FOR ADHERING TO ALL EROSION CONTROL PROVISIONS AS SET FORTH IN THE BEST MANAGEMENT PRACTICES MANUAL AVAILABLE FROM THE ENGINEERING/STORMWATER DIVISION OF THE CITY OF CHATTANOOGA, DEPARTMENT OF PUBLIC WORKS. REFER TO CITY ORDINANCE 9942, AS AMENDED.
11. THE CONTRACTOR SHALL PROVIDE TEMPORARY EROSION AND WATER CONTROL MEASURES (SUCH AS BERMS, SEDIMENT BASINS, SLOPE DRAINS, HAY BALES, AND SILT FENCES) AS DIRECTED BY THE ENGINEER. THESE TEMPORARY MEASURES SHALL BE COORDINATED WITH THE PERMANENT EROSION CONTROL FEATURES TO ASSURE ECONOMICAL, EFFECTIVE, AND CONTINUOUS EROSION CONTROL THROUGHOUT THE PROJECT.
12. NO EARTH OR OTHER ERODIBLE MATERIAL SHALL BE USED TO DIVERT STREAM FLOW OR TO CONSTRUCT COFFERDAMS. CLEAN CUT ROCK WITH FINES MAY BE USED, OR, IN THE CASE OF COFFERDAMS, STEEL SHEETING IS PERMISSIBLE. WATER OR SEDIMENT ISOLATED BY COFFERDAMS OR DISPLACED FOOTINGS SHALL BE PUMPED INTO SEDIMENT BASINS ON THE BANK OF THE STREAM.

DRAINAGE

13. THE CONTRACTOR IS REQUIRED TO CONNECT ALL EXISTING STORM DRAINAGE PIPING TO PROPOSED DRAINAGE STRUCTURES AS MAY BE REQUIRED BY THE FIELD ENGINEER.
14. EXISTING DOWNSPOUT DRAINAGE THAT IS CONNECTED TO THE PRESENT STORM SEWER SYSTEM SHALL BE CONNECTED TO THE PROPOSED STORM SEWER SYSTEM.
15. THE CONTRACTOR SHALL BE REQUIRED TO BACKFILL STORM SEWERS WITH BACKFILL MATERIAL ACCORDING TO THESE STANDARD DRAWINGS OR AS DIRECTED BY THE ENGINEER.

UTILITIES

16. LOCATIONS OF UTILITIES, PUBLIC AND/OR PRIVATE, ARE APPROXIMATE ONLY, AND THE EXACT LOCATIONS SHALL BE DETERMINED IN THE FIELD. IT IS POSSIBLE THAT SOME EXISTING FACILITIES ARE NOT SHOWN ON THESE DRAWINGS. THE CONTRACTOR SHALL BE RESPONSIBLE FOR HAVING ALL UNDERGROUND UTILITY FACILITIES LOCATED AND MARKED PRIOR TO THE BEGINNING OF CONSTRUCTION.
17. UTILITY OWNERS ARE TO RESET, RELAY, OR ADJUST, AT THEIR OWN EXPENSE, POWER AND TELEPHONE LINES, POWER POLES, WATER AND GAS LINES, AND ALL OTHER FACILITIES INCLUDING METERS, VALVES, PITS, ETC., CONFLICTING WITH THE PROPOSED IMPROVEMENTS WITHIN THE EXISTING RIGHT-OF-WAY. ALL RELOCATED POLES, METERS, VALVES, ETC., ARE TO BE LOCATED BEHIND THE SIDEWALK OR ON THE RIGHT-OF-WAY LINE.
18. THE CONTRACTOR SHALL BE SOLELY RESPONSIBLE FOR CONTACTING ALL AFFECTED UTILITY OWNERS PRIOR TO SUBMITTING HIS BID, SO THAT HE MAY DETERMINE THE EXTENT OF DELAYS THAT UTILITY RELOCATIONS AND/OR ADJUSTMENTS MAY HAVE UPON THE SCHEDULING OF WORK FOR THE PROJECT. SOME UTILITY FACILITIES MAY NEED TO BE ADJUSTED CONCURRENTLY WITH THE CONTRACTOR'S OPERATIONS, WHILE SOME WORK MAY BE REQUIRED AROUND UTILITY FACILITIES THAT SHALL REMAIN IN PLACE. IT IS SPECIFIED AND AGREED THAT THE CONTRACTOR SHALL RECEIVE NO ADDITIONAL COMPENSATION FOR ANY DELAYS OR INCONVENIENCE CAUSED BY UTILITY ADJUSTMENTS.
19. THE CONTRACTOR SHALL NOTIFY ALL AFFECTED UTILITY OWNERS PRIOR TO INTERRUPTING ANY GAS, WATER, OR SEWER SERVICES. THE CONTRACTOR SHALL ALSO NOTIFY AFFECTED UTILITY CUSTOMERS AT LEAST 24 HOURS BEFORE INTERRUPTING THE CUSTOMERS' SERVICE. WHERE INDIVIDUAL SERVICES ARE TO BE DISCONTINUED FOR MORE THAN 4 HOURS, THE CONTRACTOR SHALL MAKE ARRANGEMENTS FOR PROVIDING TEMPORARY SERVICE SATISFACTORY TO THE AFFECTED CUSTOMER. THE REPAIR OR REPLACEMENT OF UTILITY COMPONENTS SHALL CONFORM TO ALL APPLICABLE REQUIREMENTS OF THE UTILITY OWNER. NO SEPARATE PAYMENT SHALL BE MADE FOR THESE ACTIVITIES, AND COMPENSATION SHALL BE INCLUDED IN THE CONTRACT PRICES FOR OTHER ITEMS.
20. THE CONTRACTOR SHALL PROVIDE ALL NECESSARY PROTECTIVE MEASURES TO SAFEGUARD EXISTING UTILITIES FROM DAMAGE DURING CONSTRUCTION OF THIS PROJECT. SHOULD SPECIAL EQUIPMENT BE REQUIRED TO WORK OVER AND AROUND THE UTILITIES, THE CONTRACTOR SHALL BE REQUIRED TO FURNISH SUCH EQUIPMENT. THE COST OF PROTECTING UTILITIES FROM DAMAGE AND FROM FURNISHING SPECIAL EQUIPMENT SHALL BE INCLUDED IN THE PRICE BID FOR OTHER ITEMS OF CONSTRUCTION.
21. ANY EXISTING STORM SEWER DAMAGED DURING CONSTRUCTION SHALL BE REPAIRED AS RAPIDLY AS POSSIBLE AND THEN BE INSPECTED BY ITS RESPECTIVE OWNER. THE ENGINEER SHALL DETERMINE IF DAMAGE IS THE RESULT OF THE CONTRACTOR'S NEGLIGENCE OR OF AN UNAVOIDABLE CAUSE.
22. IF ANY SANITARY SEWER IS DAMAGED DURING CONSTRUCTION, THE CONTRACTOR SHALL IMMEDIATELY NOTIFY THE UTILITY'S OWNER. REPAIR OF THE SEWER SHALL THEN BE ACCORDING TO THE OWNER'S INSTRUCTIONS. THE ENGINEER SHALL DETERMINE IF DAMAGE IS THE RESULT OF THE CONTRACTOR'S NEGLIGENCE OR OF AN UNAVOIDABLE CAUSE.
23. ALL CUTS AND FILLS ARE TO BE IN PLACE, AND FILLS COMPACTED, PRIOR TO INSTALLATION OF SANITARY SEWERS AND APPURTENANCES.
24. ALL SANITARY SEWER CONSTRUCTION MUST BE DONE BY A LICENSED MUNICIPAL UTILITY CONTRACTOR-CLASSIFICATION MU.
25. TRANSITION JOINTS ON SANITARY SEWER PIPES OF DIFFERENT MATERIALS MUST BE APPROVED BY THE JURISDICTIONAL ENGINEER, AND CONSTRUCTION MUST BE DONE WITH APPROVED FITTINGS AND/OR ADAPTERS.
26. ALL PROPOSED SANITARY SEWER LINES AND MANHOLES SHALL BE INSTALLED IN ACCORDANCE WITH CITY OF CHATTANOOGA/HAMILTON COUNTY STANDARD DETAILS AND SPECIFICATIONS.
27. THE CONTRACTOR SHALL NOTIFY THE INSPECTOR AT (423)757-5120 (CITY) OR (423)209-6410 (COUNTY) AT LEAST 48 HOURS PRIOR TO THE START OF SEWER CONSTRUCTION.

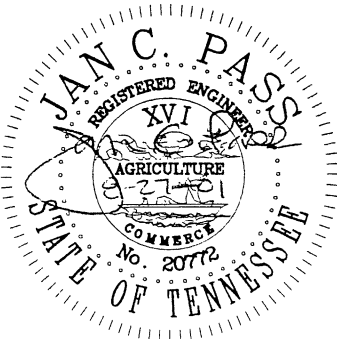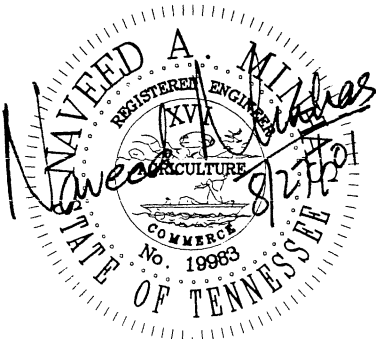

1	REVISIONS AS MARKED OR CLOUDED	8/24/01
0	INITIAL ISSUE	12/10/99
NO.	REVISION	DATE

CITY OF CHATTANOOGA AND HAMILTON COUNTY
GENERAL NOTES

DATE OF ORIGINAL ISSUE
DECEMBER 10, 1999

STANDARD NUMBER : SD-100.01

GENERAL NOTES

28. SANITARY SEWER LINES SHALL BE OF DUCTILE IRON PIPE AT ALL LOCATIONS WHERE SANITARY LINES CROSS WITHIN 18 INCHES ABOVE OR BELOW A STORM SEWER LINE. AS AN ALTERNATE, IF SANITARY SEWER LINES ARE PVC, THEN CONCRETE PROTECTION SHALL BE PROVIDED.
29. WHERE WATER PIPING CROSSES THE SANITARY SEWER LINE, THE WATER SERVICE WITHIN 10 FEET OF THE POINT OF CROSSING SHALL BE AT LEAST 18 INCHES ABOVE THE TOP OF THE SEWER LINE. THE SEWER LINE SHALL BE OF DUCTILE IRON WITH MECHANICAL JOINTS AT LEAST 10 FEET ON BOTH SIDES OF THE CROSSING.
30. ANCHOR COLLARS SHALL BE PROVIDED ON SANITARY SEWER LINES WITH SLOPES EXCEEDING 18% WITH SPACING AS SPECIFIED BY THE STATE OF TENNESSEE DESIGN CRITERIA FOR SEWAGE WORKS.
31. SERVICE LATERALS EXTENDING TO THE PROPERTY LINE SHALL EACH HAVE A CLEANOUT AT THE PROPERTY LINE.
32. ALL CONNECTIONS TO EXISTING MANHOLES MUST BE CORED AND BOOTED AND THE INVERTS REFORMED.
33. TOPS OF ALL MANHOLES SHALL BE RAISED TO BE AT LEAST FLUSH WITH OR ABOVE NEW FINISHED GRADES AND BE VISIBLE.
34. MANHOLES RAISED 8 INCHES OR LESS SHALL BE DONE BY THE USE OF CONCRETE RINGS OR "DOUGHNUTS". MANHOLES RAISED GREATER THAN 8 INCHES SHALL REQUIRE THE REMOVAL OF THE CONE SECTION AND PLACEMENT OF THE APPROPRIATE SIZE MANHOLE RISER. THE CONE SECTION SHALL THEN BE REINSTALLED OR REPLACED DEPENDING ON CONDITION.
35. ALL SEWER LINES SHALL BE TESTED AND APPROVED AFTER ALL OTHER UTILITIES HAVE BEEN INSTALLED.
36. UPON COMPLETION OF THE PROJECT, ALL PUBLIC SEWER EASEMENTS OBTAINED SHALL BE SUBMITTED TO THE JURISDICTIONAL WASTEWATER AUTHORITY WITHIN 30 DAYS.
37. ALL NEWLY CONSTRUCTED SANITARY SEWERS SHALL BE TELEVISED AT THE REQUEST OF THE JURISDICTIONAL ENGINEER.

TRAFFIC

38. UPON NOTICE OF AWARD OF A CITY OF CHATTANOOGA CONTRACT, THE CONTRACTOR SHALL SUBMIT, WITHIN TEN (10) DAYS, A CONSTRUCTION SCHEDULE. THE CITY OF CHATTANOOGA'S TRAFFIC ENGINEERING DEPARTMENT SHALL PROVIDE A WORK ZONE TRAFFIC CONTROL PLAN WITHIN FIVE (5) DAYS THEREAFTER.
39. DURING CONSTRUCTION, THE CONTRACTOR SHALL MAINTAIN TRAFFIC AND PROVIDE TRAFFIC CONTROL DEVICES IN CONFORMANCE WITH THE MANUAL ON UNIFORM TRAFFIC CONTROL DEVICES (MUTCD). THE CONTRACTOR SHALL ALSO FURNISH AND INSTALL TRAFFIC SIGNS AND MARKINGS AS REQUIRED BY THE MUTCD AND THE CITY OF CHATTANOOGA'S TRAFFIC ENGINEERING DEPARTMENT OR HAMILTON COUNTY'S ENGINEERING DEPARTMENT, WHICHEVER IS APPROPRIATE.
40. PERMANENT SIGNS AND PAVEMENT MARKINGS SHALL BE PLACED BY THE CITY/COUNTY UNLESS OTHERWISE INDICATED ON THE DRAWINGS.
41. THE CONTRACTOR SHALL MAINTAIN ALL BUSINESS, VEHICULAR, AND PEDESTRIAN ENTRANCES.
42. THE CONTRACTOR SHALL PROVIDE A PEDESTRIAN WALKWAY THAT SEPARATES AND INSULATES THE PEDESTRIAN FROM THE CONSTRUCTION SITE AND VEHICULAR TRAFFIC. WHERE POSSIBLE, THE WALKWAY SHALL BE ON THE SAME SIDE OF THE STREET AS THE CONSTRUCTION SITE. WHERE OVERHEAD DANGER EXISTS, THE CONTRACTOR SHALL PROVIDE A COVERED WALKWAY.
43. PRIOR TO CLOSING THE ROAD TO THROUGH TRAFFIC, THE CONTRACTOR SHALL NOTIFY ALL AFFECTED LOCAL AGENCIES ABOUT THE PROPOSED ROAD CLOSURE. THOSE TO BE CONTACTED SHALL INCLUDE, BUT NOT BE LIMITED TO, THE FOLLOWING: FIRE DEPARTMENT, POLICE DEPARTMENT, SHERIFF'S DEPARTMENT, POST OFFICE, CITY TRAFFIC ENGINEER'S OFFICE, AND THE BOARD OF EDUCATION.

DRIVEWAYS

44. WHEN A CONCRETE CURB AND GUTTER IS BUILT, THE CONTRACTOR SHALL INSTALL A DROP CURB FOR EACH LOT AT A LOCATION CHOSEN BY THE ENGINEER. A DOWNTOWN LOT SHALL BE EXEMPT WHEN A BUILDING EXISTS ACROSS THE PROPERTY FRONTAGE OR IS PLANNED TO BE CONSTRUCTED ACROSS THE FRONTAGE.
45. EXISTING, PAVED DRIVEWAYS SHALL BE REPLACED IN KIND TO THE TIE-IN POINT. EACH EXISTING, UNPAVED DRIVEWAY SHALL RECEIVE A FIVE FEET CONCRETE APRON BEHIND, AND ADJACENT TO, THE BACK CURB LINE AND THEN BE REPLACED IN KIND FROM THERE TO THE TIE-IN POINT.



RIGHTS-OF-WAY/EASEMENTS

46. BEFORE CONSTRUCTION BEGINS, THE APPROPRIATE GOVERNMENTAL AGENCY SHALL SECURE ALL RIGHTS-OF-WAY AND EASEMENTS REQUIRED FOR COMPLETION OF THE PROJECT.

MISCELLANEOUS

47. THE ENGINEER SHALL HAVE THE AUTHORITY TO DESIGNATE AND/OR LIMIT AREAS OF CONSTRUCTION.
48. THE OWNER MAKES NO REPRESENTATIONS ABOUT SUBSURFACE CONDITIONS THAT MAY BE ENCOUNTERED WITHIN THE LIMITS OF THE PROJECT. THEREFORE, THE CONTRACTOR SHOULD SATISFY HIMSELF BY ON-SITE INSPECTIONS, CORE DRILLINGS, OR OTHER METHODS, OF THE SUBSURFACE CONDITIONS THAT MAY BE ENCOUNTERED. THE RISK OF ENCOUNTERING AND CORRECTING UNFAVORABLE, SUBSURFACE CONDITIONS SHALL BE BORNE SOLEY BY THE CONTRACTOR.
49. IT SHALL BE THE RESPONSIBILITY OF THE CONTRACTOR TO PROVIDE ALL FIELD LAYOUTS FOR APPROVAL BY THE ENGINEER.
50. SHOULD AN EXISTING BENCH MARK BE LOCATED ON A POWER POLE, TELEPHONE POLE, ETC., THAT IS TO BE RELOCATED DURING CONSTRUCTION, THE BENCH MARK SHALL BE RELOCATED BY A CITY OR COUNTY SURVEY CREW PRIOR TO CONSTRUCTION.
51. ALL SALVAGEABLE MATERIAL FROM EXISTING PIPING AND STRUCTURES SHALL REMAIN PROPERTY OF THE CITY OF CHATTANOOGA OR OF HAMILTON COUNTY. SAID MATERIAL SHALL BE CLEANED AND THEN DELIVERED TO THE OWNER AT A LOCATION DESIGNATED BY THE ENGINEER.
52. ALL UNSUITABLE MATERIAL, AS DETERMINED BY THE ENGINEER OR THROUGH TESTING, IS TO BE REMOVED AND REPLACED WITH SUITABLE MATERIAL.
53. THE CONTRACTOR IS RESPONSIBLE FOR REPAIRING, AT HIS OWN EXPENSE, ANY AND ALL DAMAGES THAT MAY OCCUR OUTSIDE THE LIMITS OF THIS PROJECT AS A RESULT OF CONSTRUCTION.
54. THE CONTRACTOR IS RESPONSIBLE FOR MAINTAINING ALL EXISTING COMBINED CURB AND GUTTERS WHERE APPLICABLE.
55. ALL ABANDONED STRUCTURES (E.G., CATCH BASINS, MANHOLES, FOUNDATIONS, ETC.), UTILITY FACILITIES, AND SIMILAR ITEMS WITHIN THE LIMITS OF PAVING SHALL BE REMOVED TO A MINIMUM OF TWO FEET BELOW THE TOP OF SUBGRADE, AND REMAINING VOIDS SHALL BE FILLED WITH COMPACTED, CRUSHED STONE TO THE TOP OF SUBGRADE.
56. THE CONTRACTOR SHALL NOT BE ALLOWED TO REMOVE ANY FENCE OTHER THAN THAT NECESSARY FOR THE CONSTRUCTION OF THE PROJECT OR RELATED APPURTENANCES. ANY FENCE REMOVED IS TO BE REPLACED IN KIND BY THE CONTRACTOR. TEMPORARY FENCING MAY BE REQUIRED.
57. THE CONTRACTOR SHALL GIVE THE AFFECTED PROPERTY OWNERS ONE WEEK'S NOTICE PRIOR TO CUTTING FENCES.
58. THE CONTRACTOR SHALL PROVIDE RECORD DRAWINGS OF THE PROJECT WITHIN THIRTY (30) DAYS AFTER SUBSTANTIAL COMPLETION OF THE WORK. ("SUBSTANTIAL COMPLETION" SHALL BE DEFINED BY THE JURISDICTIONAL ENGINEER.) THE ENGINEER RESERVES THE RIGHT TO WITHOLD THE RETAINER UNTIL RECEIVING A COMPLETE SET OF SAID DRAWINGS.
59. SHOULD THERE BE A CONFLICT BETWEEN THESE GENERAL NOTES, CONTRACT DRAWINGS, AND/OR SPECIFICATIONS, THE MOST RESTRICTIVE INTERPRETATION SHALL PREVAIL. THE CONTRACTOR SHALL BE RESPONSIBLE FOR OBTAINING FROM THE ENGINEER ANY CLARIFICATION OR INTERPRETATION OF GENERAL NOTES, CONTRACT DRAWINGS AND/OR SPECIFICATIONS IN WRITING AND IN ADVANCE OF THE BEGINNING OF CONSTRUCTION.
60. ALL CONCRETE SHALL BE CLASS "A" (4,000 P.S.I.) UNLESS OTHERWISE NOTED ON A DRAWING. (CLASS "B" CONCRETE SHALL BE 3,000 P.S.I.)

F:\STDDWGS\General Standard Notes\GENERAL Standard Notes_2.dwg

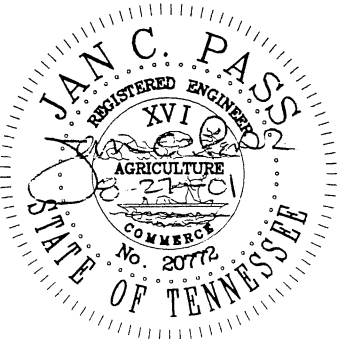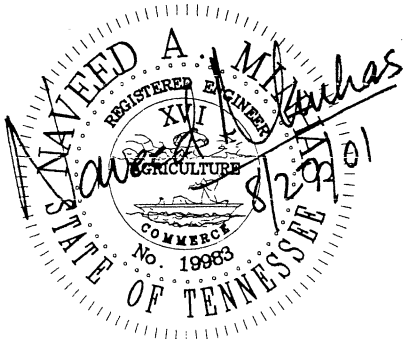

1	REVISIONS AS MARKED OR CLOUDED	8/24/01
0	INITIAL ISSUE	12/10/99
NO.	REVISION	DATE

CITY OF CHATTANOOGA AND HAMILTON COUNTY
GENERAL NOTES

DATE OF ORIGINAL ISSUE
DECEMBER 10, 1999

STANDARD NUMBER : SD-100.02

UTILITY OWNERS

△ BELLSOUTH (TELEPHONE)
300 EAST M.L. KING BOULEVARD
CHATTANOOGA, TN 37403
PHONE: (423)752-4339

△ TENNESSEE-AMERICAN WATER CO.
1101 BROAD STREET
P.O. BOX 6338
CHATTANOOGA, TN 37402
PHONE: (423)755-7654

CHATTANOOGA GAS COMPANY
6125 PRESERVATION DRIVE
CHATTANOOGA, TN 37416
PHONE: (423)490-4289

△ ELECTRIC POWER BOARD
ENGINEERING DIVISION
P.O. BOX 182255
CHATTANOOGA, TN 37422-7255
PHONE: (423)629-3495

EASTSIDE UTILITY DISTRICT
P.O. BOX 22037
CHATTANOOGA, TN 37422-2307
PHONE: (423)892-2890

VOLUNTEER ELECTRIC COOPERATIVE
9931 HIGHWAY 58 NORTH
GEORGETOWN, TN 37336
PHONE: (423)344-8382

COMCAST CABLE TELEVISION CO.
2030 EAST POLYMER DRIVE
CHATTANOOGA, TN 37422
PHONE: (423)855-3900
PHONE: (423)855-4300

△ HIXSON UTILITY DISTRICT
5201 HIXSON PIKE
HIXSON, TN 37343
PHONE: (423)877-3513

CITY OF CHATTANOOGA
DEPARTMENT OF PUBLIC
WORKS
ENGINEERING DIVISION
STORMWATER SECTION
1001 LINDSAY STREET
CHATTANOOGA, TN 37402
PHONE: (423)757-5120

CITY OF CHATTANOOGA
TRAFFIC ENGINEERING
ADMINISTRATION
SUITE 32, CITY HALL
CHATTANOOGA, TN 37402
PHONE: (423)757-5005

△ CITY OF CHATTANOOGA
WASTE RESOURCES DIVISION
455 MOCCASIN BEND ROAD
CHATTANOOGA, TN 37405
PHONE: (423)757-5026

CENTURY TELEPHONE OF
OOLTEWAH-COLLEGEDALE, INC.
5616 MAIN STREET
OOLTEWAH, TN 37363
PHONE: (423)238-6872

△ HAMILTON COUNTY WATER AND
WASTEWATER TREATMENT AUTHORITY
117 EAST 7TH STREET
300 NEWELL TOWER
CHATTANOOGA, TN 37402
PHONE: (423)209-6410

MIDDLE TENNESSEE NATURAL GAS
951 MARKET STREET
DAYTON, TN 37321
PHONE: (423)775-2422

△ MOWBRAY MOUNTAIN UTILITY DISTRICT
(OFFICE CLOSED-REFER ALL CALLS
TO SODDY-DAISY FALLING WATER
UTILITY DISTRICT.)
PHONE: (423)332-2809

SALE CREEK UTILITY DISTRICT
2141 HILLTOP CREST DRIVE
SODDY DAISY, TN 37373
PHONE: (423)332-2921

SAVANNAH VALLEY UTILITY DISTRICT
10700 HIGHWAY 58
GEORGETOWN, TN 37336
PHONE: (423)344-8440

△ SIGNAL MOUNTAIN WATER
UTILITY DISTRICT
SIGNAL MOUNTAIN TOWN HALL
1111 RIDGEWAY AVENUE
SIGNAL MOUNTAIN, TN 37377
PHONE: (423)886-2177

SODDY-DAISY FALLING WATER
UTILITY DISTRICT
9864 DAYTON PIKE
SODDY DAISY, TN 37379
PHONE: (423)332-2427

△ UNION FORK-BAKEWELL
UTILITY DISTRICT
405 RETRO HUGHES ROAD, BOX 17
BAKEWELL, TN 37304
PHONE: (423)332-9733

WALDEN'S RIDGE UTILITY DISTRICT
3900 TAFT HIGHWAY
SIGNAL MOUNTAIN, TN 37377
PHONE: (423)886-2683




BEFORE YOU DIG, DRILL, OR BLAST
CALL TOLL FREE 1-800-351-1111
FOR LOCATING UNDERGROUND UTILITY LINES.
- IT'S THE LAW. -
TENNESSEE ONE-CALL SYSTEM, INC.

F:\STDDWGS\General Standard Notes\UTILITYOWNERS.dwg

CITY OF CHATTANOOGA AND HAMILTON COUNTY			
UTILITY OWNERS			
1	REVISIONS AS MARKED OR CLOUDED	8/24/01	DATE OF ORIGINAL ISSUE
0	INITIAL ISSUE	12/10/99	DECEMBER 10, 1999
NO.	REVISION	DATE	STANDARD NUMBER : SD-101.01


HIGHWAYS, ROADS, AND STREETS

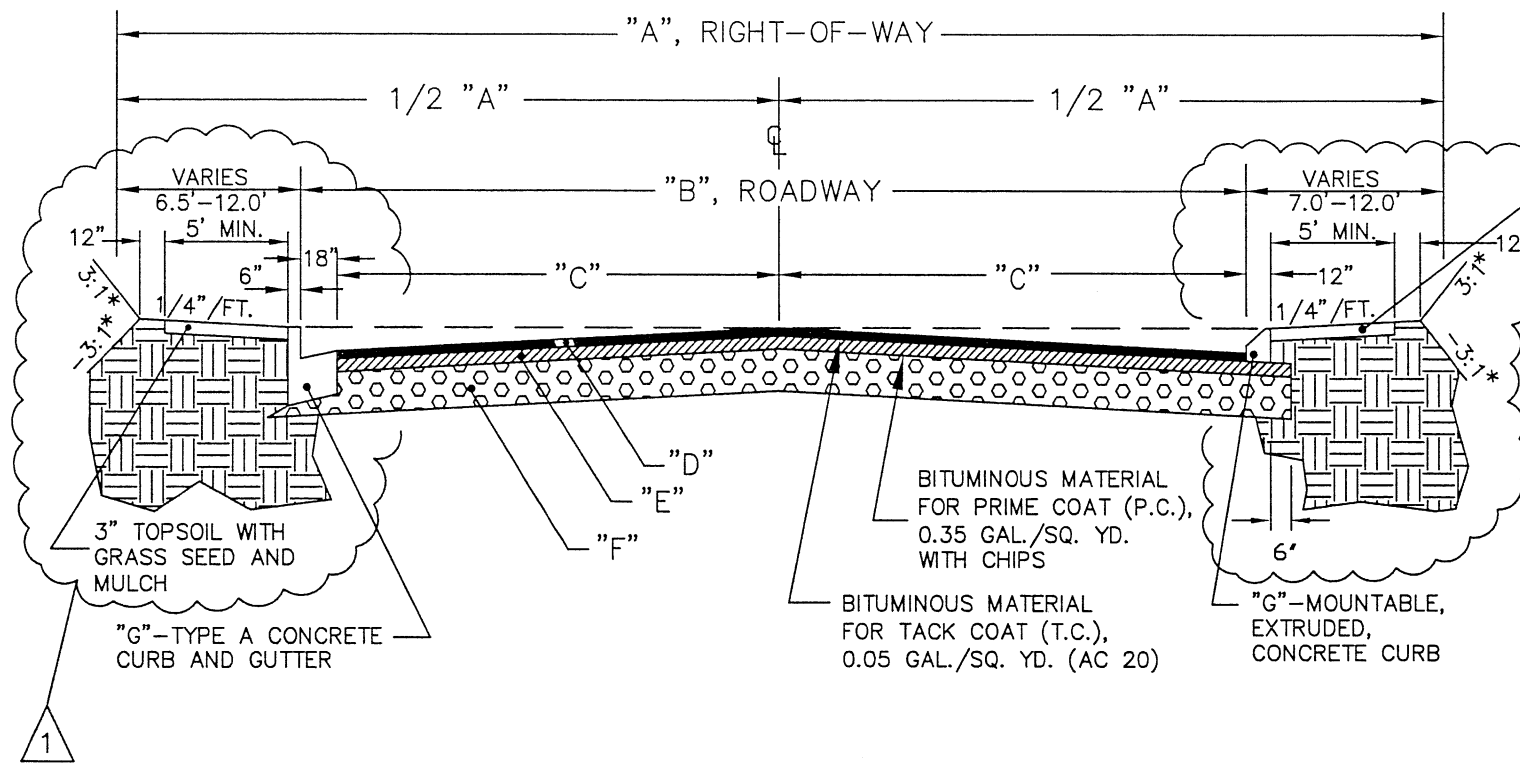

NOTES

1. TYPE A CONCRETE CURB AND GUTTER OR MOUNTABLE, EXTRUDED, CONCRETE CURB ON EACH SIDE AS REQUIRED BY SITE-SPECIFIC DRAWINGS.
2. CROWN AND TOP OF CURB SHALL BE AT THE SAME ELEVATION (AS SHOWN ABOVE).
3. FOR SUB-DIVISION PROJECTS, REFER TO DETAILS IN THE CURRENT HAMILTON COUNTY OR CITY OF CHATTANOOGA SUB-DIVISION REGULATIONS.



LOCAL STREETS (RIGHTS-OF-WAY OF 50' OR LESS)

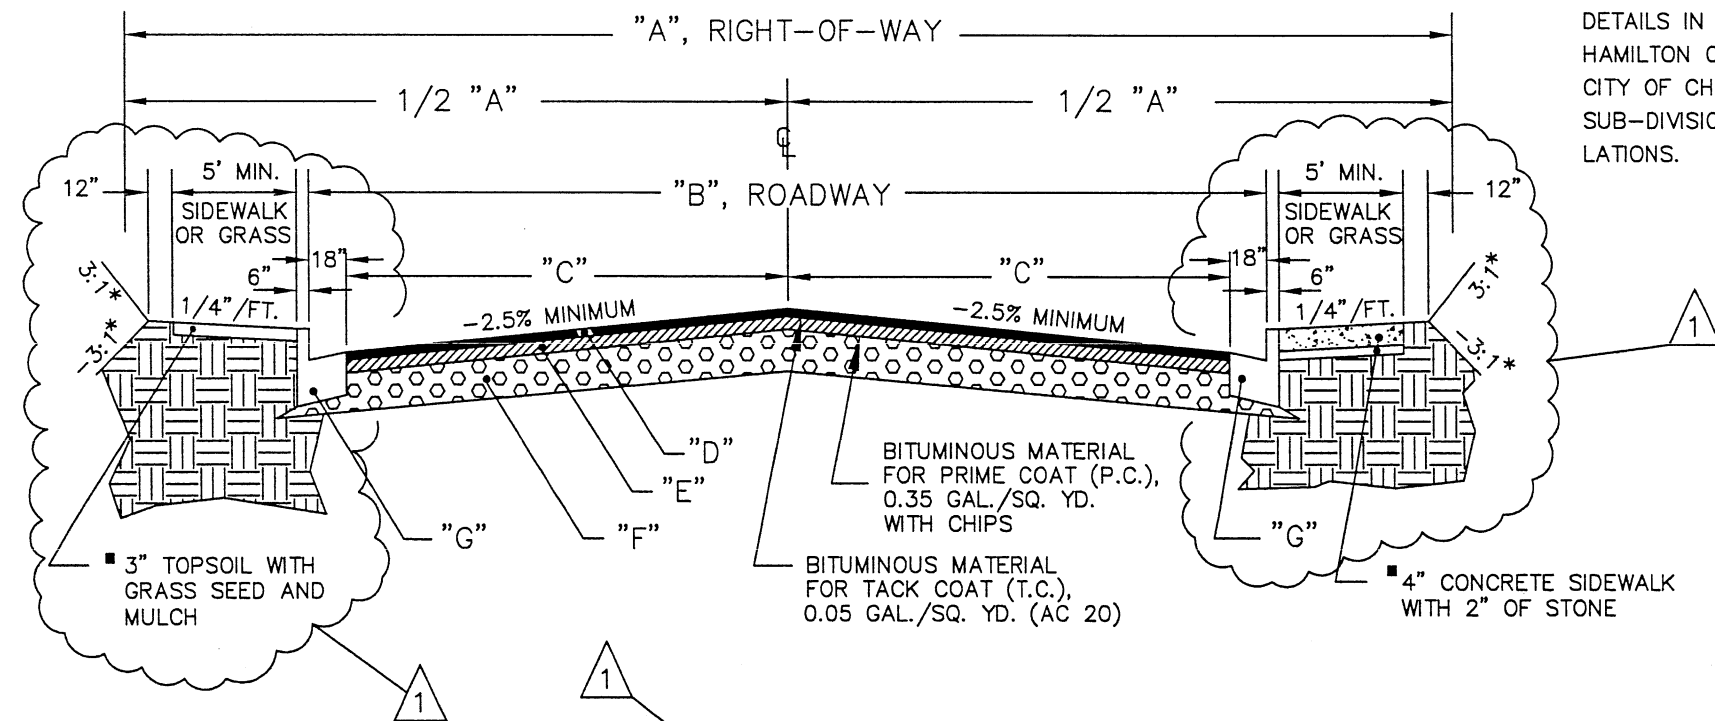

ARTERIAL AND COLLECTOR STREETS (RIGHTS-OF-WAY GREATER THAN 50')

* ALL CUT AND FILL SLOPES SHALL HAVE A MINIMUM OF 3" OF TOP SOIL WITH SEED AND MULCH.

■ SIDEWALK OR GRASS STRIP ON EACH SIDE AS REQUIRED BY SITE-SPECIFIC DRAWINGS.

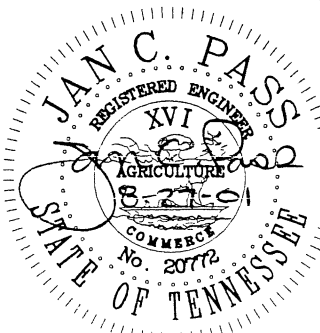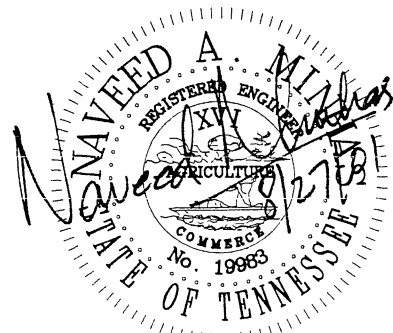

CITY OF CHATTANOOGA AND HAMILTON COUNTY ROADWAY SECTIONS


NO.	REVISION	DATE
1	REVISIONS AS MARKED OR CLOUDED	8/24/01
0	INITIAL ISSUE	12/10/99

DATE OF ORIGINAL ISSUE
DECEMBER 10, 1999

STANDARD NUMBER: **SD-200.01**


F:\STDWGS\TypSection\typ-sec_2.dwg

DIMENSIONS FOR ROADWAY SECTIONS							
ROADWAY CLASSIFICATION	"A" RIGHT-OF-WAY	"B" ROADWAY WIDTH	"C" 1/2 PAVED SECTION	"D" ASPHALTIC CONCRETE SURFACE	"E" ASPHALTIC CONCRETE BINDER	"F" MINERAL AGGREGATE BASE	"G" CONCRETE CURB/ CURB AND GUTTER
				GRADING E (SEE NOTE 1 BELOW.)	GRADING B, C, OR B MODIFIED (SEE NOTE 2 BELOW.)	TYPE A (SEE NOTE 3 BELOW.)	
PRINCIPAL ARTERIAL	100'	84'	40'-6"	1.5"	3.5"	15"	TYPE A
MINOR ARTERIAL	80'	60'	28'-6"	1.5"	3.5"	15"	TYPE A
COLLECTOR STREET	60'	36'	16'-6"	1.5"	2.5"	8"	TYPE A
LOCAL STREET	50'	26'	11'-6"	1.5"	2.5"	8"	SEE NOTE 1 WITH TYPICAL SECTION.
<div><div>1</div><div>1. ASPHALTIC CONCRETE SURFACE SHALL BE GRADING E, CITY OF CHATTANOOGA SPECIFICATIONS, CONTAINING AT LEAST 45% RIVER SAND. 2. ASPHALTIC CONCRETE BINDER SHALL BE GRADING B MODIFIED OR GRADING C, CITY OF CHATTANOOGA SPECIFICATIONS; OR GRADING B, TENNESSEE D.O.T. SPECIFICATIONS. 3. MINERAL AGGREGATE BASE SHALL BE COMPACTED 303-01, TYPE A, GRADING D ("33-P"), TENNESSEE D.O.T. SPECIFICATIONS.</div></div>							

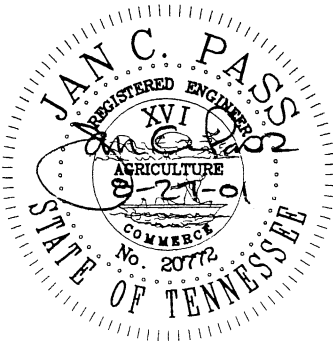


CITY OF CHATTANOOGA AND HAMILTON COUNTY			
ROADWAY SECTIONS			
1	REVISIONS AS MARKED OR CLOUDED	8/24/01	DATE OF ORIGINAL ISSUE
0	INITIAL ISSUE	12/10/99	DECEMBER 10, 1999
NO.	REVISION	DATE	STANDARD NUMBER: SD-200.02

F:\STDDWGS\Detached_Expansion\detached.dwg

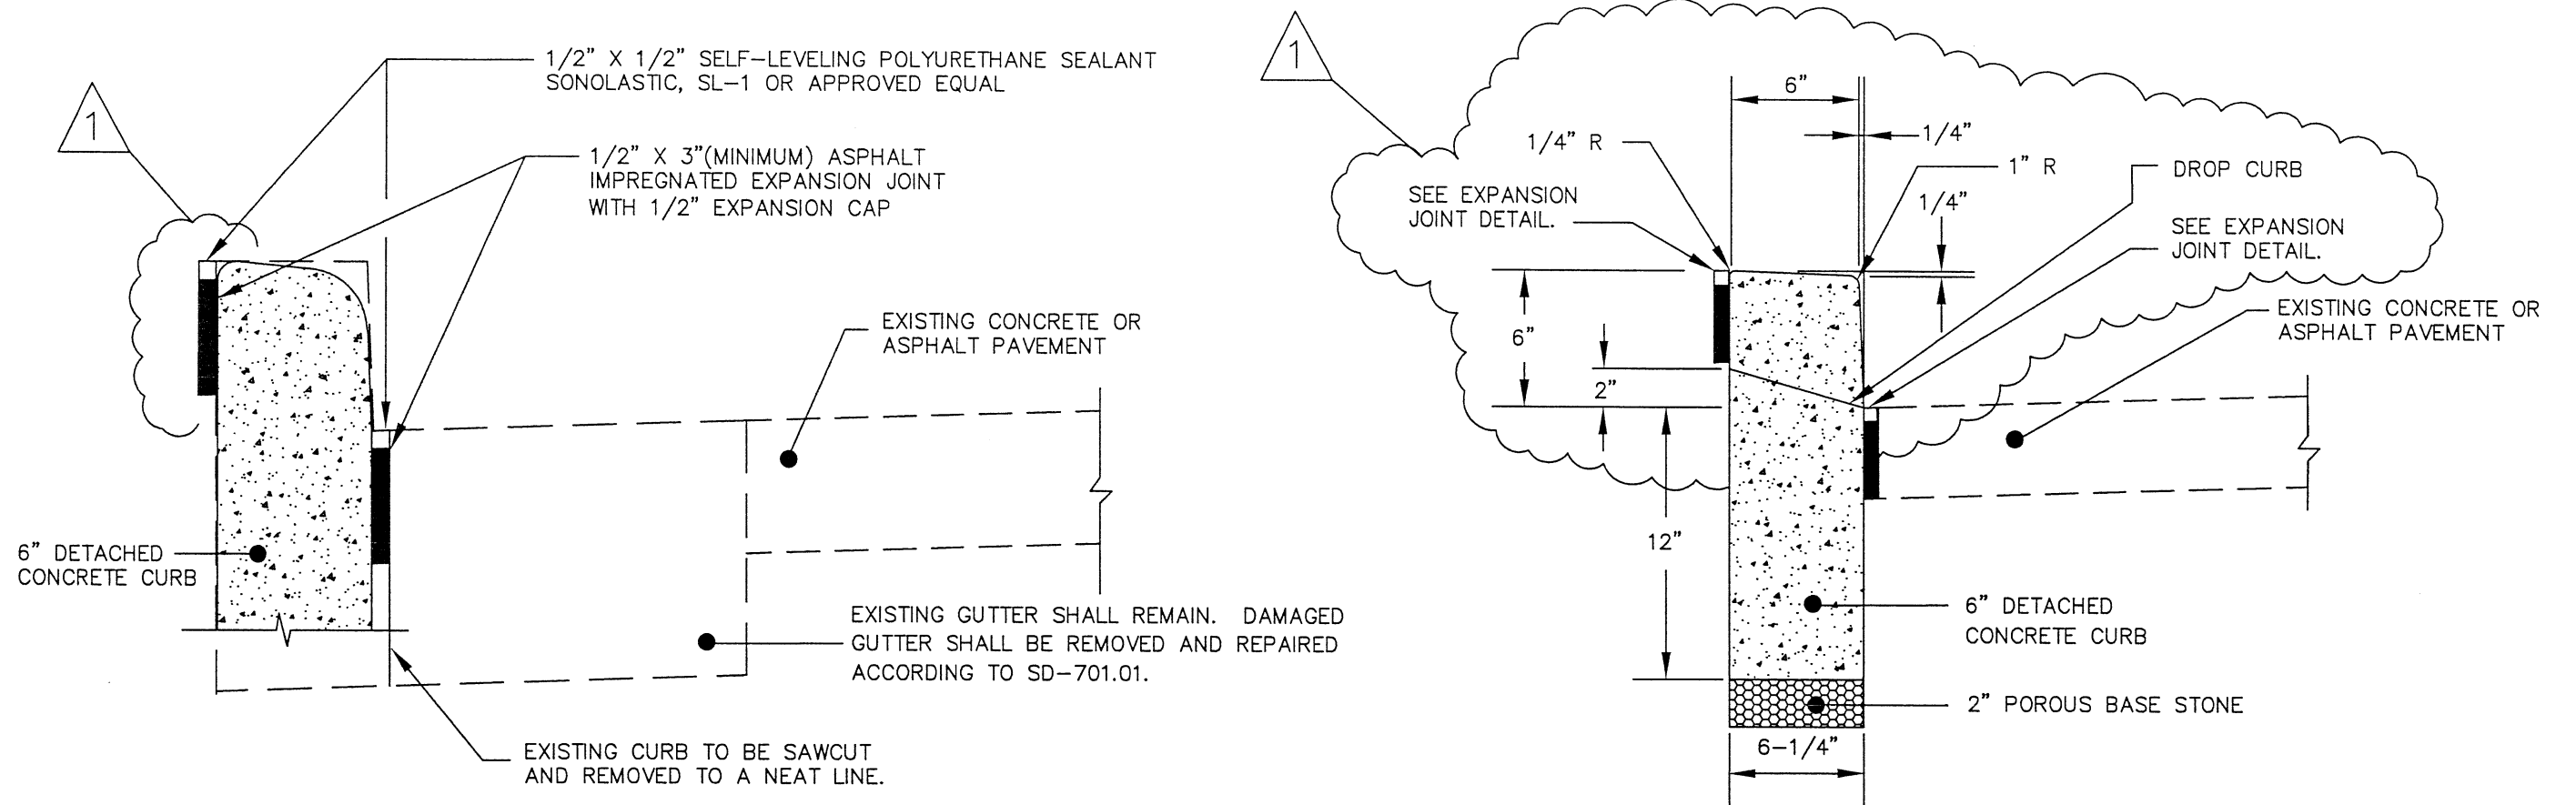



EXPANSION JOINT DETAIL

6" DETACHED CONCRETE CURB

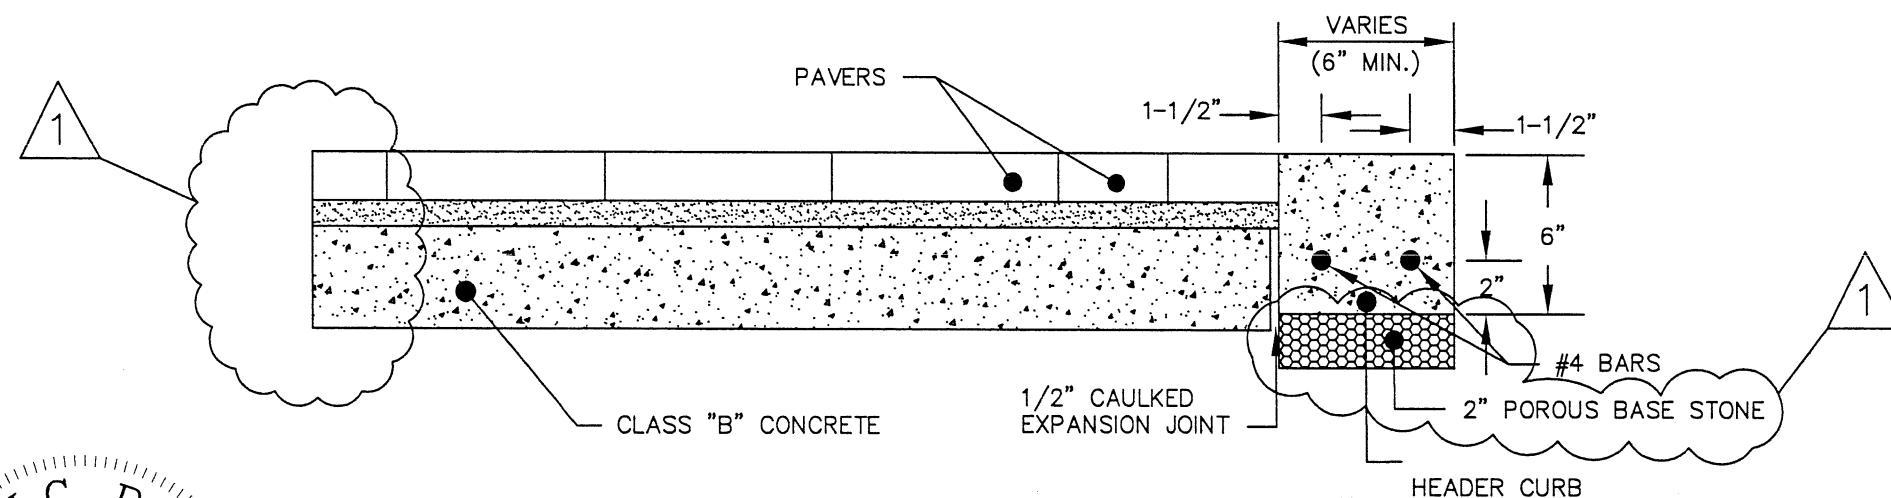


CONCRETE HEADER CURB*

* FOR USE IN SIDEWALK AREAS ONLY

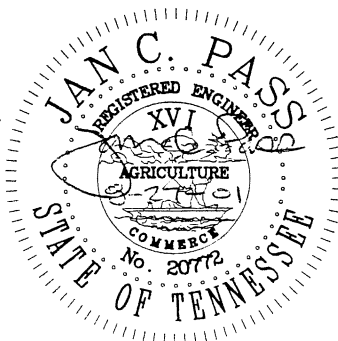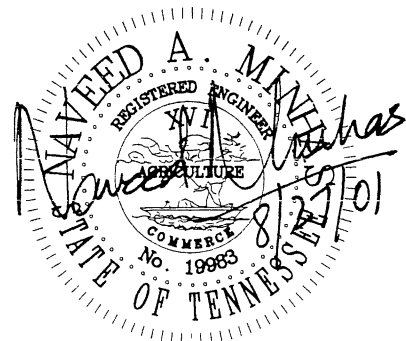


CITY OF CHATTANOOGA AND HAMILTON COUNTY			
CONCRETE CURBS (6" DETACHED AND HEADER)			
1	REVISIONS AS MARKED OR CLOUDED	8/24/01	DATE OF ORIGINAL ISSUE
0	INITIAL ISSUE	12/10/99	DECEMBER 10, 1999
NO.	REVISION	DATE	STANDARD NUMBER: SD-201.01

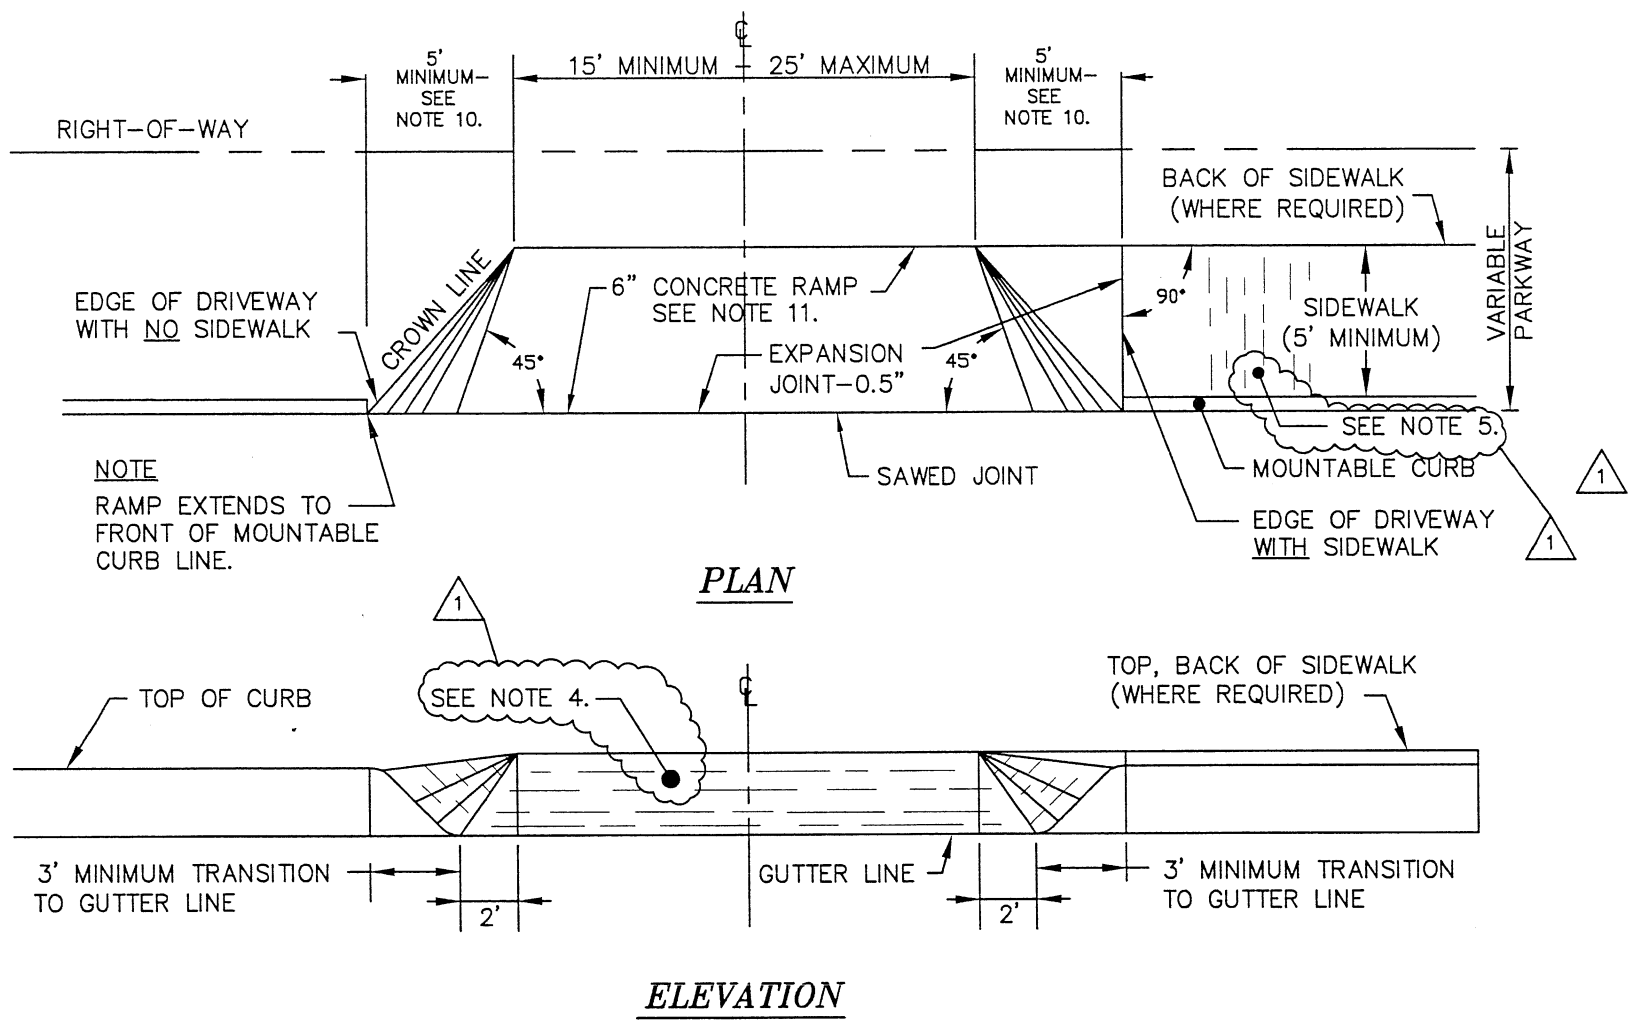

NOTES

1. DETAILS SHOWN ON THIS SHEET APPLY TO ALL CONSTRUCTION OR RECONSTRUCTION OF STREETS, CURBS, AND/OR SIDEWALKS.
2. CURB CUT RAMP SHALL BE LOCATED AS SHOWN ON THE PLANS.
3. HANDICAP RAMP SHALL BE PROVIDED AT ALL CORNERS OF STREET INTERSECTIONS WHERE THERE ARE EXISTING OR PROPOSED SIDEWALKS. CURB CUT RAMP SHALL ALSO BE PROVIDED AT CROSSWALK LOCATIONS IN MID-BLOCK. (SEE SD-205.01 AND SD-205.02.)
4. THE SURFACE TEXTURE OF THE RAMP SHALL BE THAT OBTAINED BY A TRANSVERSE, COARSE BROOMING OF THE ENTIRE SLOPE OF THE RAMP. (SEE ELEVATION.)
5. THE SURFACE TEXTURE OF THE SIDEWALK SHALL BE THAT OBTAINED BY A TRANSVERSE, COARSE BROOMING ALONG ITS ENTIRE LENGTH. (SEE PLAN.)
6. CARE SHALL BE TAKEN TO ASSURE A UNIFORM GRADE ON THE RAMP, FREE OF SAGS AND SHORT GRADE CHANGES.
7. DRAINAGE STRUCTURES SHALL NOT BE PLACED IN LINE WITH RAMP.
8. THE NORMAL GUTTER LINE PROFILE SHALL BE MAINTAINED THROUGH THE AREA OF THE RAMP.
9. CROSSWALK AND STOPLINE MARKINGS, IF USED, SHALL BE LOCATED SO THAT TRAFFIC STOPS SHORT OF RAMP CROSSINGS.
10. DIMENSIONS SHOWN ARE TO BE USED UNLESS OTHERWISE DIRECTED BY THE ENGINEER.
11. GREATER OF FIVE FEET (5') OR WIDTH OF SIDEWALK. (SEE PLAN AT TOP, LEFT.)
12. REINFORCEMENT: #4 BARS (MINIMUM) TWELVE INCHES (12") ON CENTER EACH WAY. (SEE PLAN AT TOP, LEFT.)

RESIDENTIAL, MOUNTABLE, EXTRUDED CONCRETE CURB DESIGN WITH CONCRETE RAMP APPROACH

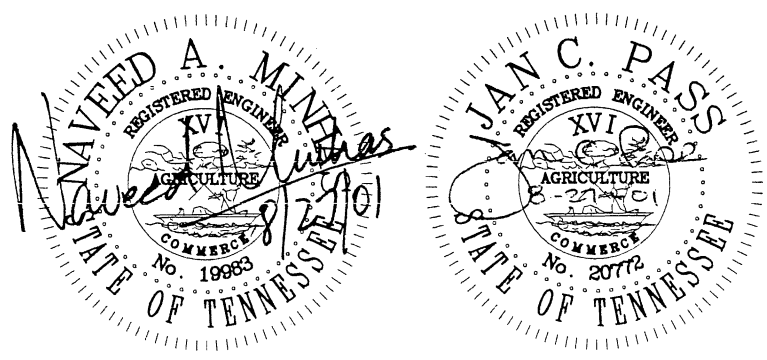


1	REVISIONS AS MARKED OR CLOUDED	8/24/01
0	INITIAL ISSUE	12/10/99
NO.	REVISION	DATE

CITY OF CHATTANOOGA AND HAMILTON COUNTY
CONCRETE CURB (RESIDENTIAL)


DATE OF ORIGINAL ISSUE
DECEMBER 10, 1999

STANDARD NUMBER: **SD-203.01**

F:\STDOWGS\curo and gutter2\CRRGTR2_2.dwg Wed Dec 08 15:19:20 1999 5.4.10NS 24

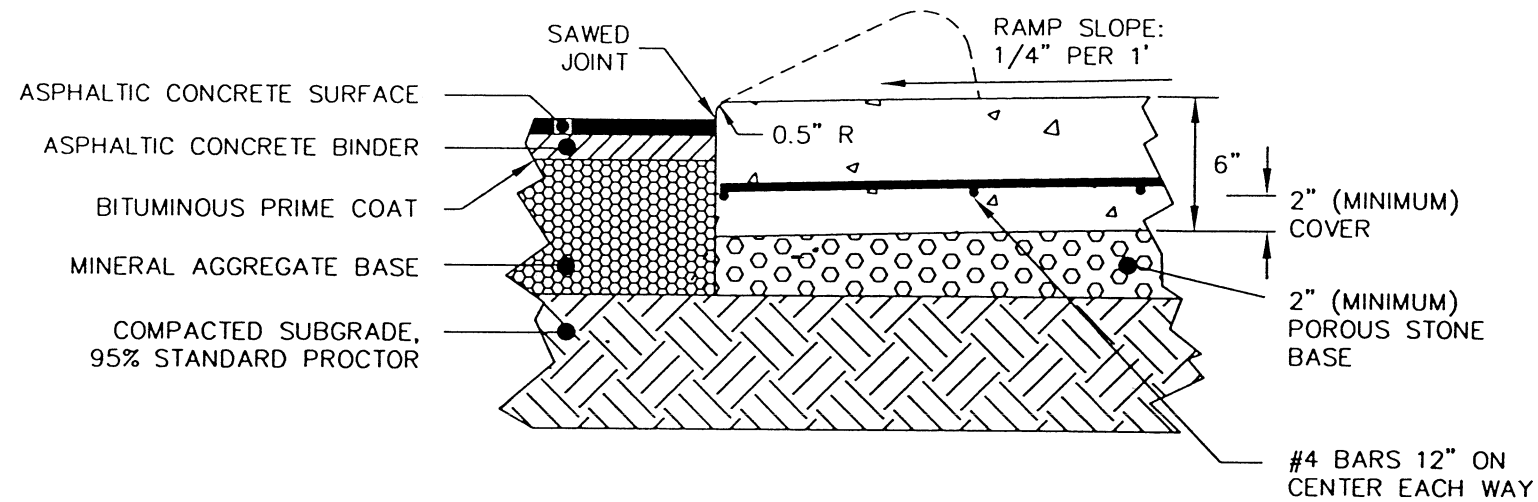

**RESIDENTIAL, MOUNTABLE,
CONCRETE RAMP DETAIL**

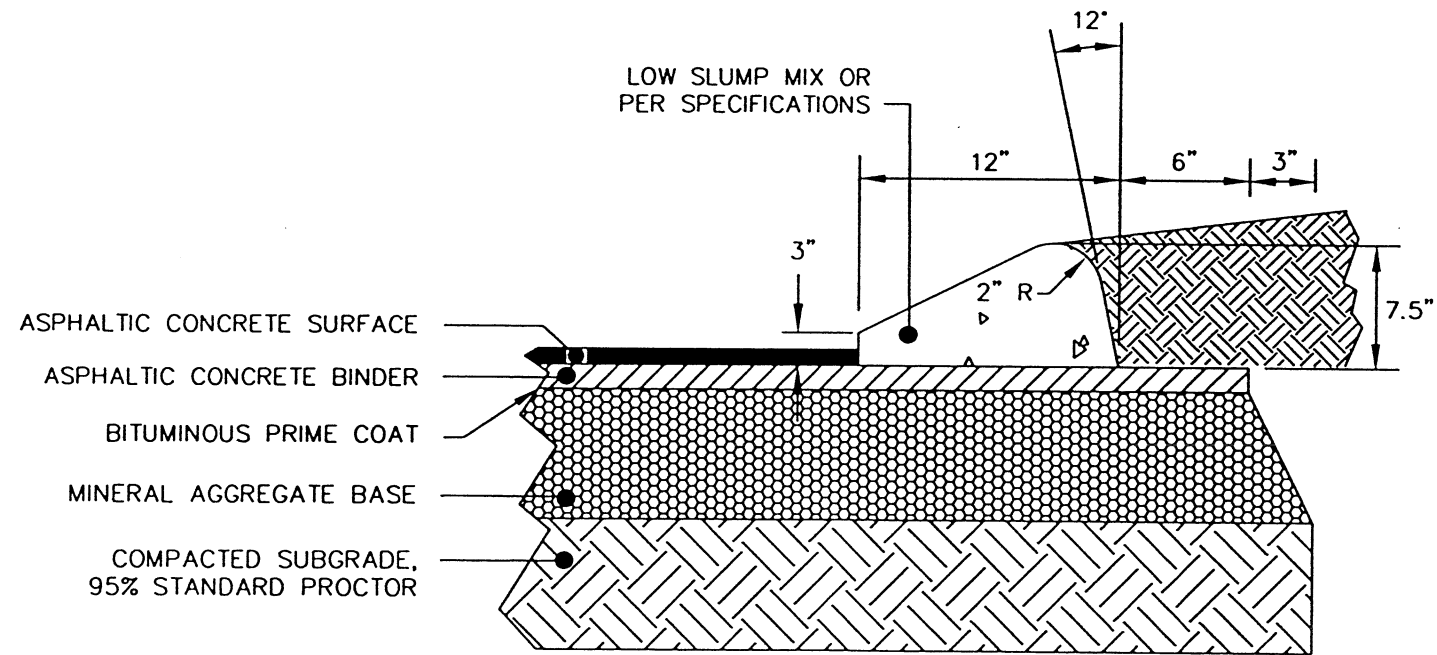


* NOTE
SEE NOTES ON STANDARD SD-203.01.


**RESIDENTIAL, MOUNTABLE, EXTRUDED
CONCRETE CURB DETAIL**

CITY OF CHATTANOOGA AND HAMILTON COUNTY
CONCRETE CURB (RESIDENTIAL)




0	INITIAL ISSUE	12/10/99	DATE OF ORIGINAL ISSUE	STANDARD NUMBER :	SD-203.02
NO.	REVISION	DATE	DECEMBER 10, 1999		

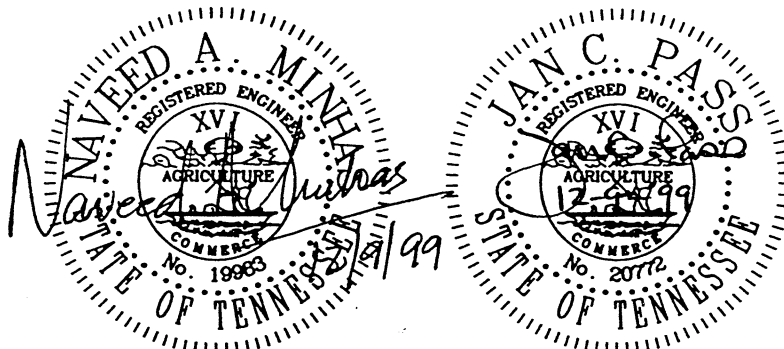

DRIVEWAY APPROACH ANGLES	DRIVE WIDTHS AT EXITS
LEFT OR RIGHT	WIDTH X DEPTH
90°	24' X 20' MIN.
60°-89°	26' X 20' MIN.
0°-59°	30' X 20' MIN.

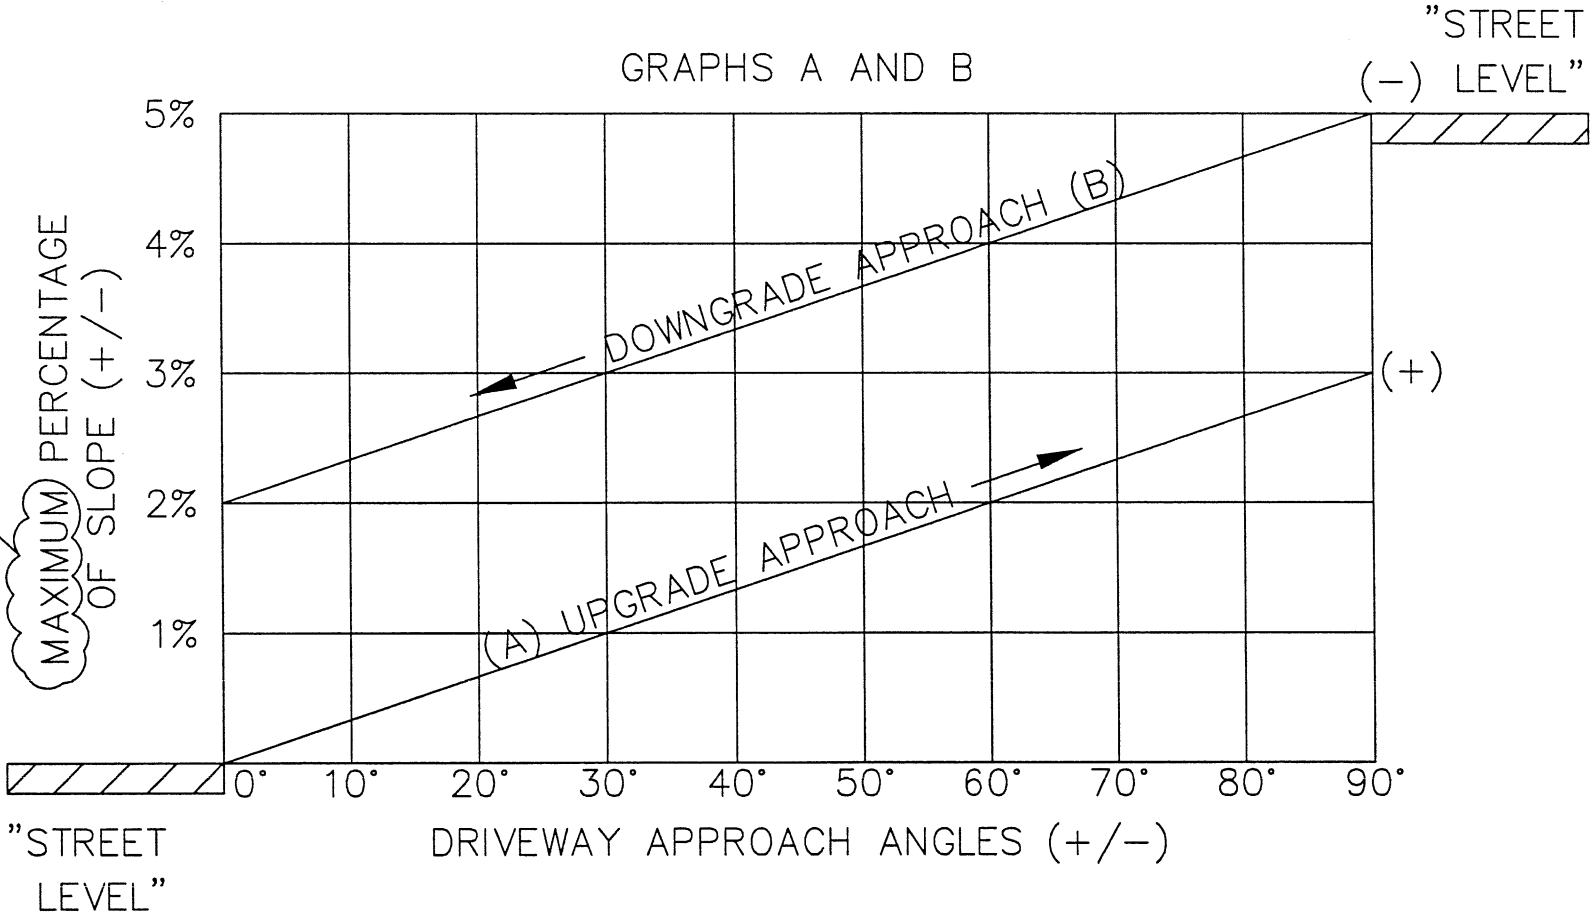


NOTE
THE INITIAL DRIVEWAY SHALL HAVE A DRIVEWAY TILE INSTALLED BY THE OWNER. SIZE AND LOCATION OF THE TILE MUST FIRST BE APPROVED BY THE STORMWATER MANAGEMENT SECTION.

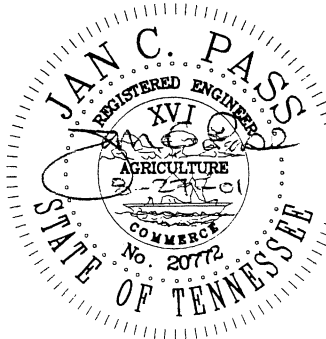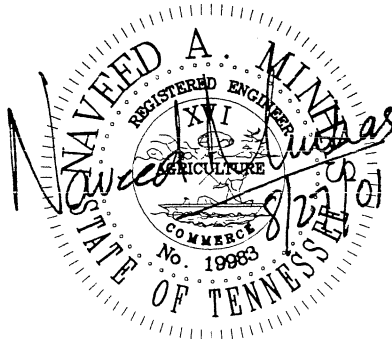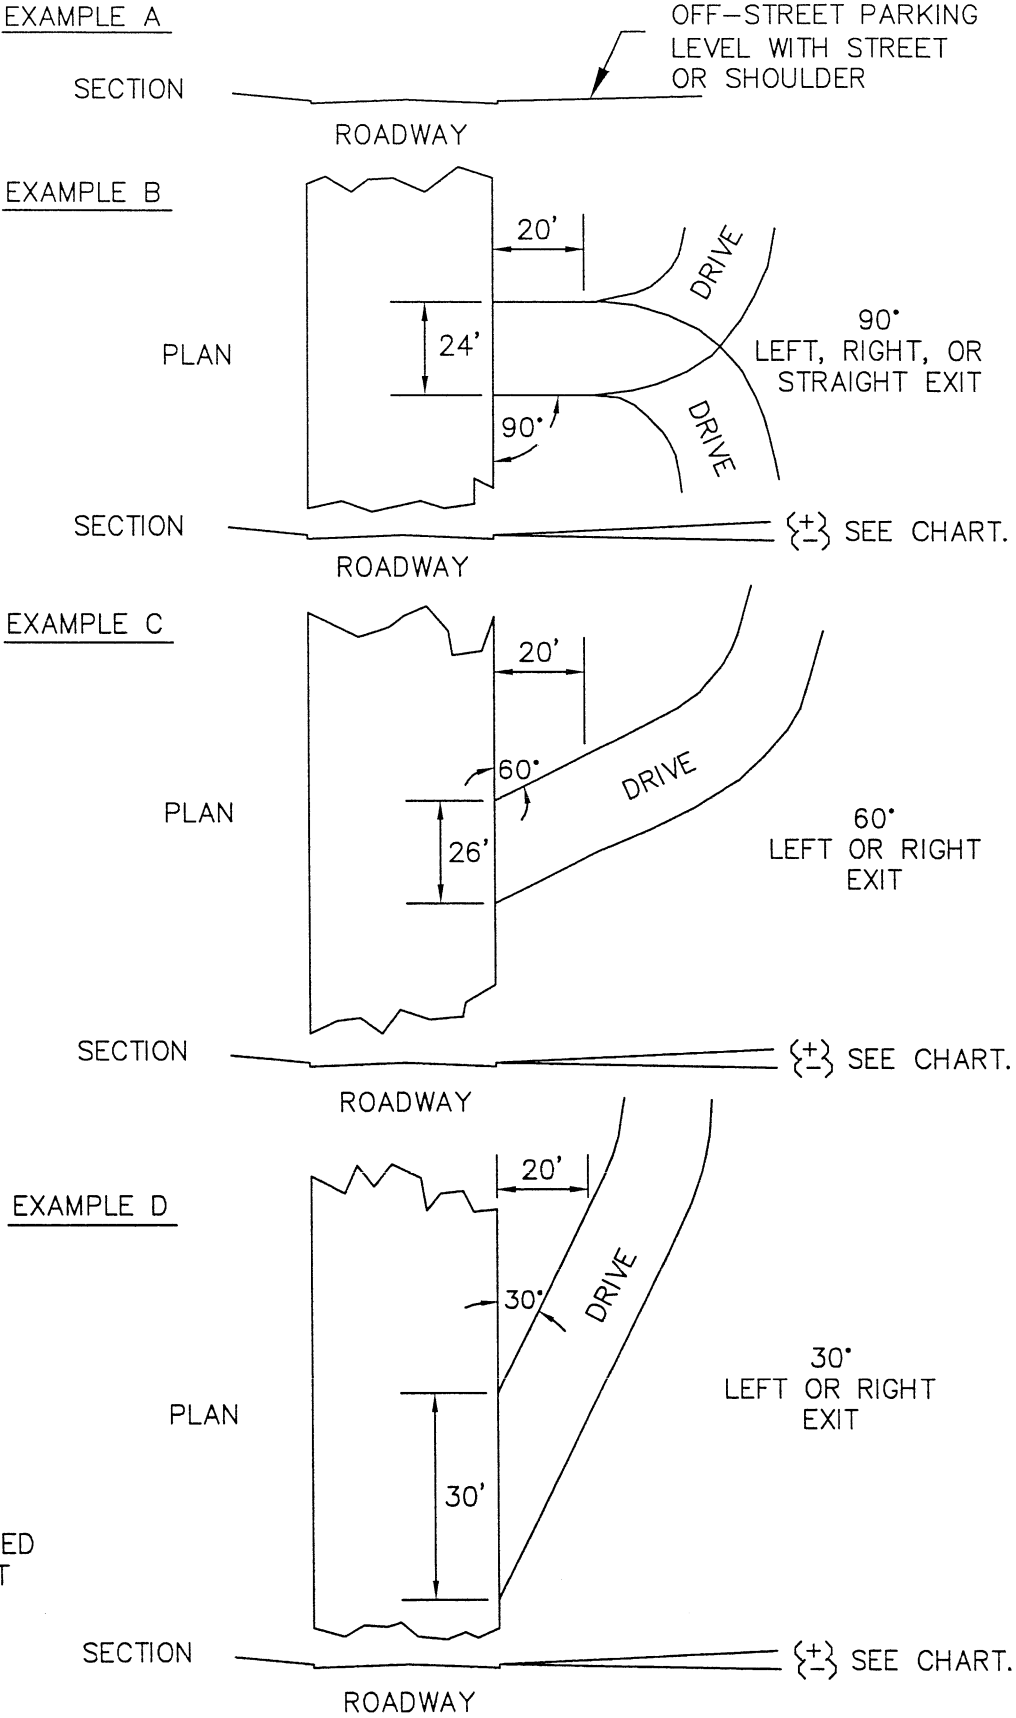

1	REVISIONS AS MARKED OR CLOUDED	8/24/01
0	INITIAL ISSUE	12/10/99
NO.	REVISION	DATE


CITY OF CHATTANOOGA AND HAMILTON COUNTY	
PRIVATE DRIVEWAY APPROACH (RESIDENTIAL)	
DATE OF ORIGINAL ISSUE DECEMBER 10, 1999	STANDARD NUMBER: SD-204.01

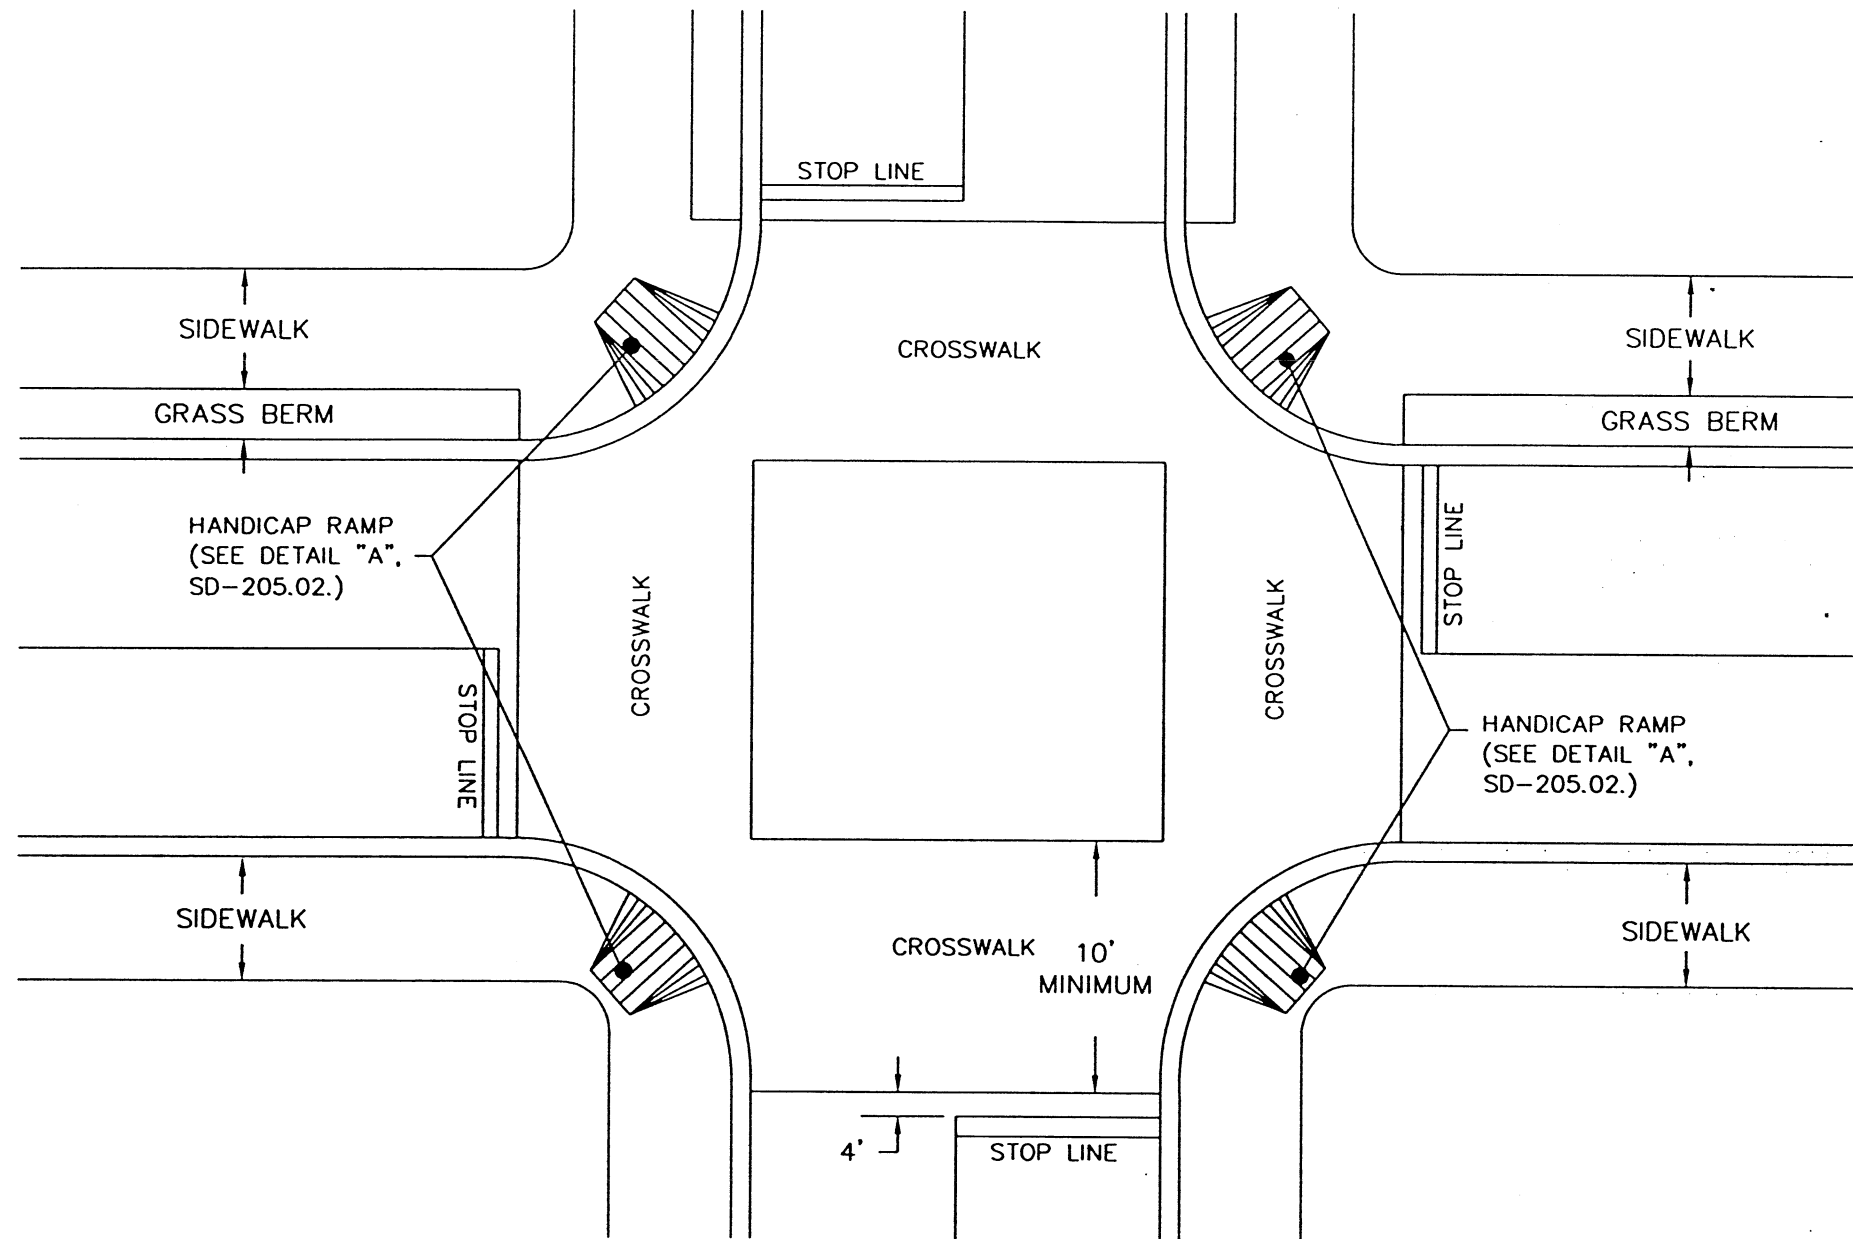






PLAN

NOTES

1. DETAILS SHOWN ON THIS PLAN APPLY TO ALL CONSTRUCTION OR RECONSTRUCTION OF STREETS, CURBS, AND/OR SIDEWALKS.
2. CURB CUT RAMPS SHALL BE LOCATED AS SHOWN ON THE PLANS.
3. HANDICAP RAMPS SHALL BE PROVIDED AT ALL CORNERS OF STREET INTERSECTIONS WHERE THERE ARE EXISTING OR PROPOSED SIDEWALKS. CURB CUT RAMPS SHALL ALSO BE PROVIDED AT CROSSWALK LOCATIONS IN MID-BLOCK.
4. THE SURFACE TEXTURE OF THE RAMP SHALL BE THAT OBTAINED BY A COARSE, TRANSVERSE, BROOMING OF THE SLOPE OF THE RAMP.
5. CARE SHALL BE TAKEN TO ASSURE A UNIFORM GRADE ON THE RAMP, FREE OF SAGS AND SHORT GRADE CHANGES.
6. DRAINAGE STRUCTURES SHALL NOT BE PLACED IN LINE WITH RAMPS.
7. THE NORMAL GUTTER LINE PROFILE SHALL BE MAINTAINED THROUGH THE AREA OF THE RAMP.
8. CROSSWALK AND STOPLINE MARKINGS, IF USED, SHALL BE LOCATED SO THAT TRAFFIC STOPS SHORT OF RAMP CROSSINGS.
9. DESIRABLE DIMENSIONS SHALL BE USED UNLESS OTHERWISE DIRECTED BY THE ENGINEER.

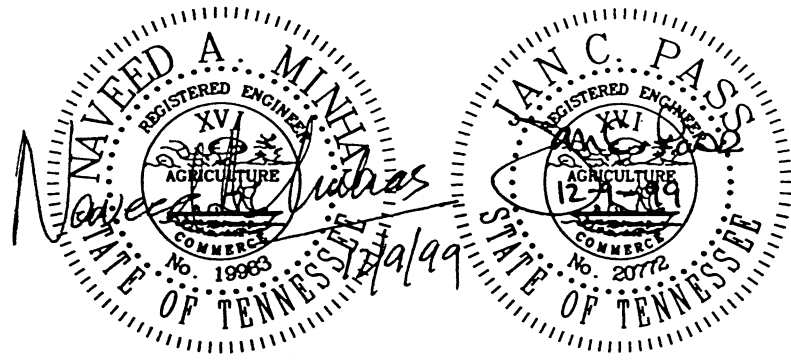

CITY OF CHATTANOOGA AND HAMILTON COUNTY			
HANDICAP RAMP DETAILS			
DATE OF ORIGINAL ISSUE		STANDARD NUMBER: SD-205.01	
0	INITIAL ISSUE	12/10/99	DECEMBER 10, 1999
NO.	REVISION	DATE	

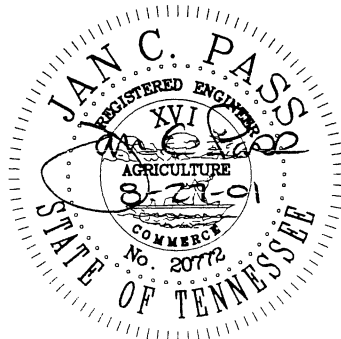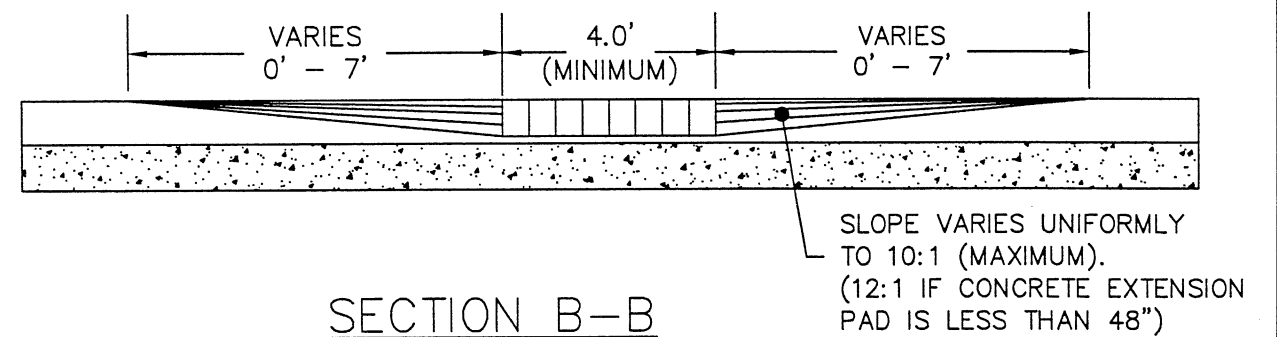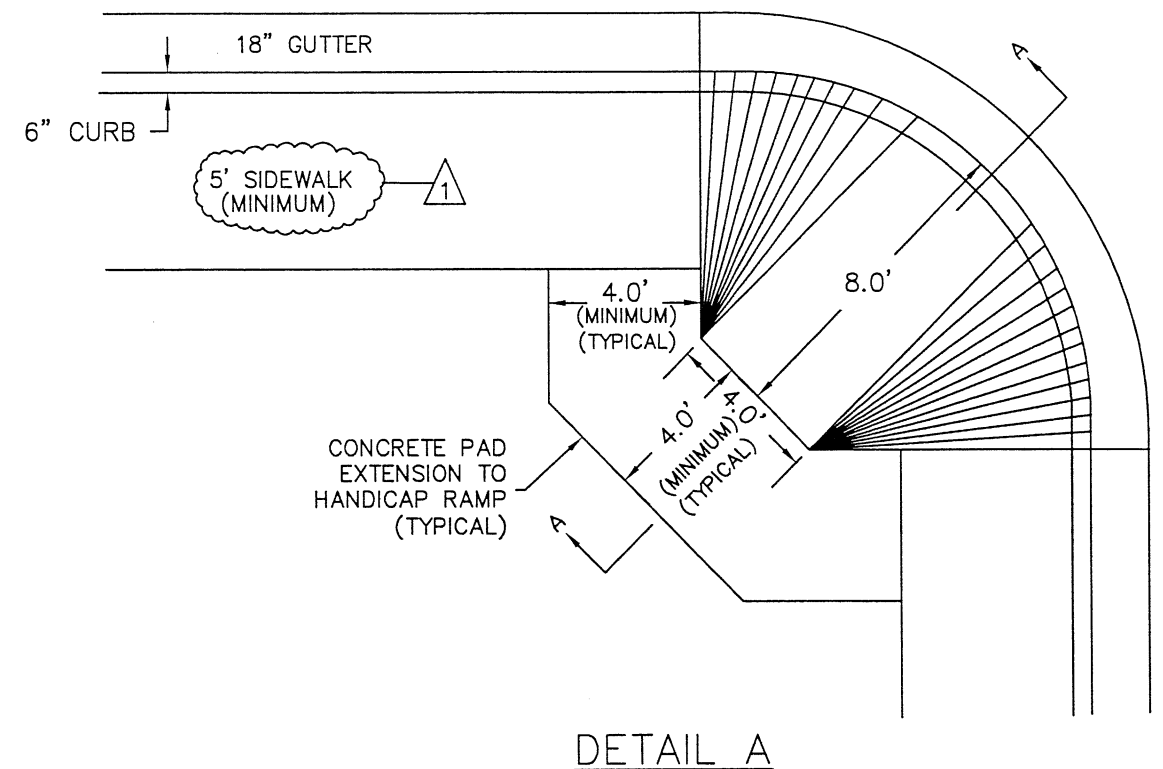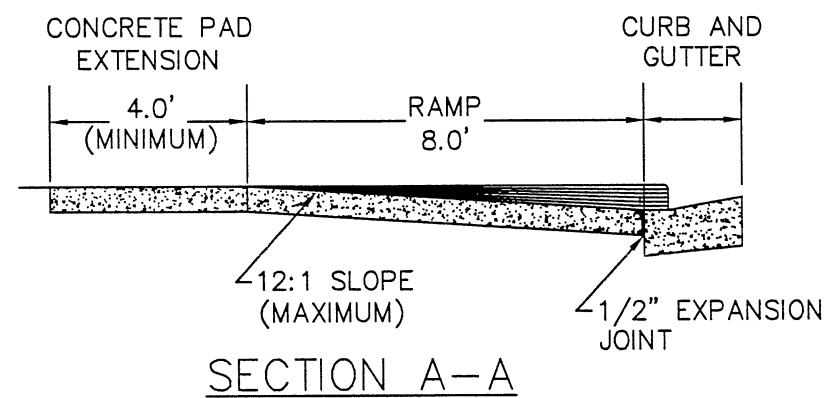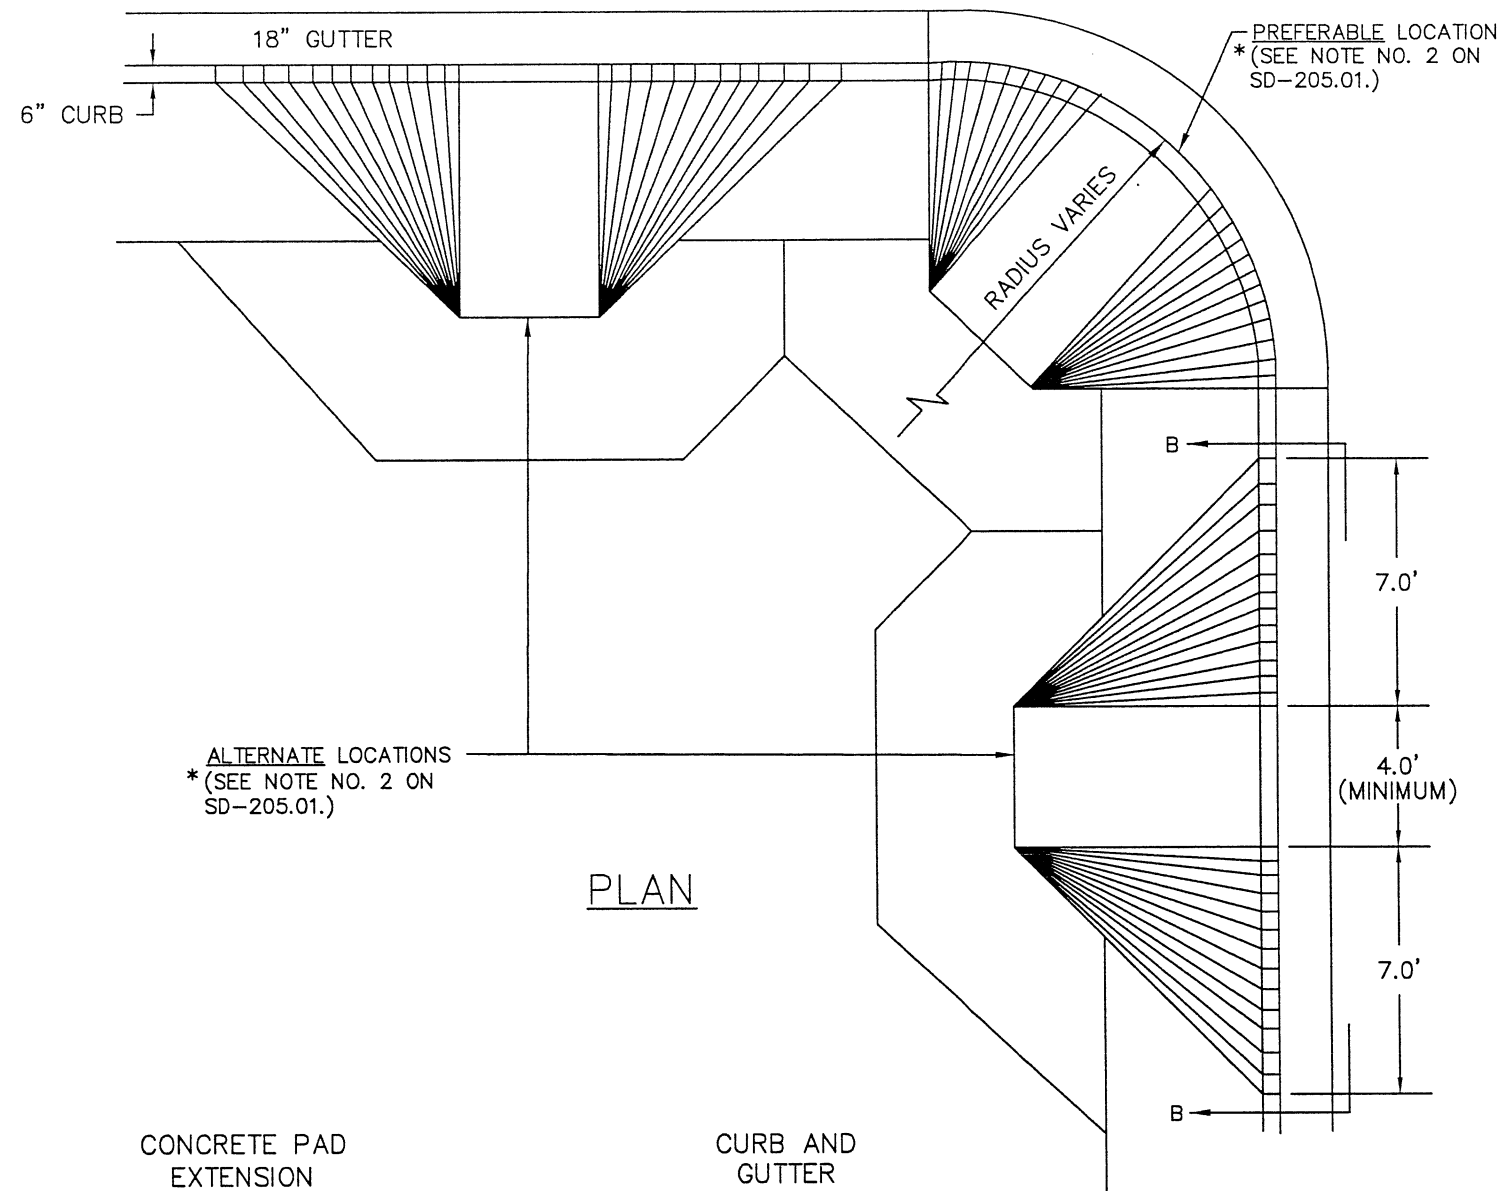

1	REVISIONS AS MARKED OR CLOUDED	8/24/01
0	INITIAL ISSUE	12/10/99
NO.	REVISION	DATE


CITY OF CHATTANOOGA AND HAMILTON COUNTY

HANDICAP RAMP DETAILS

DATE OF ORIGINAL ISSUE
DECEMBER 10, 1999



STANDARD NUMBER : SD-205.02

F:\STDDWGS\Curb, Mountable Island\Mountable Island Curb.dwg

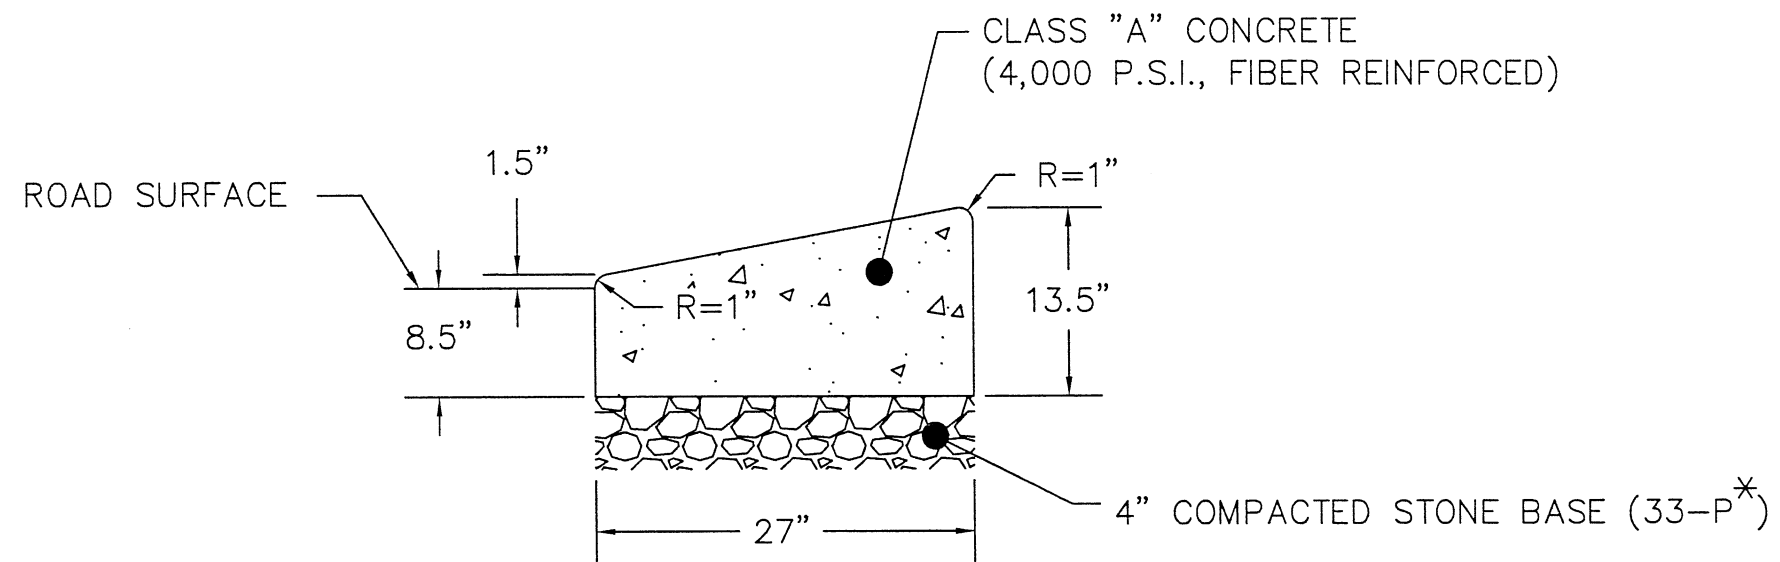

TYPICAL SECTION

* "33-P (PUG)" - 303.01,
TYPE A, GRADING D ("33-P"),
TENNESSEE D.O.T. SPECIFICATIONS

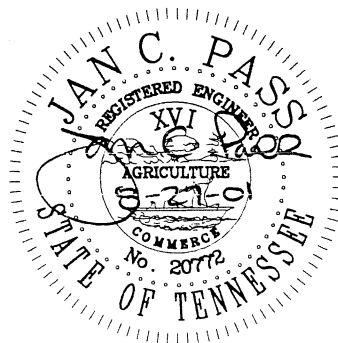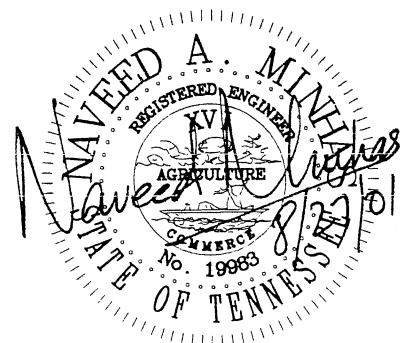

CITY OF CHATTANOOGA AND HAMILTON COUNTY			
MOUNTABLE ISLAND CURB			
0	INITIAL ISSUE	8/24/01	DATE OF ORIGINAL ISSUE
NO.	REVISION	DATE	AUGUST 24, 2001
			STANDARD NUMBER: SD-206.01


SANITARY SEWERS

F:\STDDWGS\Precast-CastinplaceManhole-County\PRECAST-CASTINPLACE-MANHOLE.dwg


NOTES

1. ALL MATERIALS, DESIGN, MANUFACTURE, PHYSICAL TEST REQUIREMENTS, FINISH, MARKING, INSPECTION, REJECTION, AND REPAIRS SHALL MEET A.S.T.M. C478 FOR PRECAST, REINFORCED CONCRETE MANHOLE RISERS AND TOPS EXCEPT AS MAY BE MODIFIED IN THESE SPECIFICATIONS.
2. SIZE AND LOCATE PIPE CUTOUTS AS REQUIRED.
3. MANHOLE STEPS - SEE MANHOLE STEPS DETAIL ON STANDARD NUMBER SD-301.04.
4. END-OF-LINE MANHOLES THAT HAVE FUTURE EXTENSIONS AND THAT ARE LOCATED IN PAVEMENT SHALL BE BACKFILLED WITH FLOWABLE FILL OR 33-P* STONE (PUG). THE BACKFILL SHALL BE COMPACTED TO 6-INCH LIFTS, AND SHALL EXTEND TEN (10') FEET FROM THE MANHOLE ALONG EACH TRENCH.
5. A MAXIMUM OF TWO CONCRETE RINGS MAY BE USED FOR ELEVATION ADJUSTMENT OF THE MANHOLE.
6. AN ECCENTRIC CONE MANHOLE SHALL NOT BE USED.


* "33-P (PUG)" - 303-01, TYPE A, GRADING D ("33-P"), TENNESSEE D.O.T. SPECIFICATIONS

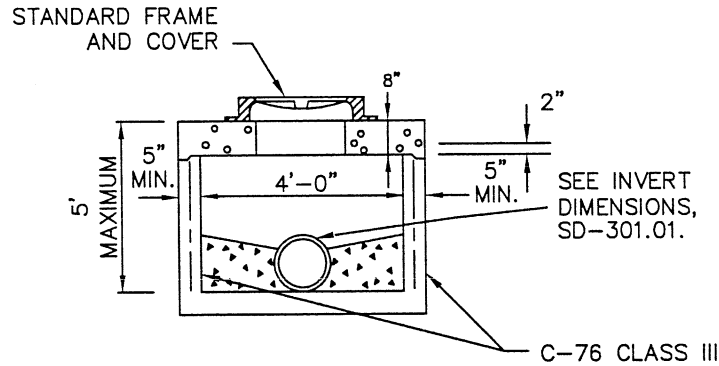


SPECIAL
SHALLOW MANHOLE

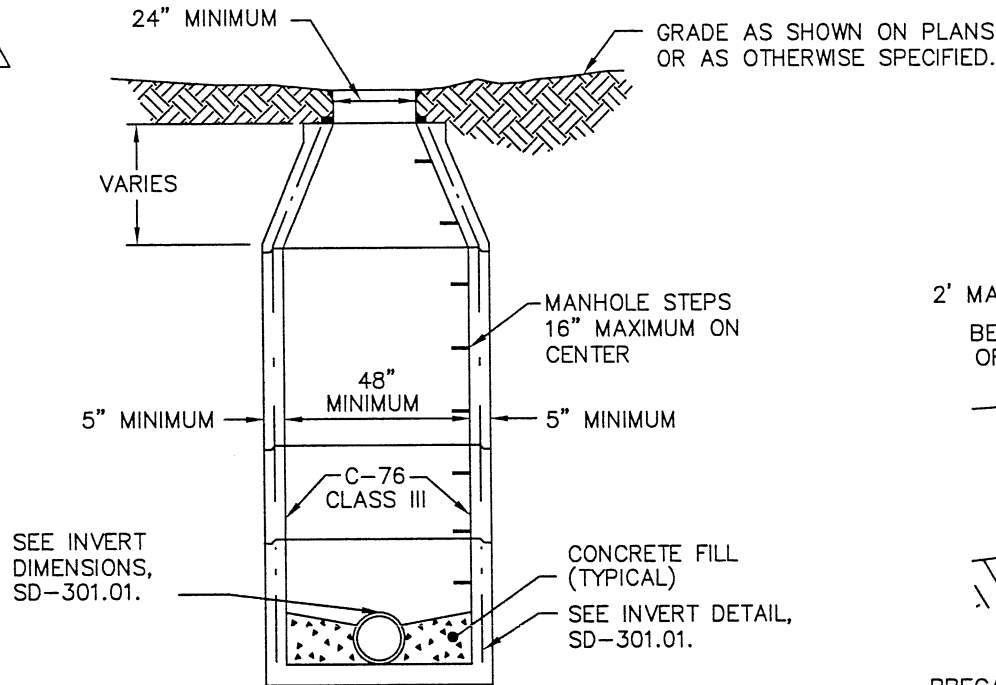

CONCENTRIC CONE

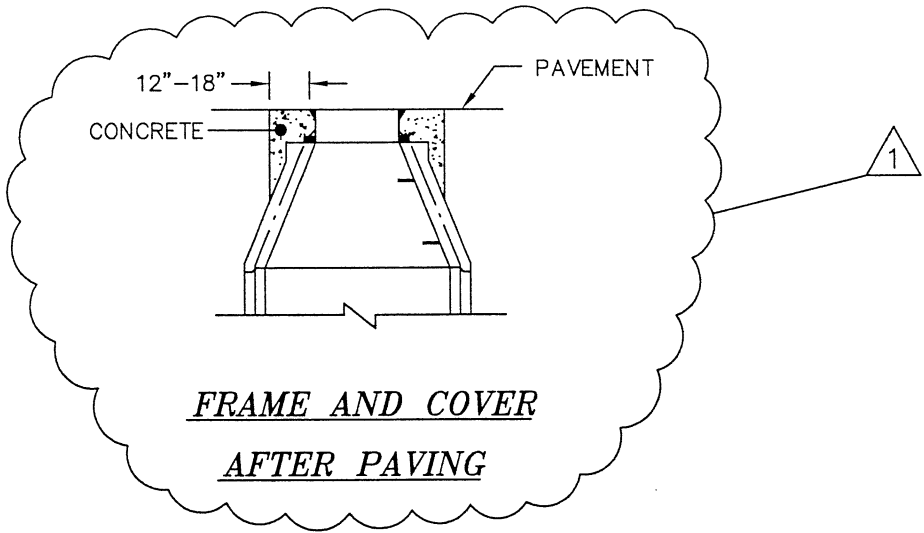

FRAME AND COVER
AFTER PAVING

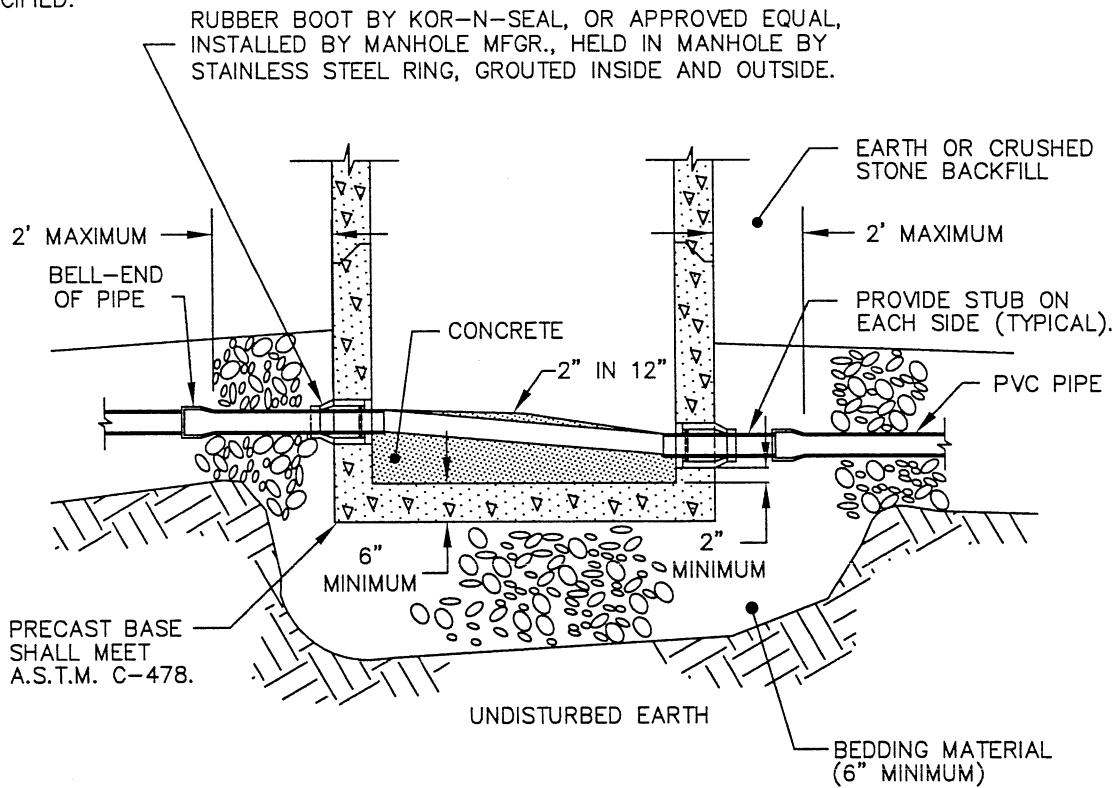


BOOTED, TUB-BOTTOM MANHOLE

PRECAST CONCRETE MANHOLES




CITY OF CHATTANOOGA AND HAMILTON COUNTY			
SANITARY/STORM MANHOLE (PRECAST)			
1	REVISIONS AS MARKED OR CLOUDED	8/24/01	STANDARD NUMBER : SD-300.01
0	INITIAL ISSUE	12/10/99	
NO.	REVISION	DATE	
DATE OF ORIGINAL ISSUE		DECEMBER 10, 1999	

F:\STDWGS\Precast-CastinplaceManhole-Country\PRECAST-CASTINPLACE-MANHOLE_2.dwg

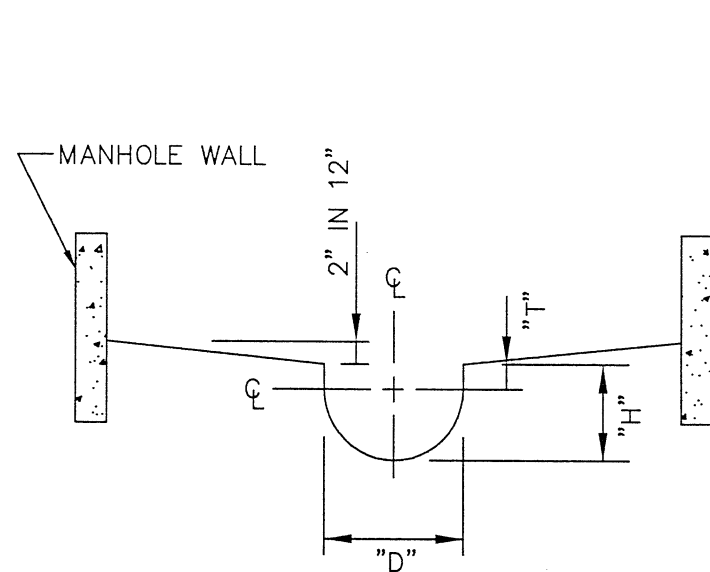


INVERT SECTION

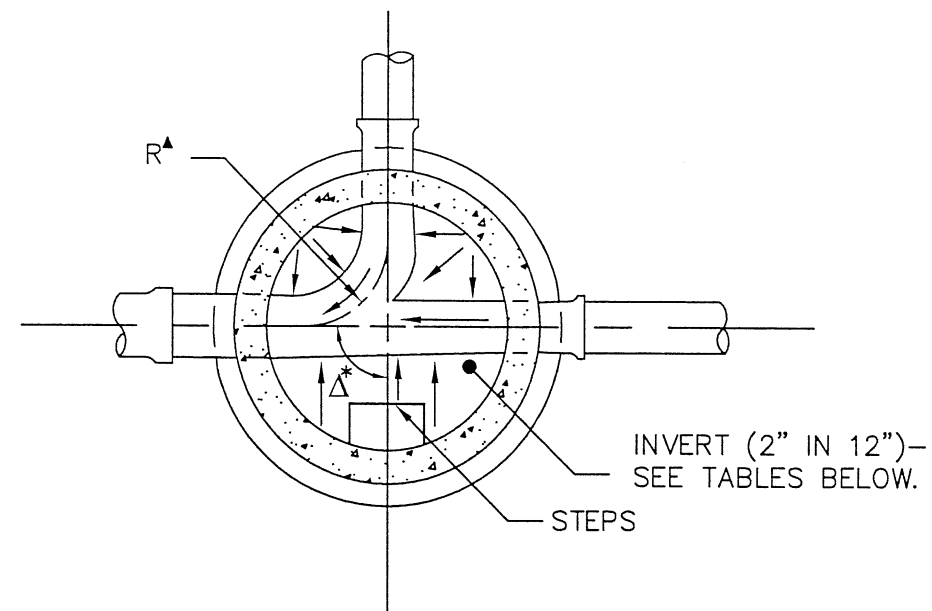


INVERT PLAN

NOTE

"H" AND "T" DIMENSIONS APPLY AT BOTH THE UPSTREAM AND THE DOWNSTREAM EDGES OF MANHOLE. SEE TABLE 1.

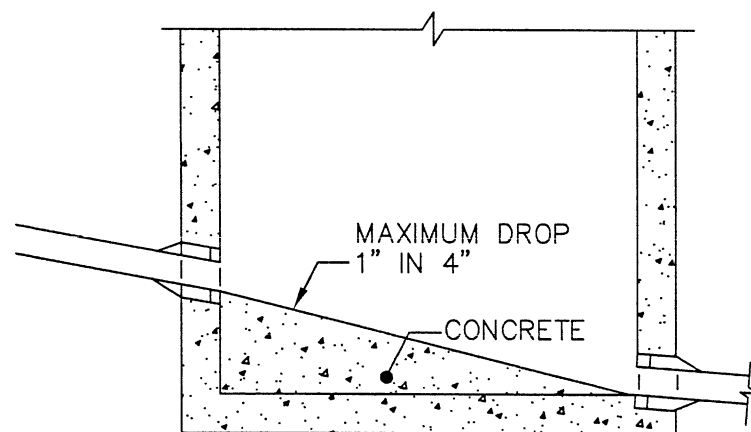



INVERT DETAIL
(WITH DROP LESS THAN 12")

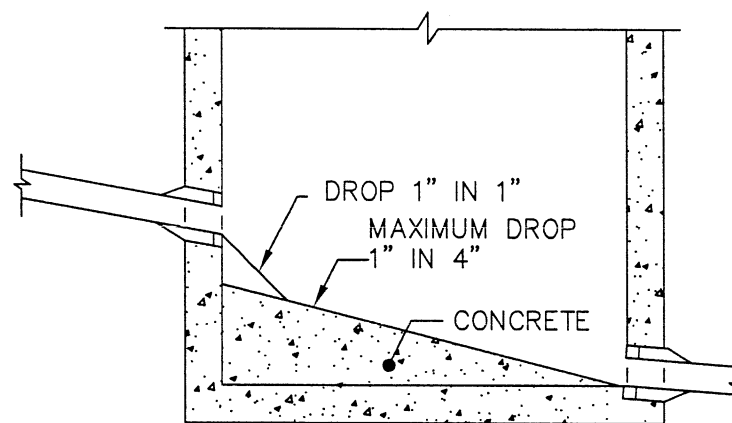

INVERT DETAIL
(WITH DROP OF 12" TO LESS THAN 24")

TABLE I		
"D"	"T"	"H"
INSIDE DIAM. PIPE	VERTICAL TANGENT	HEIGHT OF INVERT
8"	2 1/2"	6 1/2"
10"	3"	8"
12"	3 1/2"	9 1/2"
15"	4 1/2"	12"
18"	5 1/2"	14 1/2"
21"	6 1/2"	17"
24"	7 1/2"	19 1/2"
30"	9"	24"
36"	11"	29"

TABLE II GOVERNING DIMENSIONS FOR MANHOLE INVERTS			
PIPE SIZE	Δ* ANGLE	BASE DIAM.	R ^Δ
8" THRU 12"	0° TO 90°	4'	1'-6"
15"	0° TO 60°	4'	1'-10"
15"	60+ TO 90°	4'	1'-10"
18"	0° TO 60°	4'	2'-3"
18"	60+ TO 90°	4'	1'-10"
21"	0° TO 60°	4'	2'-7"
21"	60+ TO 90°	5'	2'-4"
24"	0° TO 45°	4'	3'-0"
24"	45+ TO 90°	5'	2'-3"
30"	0° TO 60°	5'	3'-9"
30"	60+ TO 90°	6'	2'-8"
36"	0° TO 30°	6'	4'-6"
LARGER THAN 36"	0° TO 90°	SEE PLANS	

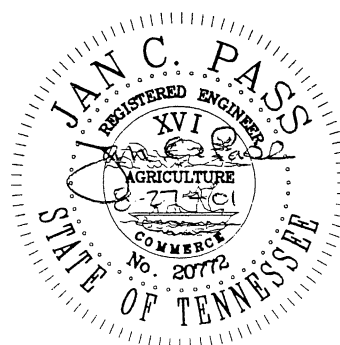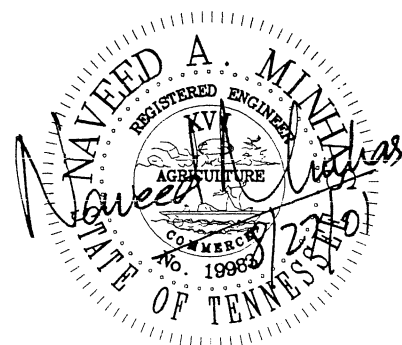

NO.	REVISION	DATE
1	REVISIONS AS MARKED OR CLOUDED	8/24/01
0	INITIAL ISSUE	12/10/99





CITY OF CHATTANOOGA AND HAMILTON COUNTY
SANITARY/STORM MANHOLE DETAILS

DATE OF ORIGINAL ISSUE
DECEMBER 10, 1999

STANDARD NUMBER : **SD-301.01**

NOTES

1. LOCATE 4" VENT PIPE OUT OF TRAVELED WAY BEHIND THE CURB OR SIDEWALK OR AS REQUIRED BY THE PLANS.
2. TOP OF VENT SHALL BE A MINIMUM OF 1' ABOVE THE 100 YEAR FLOOD ELEVATION (HIGHER IF THE ELEVATION IS SHOWN ON THE PLANS).
- * 3. USE TREATED SUPPORT POST WHEN $H > 3.0'$.

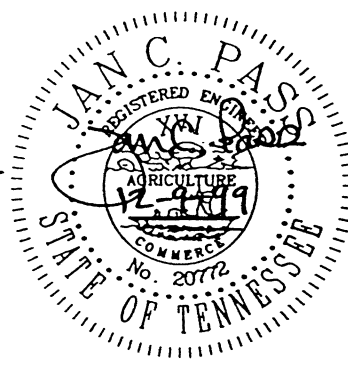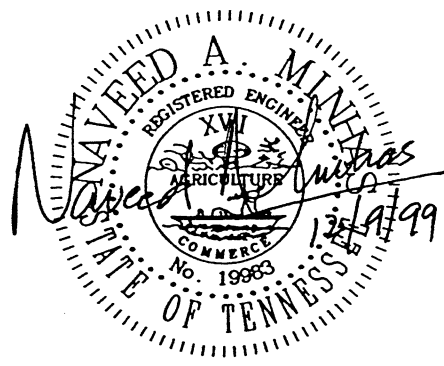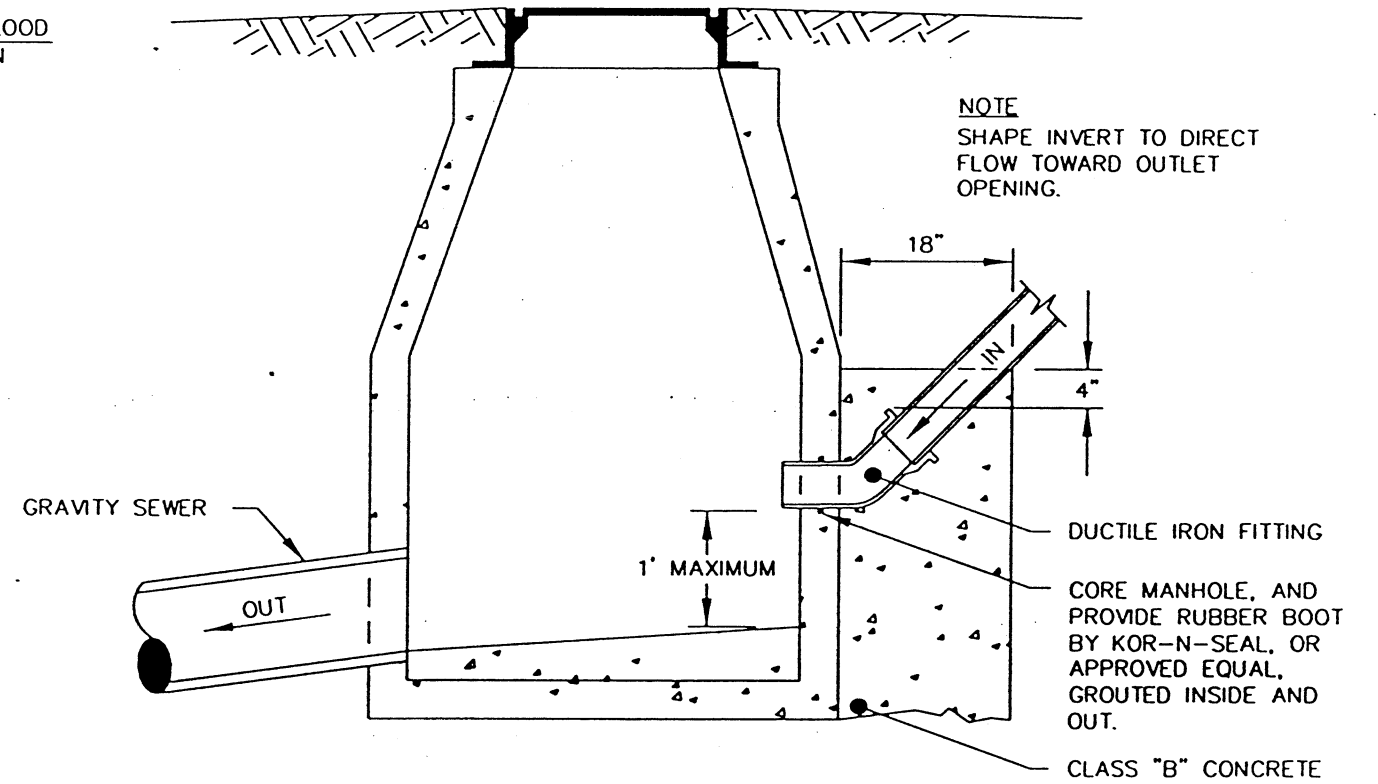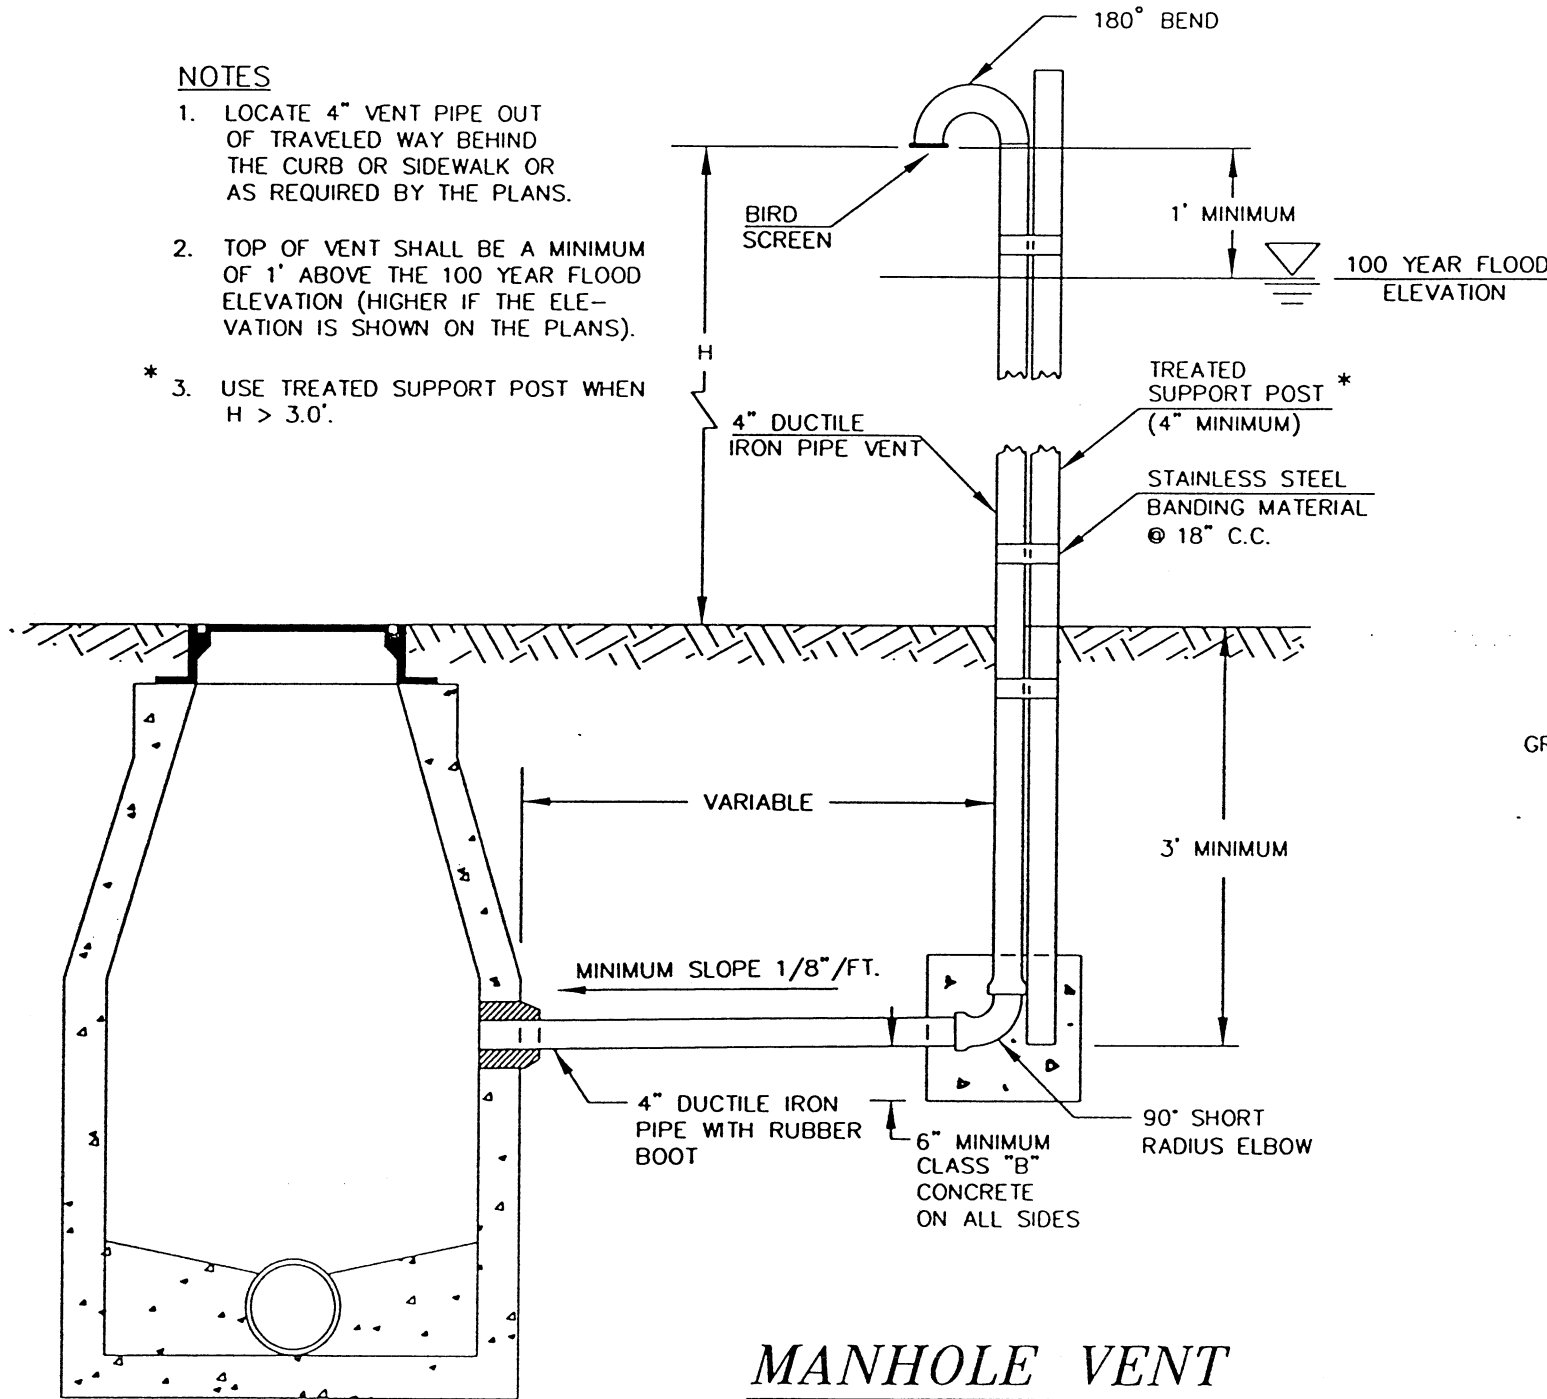

0	INITIAL ISSUE	12/10/99
NO.	REVISION	DATE


CITY OF CHATTANOOGA AND HAMILTON COUNTY SANITARY/STORM MANHOLE DETAILS

DATE OF ORIGINAL ISSUE
DECEMBER 10, 1999


STANDARD NUMBER: SD-301.02

NOTES

1. AIR RELEASE VALVE IS TO BE "CRISPIN SEWER VALVE", APCO 400 SEWAGE VALVE, OR EQUAL.
2. AIR-VACUUM VALVE INSTALLATION IS TO BE SIMILAR EXCEPT THAT THE VALVE IS TO BE APCO 402 SEWAGE VALVE, OR EQUAL.
3. 2" RELEASE LINE, GATE VALVE, AND CHECK VALVE ON AIR-VACUUM VALVE ONLY.

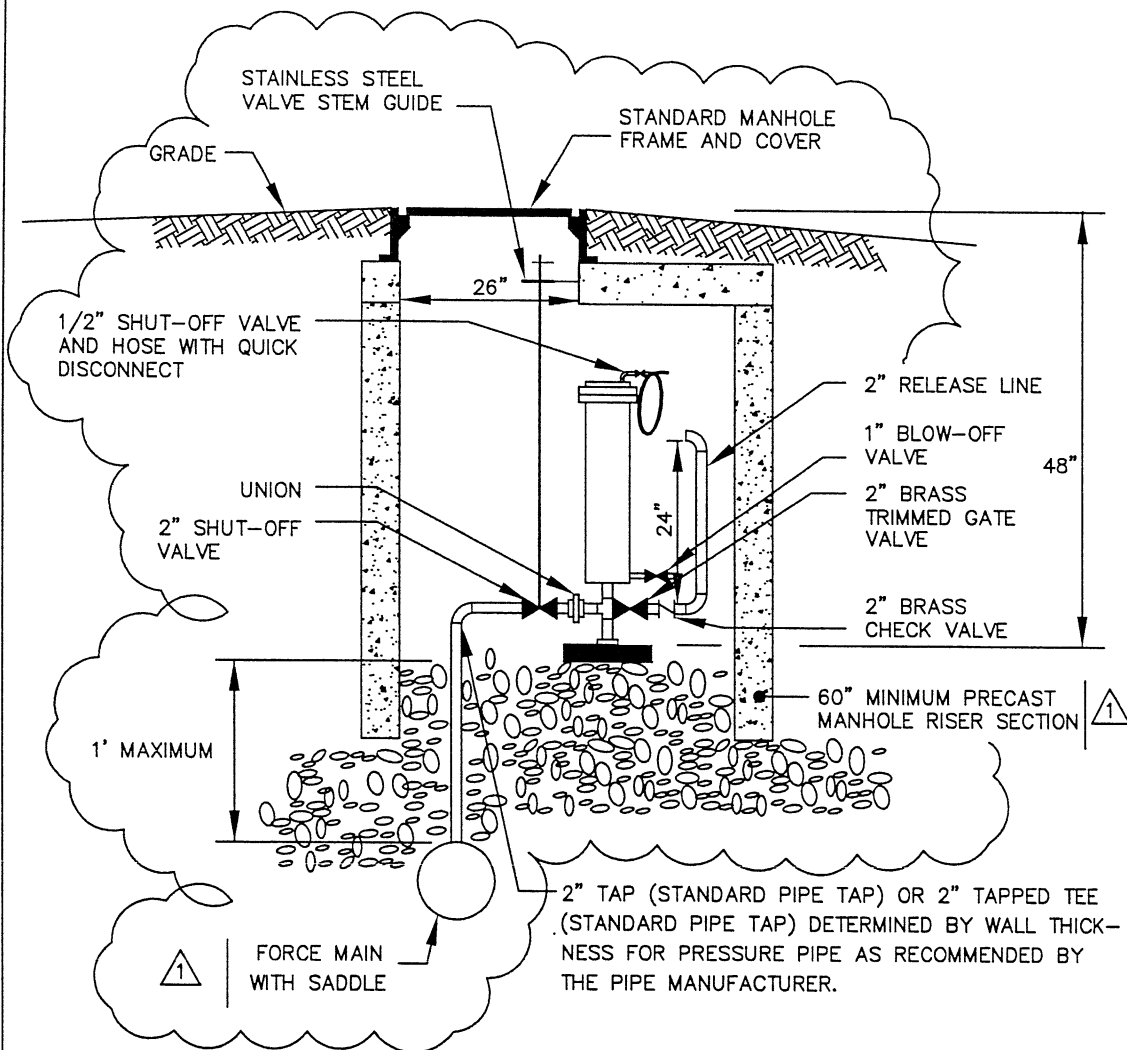


**AIR RELEASE VALVE
(SANITARY FORCE MAIN)**

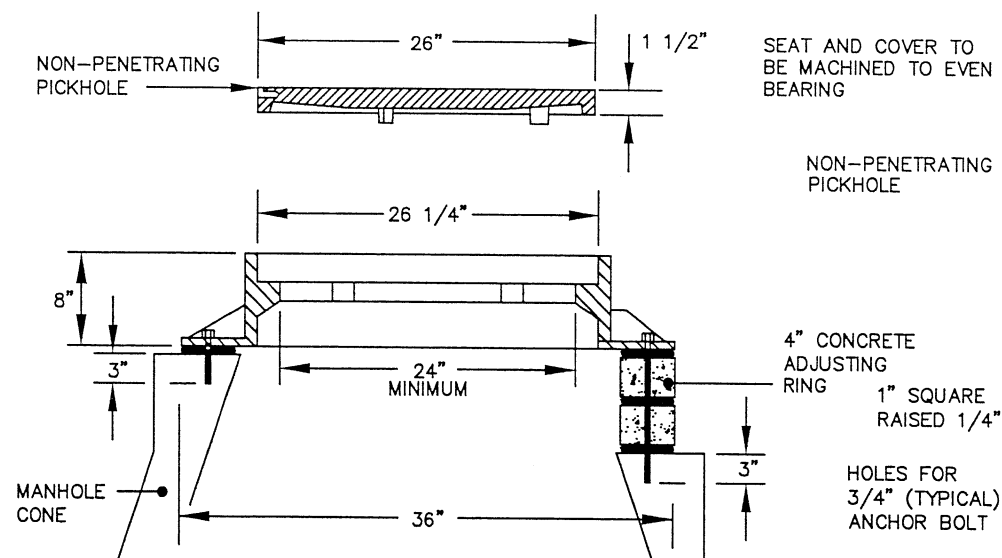

**SECTION
STANDARD FRAME AND COVER**


ACHESON FOUNDRY A-2024-81C (CITY),
A-2024-81D (CITY-"DRAIN"),
A-2024-81H (COUNTY),
OR APPROVED EQUAL

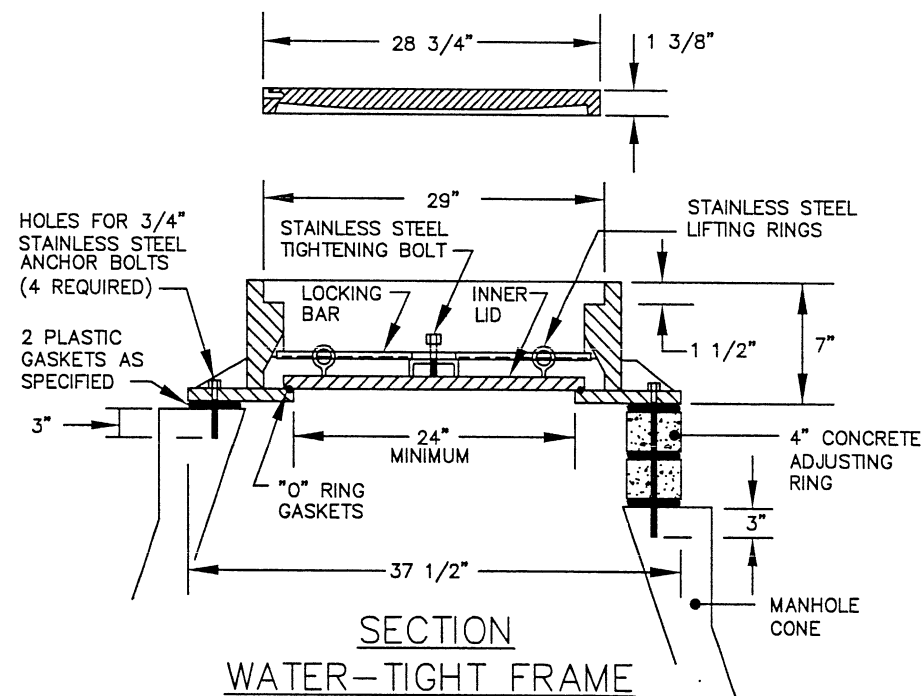


**SECTION
WATER-TIGHT FRAME
AND COVER**

ACHESON FOUNDRY A-2624-71C (CITY),
A-2624-71H (COUNTY),
OR APPROVED EQUAL

MANHOLE FRAME AND COVER

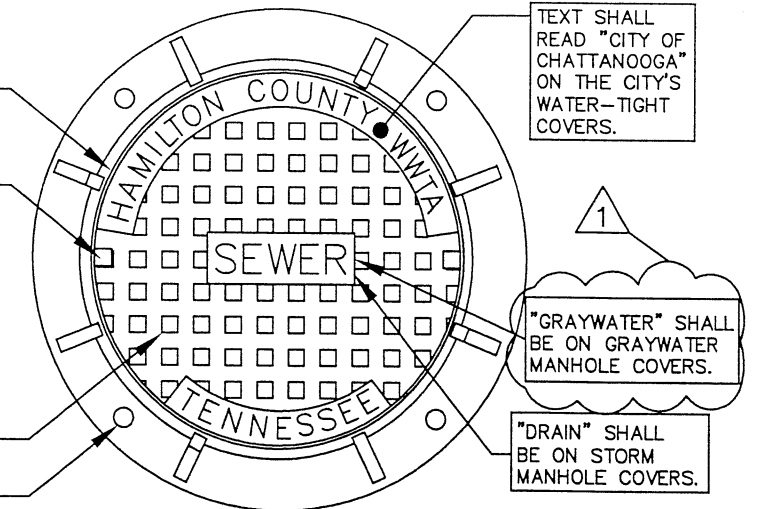

PLAN - FRAME AND COVER
ACHESON FOUNDRY (STANDARD) A-2024-81H (COUNTY),
(WATER-TIGHT) A-2624-71H (COUNTY),
(WATER-TIGHT) A-2624-71C (CITY),
OR APPROVED EQUAL


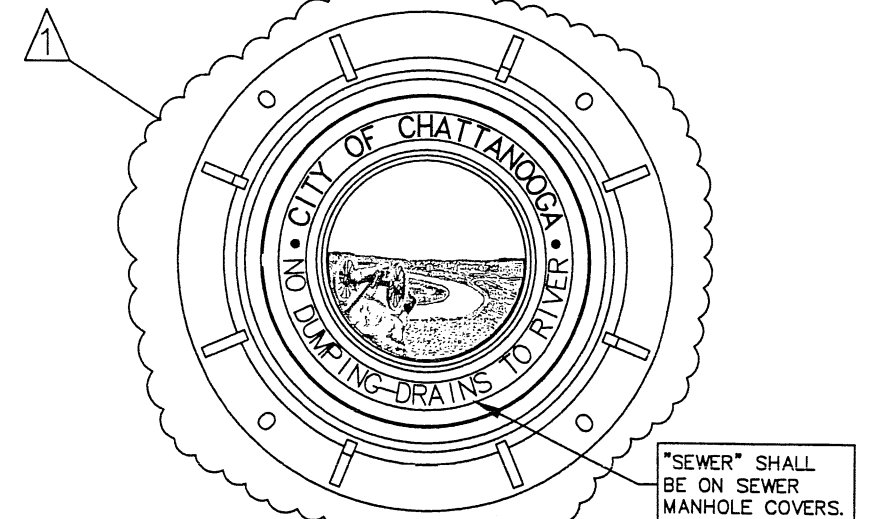


PLAN - FRAME AND COVER
ACHESON FOUNDRY (STANDARD) A-2024-81D (CITY),
(STANDARD) A-2024-81C (CITY-"SEWER"),
OR APPROVED EQUAL

SPECIFIED MINIMUM WEIGHTS		
	STANDARD	WATERTIGHT
COVER	165 LBS.	190 LBS.
FRAME	185 LBS.	400 LBS.
TOTAL	350 LBS.	590 LBS.

NOTES

1. THE MANUFACTURER SHALL CERTIFY THE TRAFFIC BEARING CAPACITY OF FRAMES AND COVERS.
2. MANHOLES IN PAVED AREAS MAY NOT REQUIRE ANCHOR BOLTS.
3. BEARING SURFACES BETWEEN COVER AND FRAME SHALL BE MACHINED TO PREVENT ROCKING.

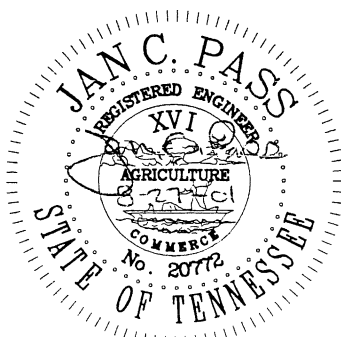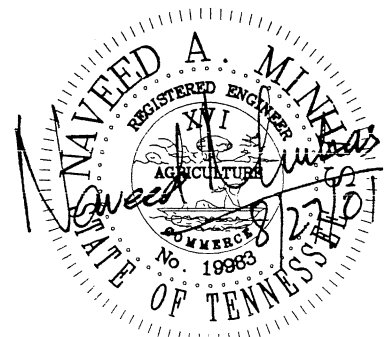


NO.	REVISION	DATE
1	REVISIONS AS MARKED OR CLOUDED	8/24/01
0	INITIAL ISSUE	12/10/99
	REVISION	DATE

**CITY OF CHATTANOOGA AND HAMILTON COUNTY
SANITARY/STORM MANHOLE DETAILS**

DATE OF ORIGINAL ISSUE
DECEMBER 10, 1999

STANDARD NUMBER: **SD-301.03**


F:\STDWGS\Manhole-ForceMain-County\ManholewithForceMain_4.dwg

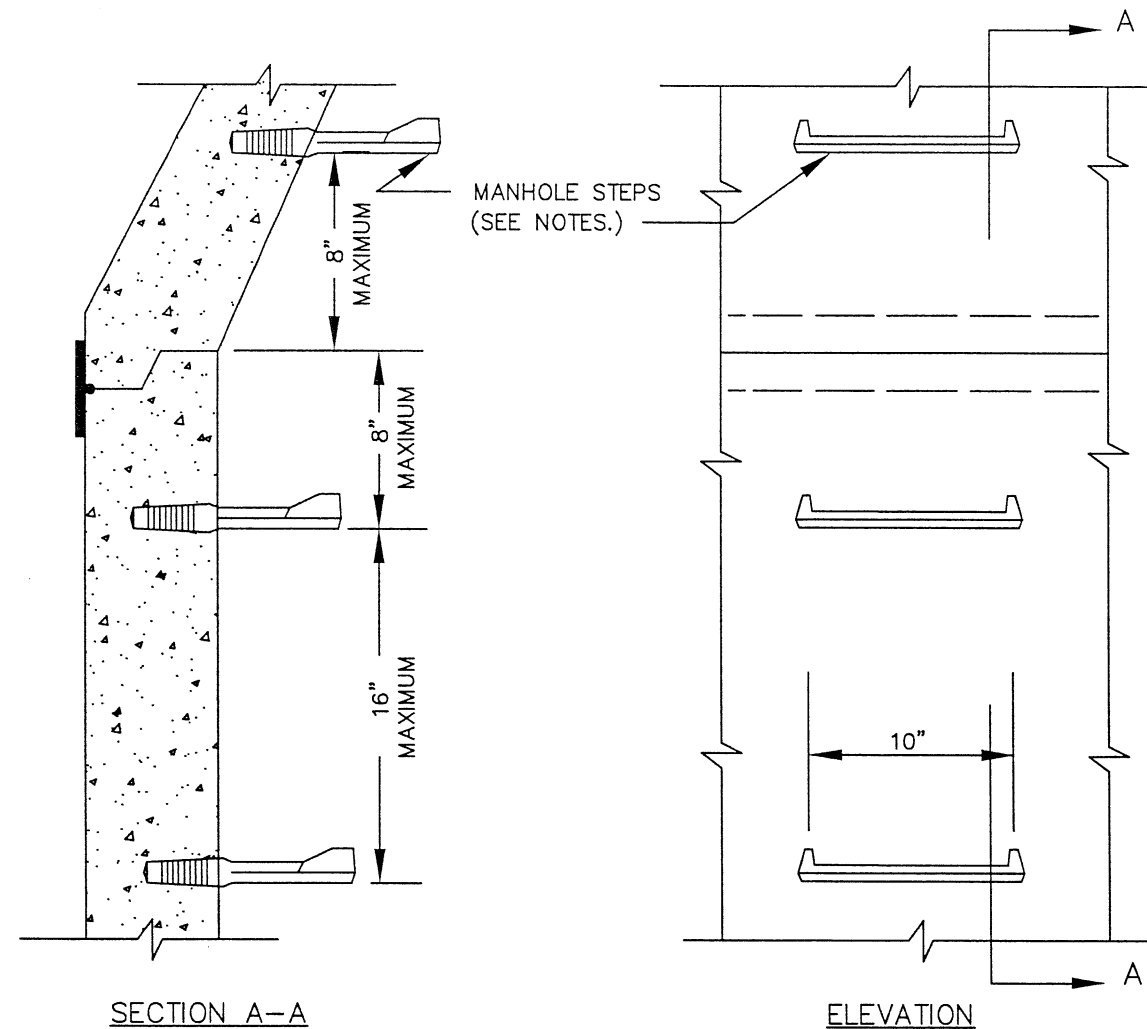

NOTES

1. STEPS SHALL BE 3/8" STEEL REINFORCED ROD ENCAPSULATED IN POLYPROPYLENE PLASTIC.
2. RISER SECTIONS SHALL BE SET SO THAT STEPS ALIGN VERTICALLY.
3. THE FIRST STEP SHALL BE NO MORE THAN 16" BELOW THE TOP OF THE MANHOLE CONE.



MANHOLE STEPS

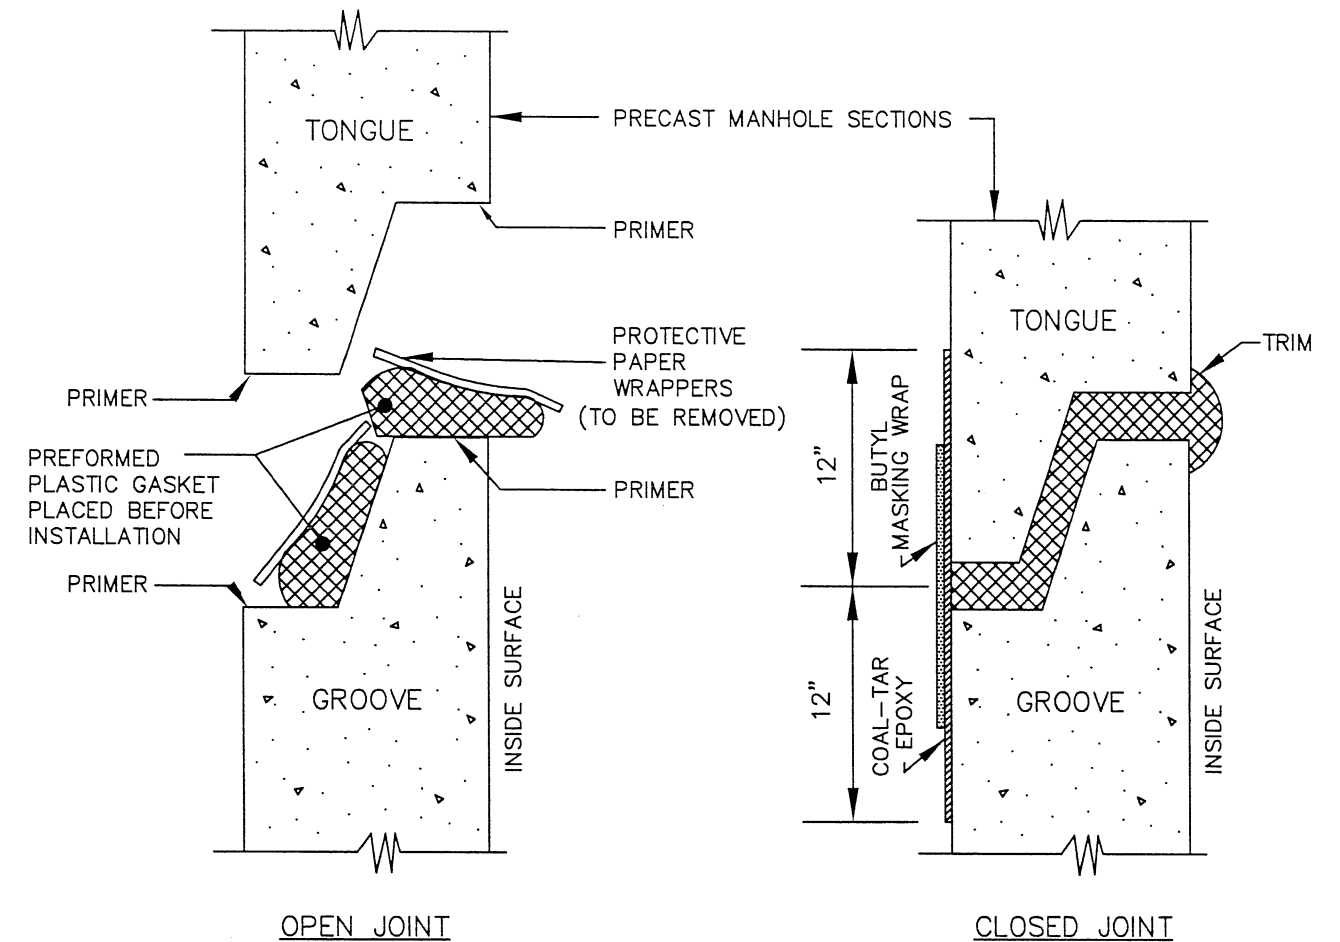

NOTES

1. CLEAN ALL DEBRIS FROM JOINTS PRIOR TO GASKET APPLICATION.
2. TRIM PROTRUDING GASKET INSIDE AND OUTSIDE.

JOINT AND GASKET FOR PRECAST MANHOLE SECTIONS

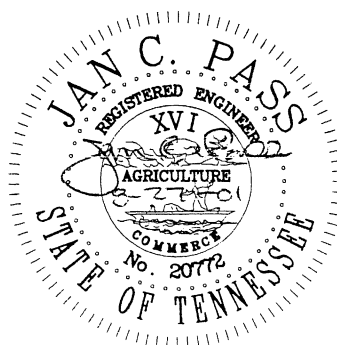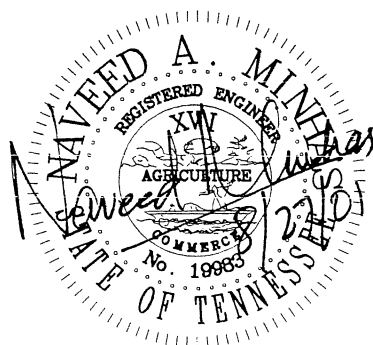

1	REVISIONS AS MARKED OR CLOUDED	8/24/01
0	INITIAL ISSUE	12/10/99
NO.	REVISION	DATE

CITY OF CHATTANOOGA AND HAMILTON COUNTY

SANITARY/STORM MANHOLE DETAILS

DATE OF ORIGINAL ISSUE
DECEMBER 10, 1999


STANDARD NUMBER: SD-301.04

F:\STDDWGS\StdManhole(Drop)-County\Manhole_Drop-County_2.dwg


D ₁	D ₂
8"	8"
10"	8"
12"	10"
15"	12"
18"	12"

NOTES

1. SET INLET FROM DROP TO MATCH CROWNS WITH OUTLET EXCEPT THAT MINIMUM FALL ACROSS MANHOLE INVERT MUST BE 3".
2. FOR DETAILS NOT SHOWN, SEE SANITARY/STORM MANHOLE DETAILS ON STANDARDS SD-301.01, SD-301.02, SD-301.03, AND SD-301.04.
3. THE RISER PIPE SHALL BE CONSTRUCTED OF THE SAME MATERIAL AS THAT OF THE INCOMING LINE.


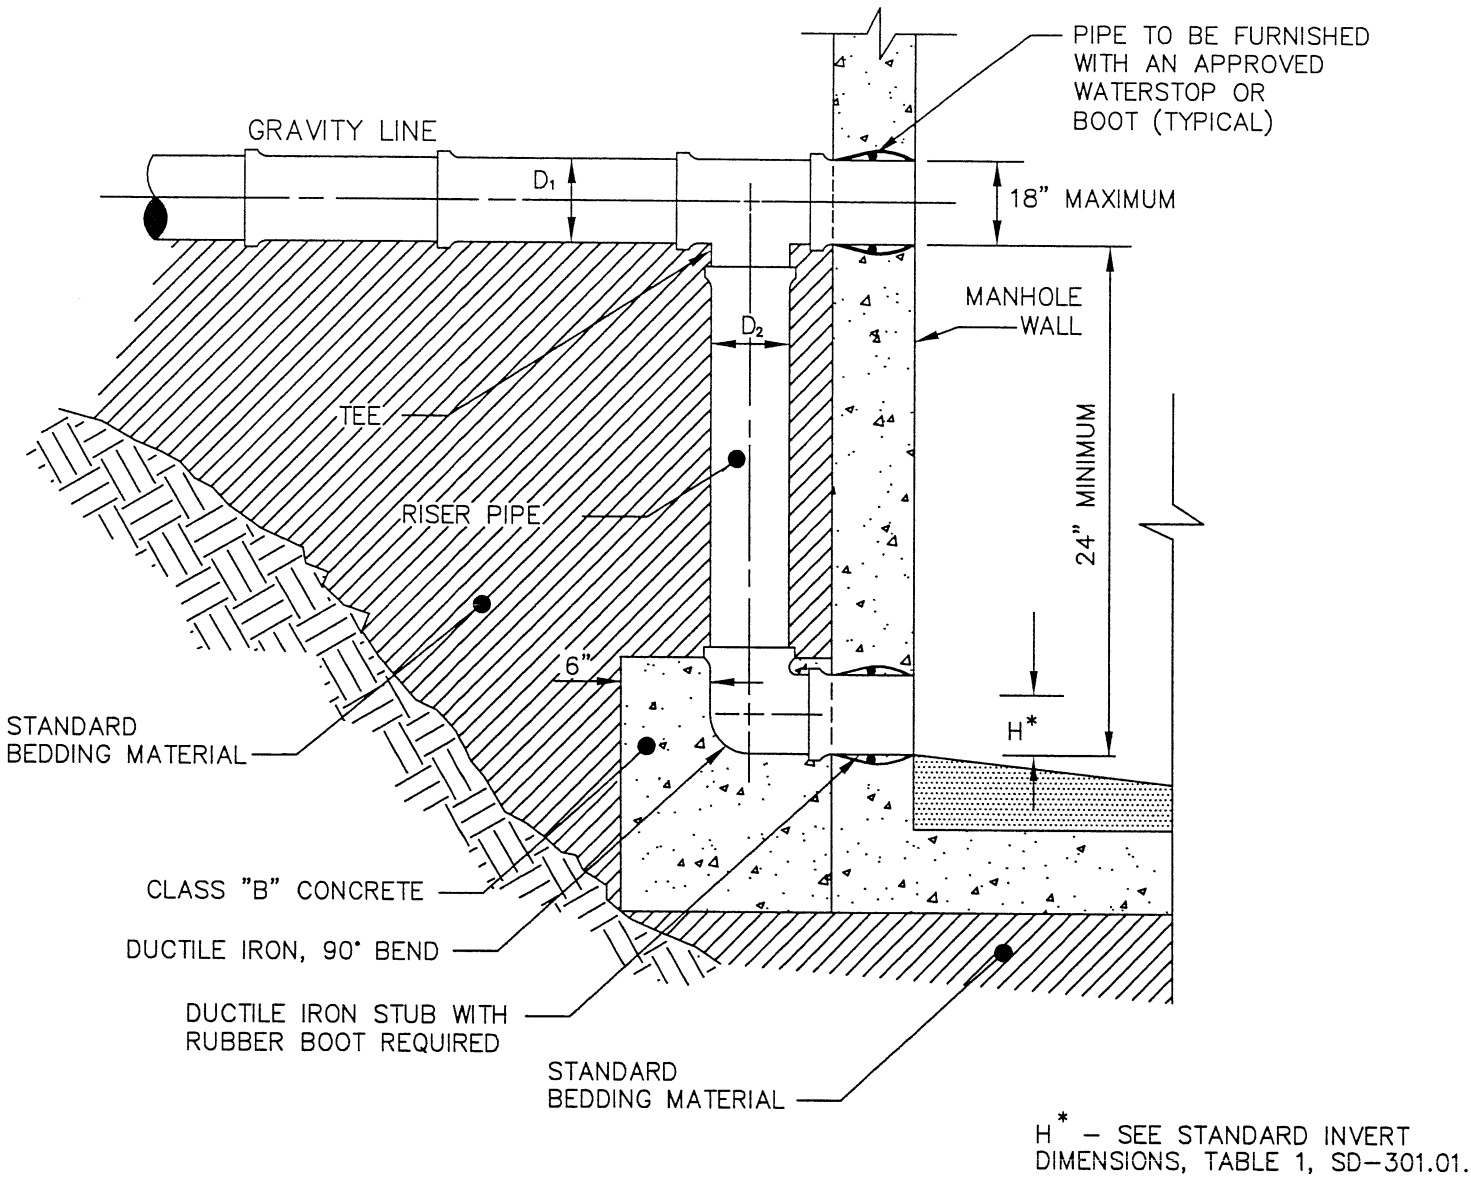


MANHOLE DROP
CONNECTION
(DROP OF 24" OR GREATER)

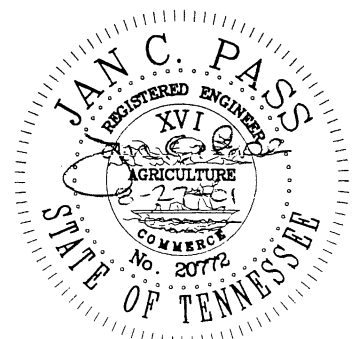

			CITY OF CHATTANOOGA AND HAMILTON COUNTY	
			SANITARY MANHOLE DROP CONNECTION	
1	REVISIONS AS MARKED OR CLOUDED	8/24/01	DATE OF ORIGINAL ISSUE	
0	INITIAL ISSUE	12/10/99	DECEMBER 10, 1999	
NO.	REVISION	DATE	STANDARD NUMBER : SD-302.01	


F:\STDDWGS\TrenchDetails-County-Combined_1.dwg

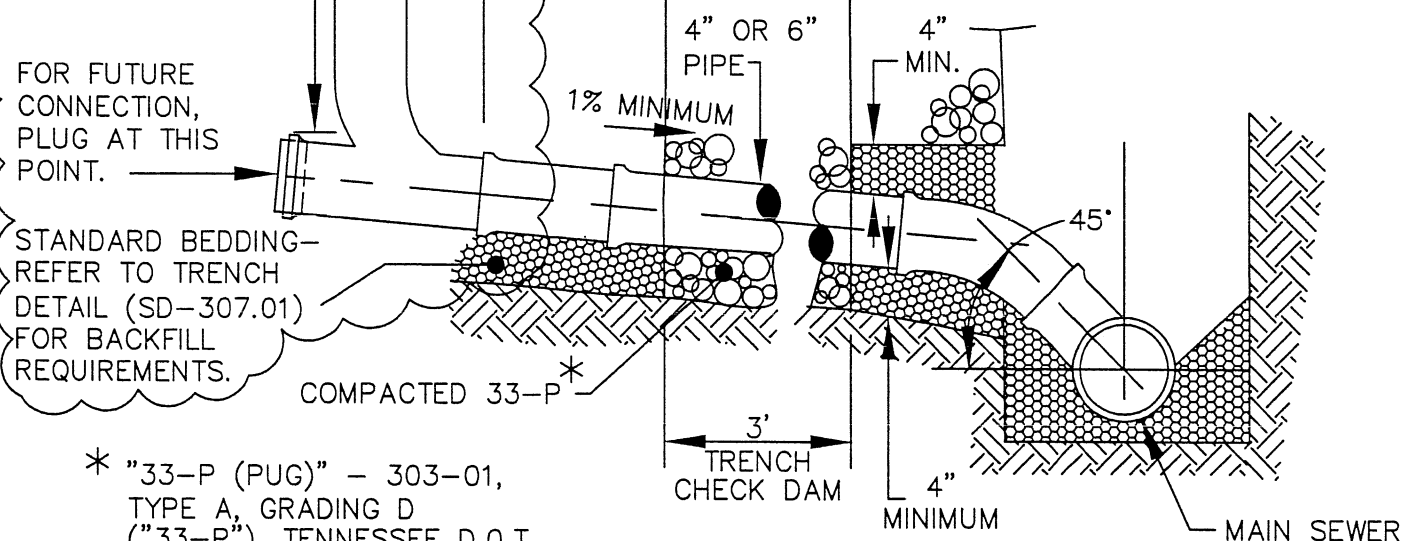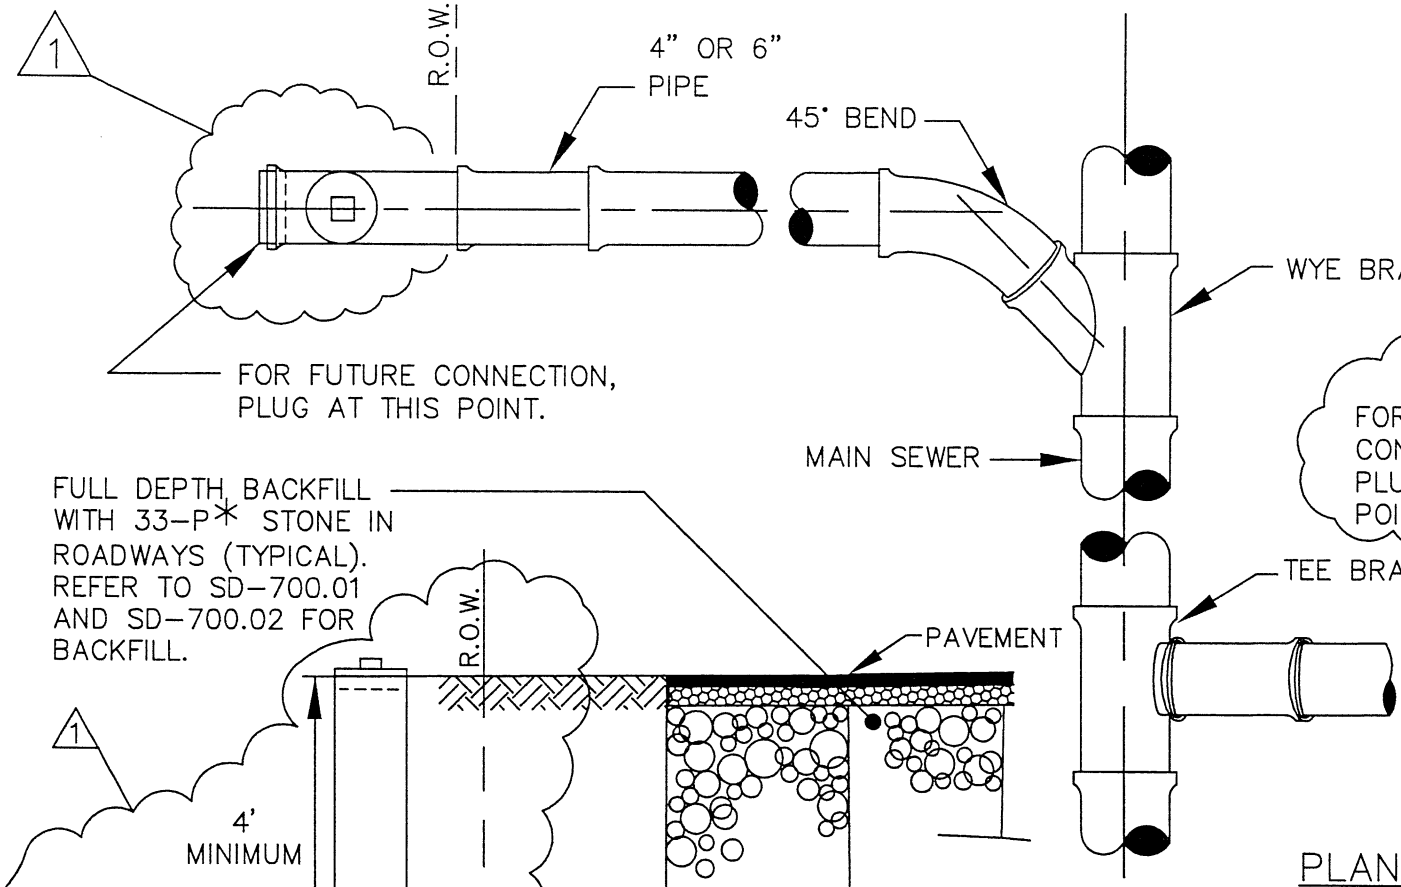

* "33-P (PUG)" - 303-01, TYPE A, GRADING D ("33-P"), TENNESSEE D.O.T. SPECIFICATIONS.

PROFILE

SHALLOW SEWER

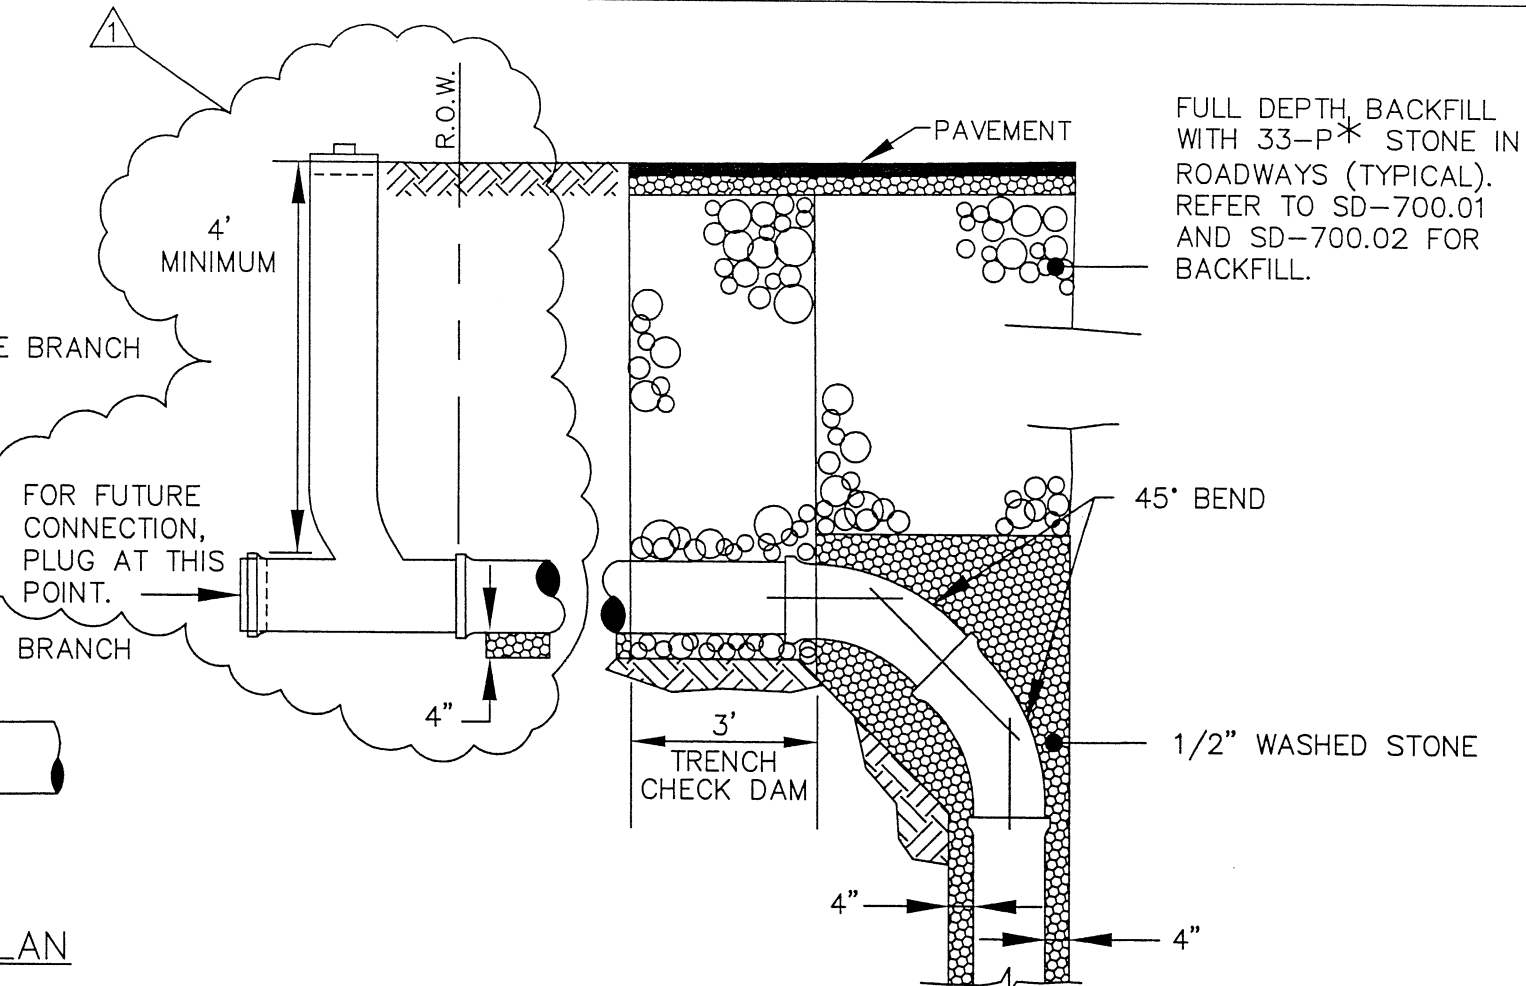




NOTES

1. STANDARD BEDDING SHALL EXTEND 4" MINIMUM ON EACH SIDE OF THE PIPE.
2. FOR DEPTH LESS THAN 4', PIPE SHALL BE DUCTILE IRON.



PROFILE

DEEP SEWER

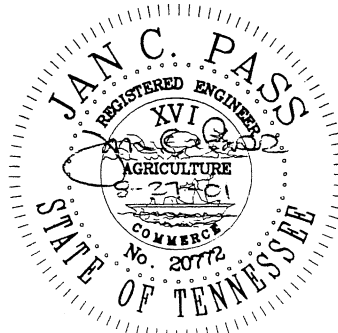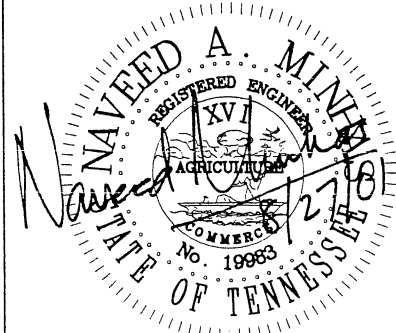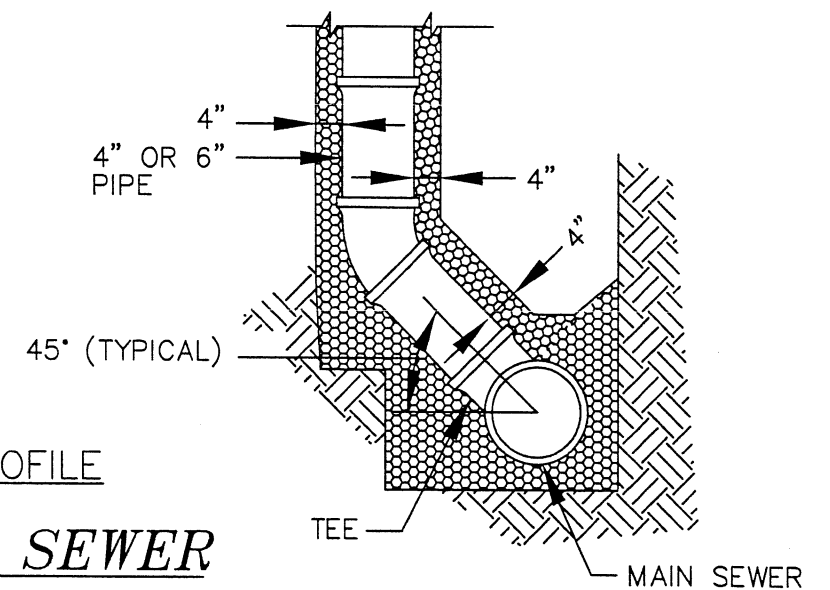

1	REVISIONS AS MARKED OR CLOUDED	8/24/01
0	INITIAL ISSUE	12/10/99
NO.	REVISION	DATE

CITY OF CHATTANOOGA AND HAMILTON COUNTY	
SANITARY SEWER SERVICE CONNECTION AND LATERAL DETAIL	
DATE OF ORIGINAL ISSUE DECEMBER 10, 1999	STANDARD NUMBER: SD-303.01

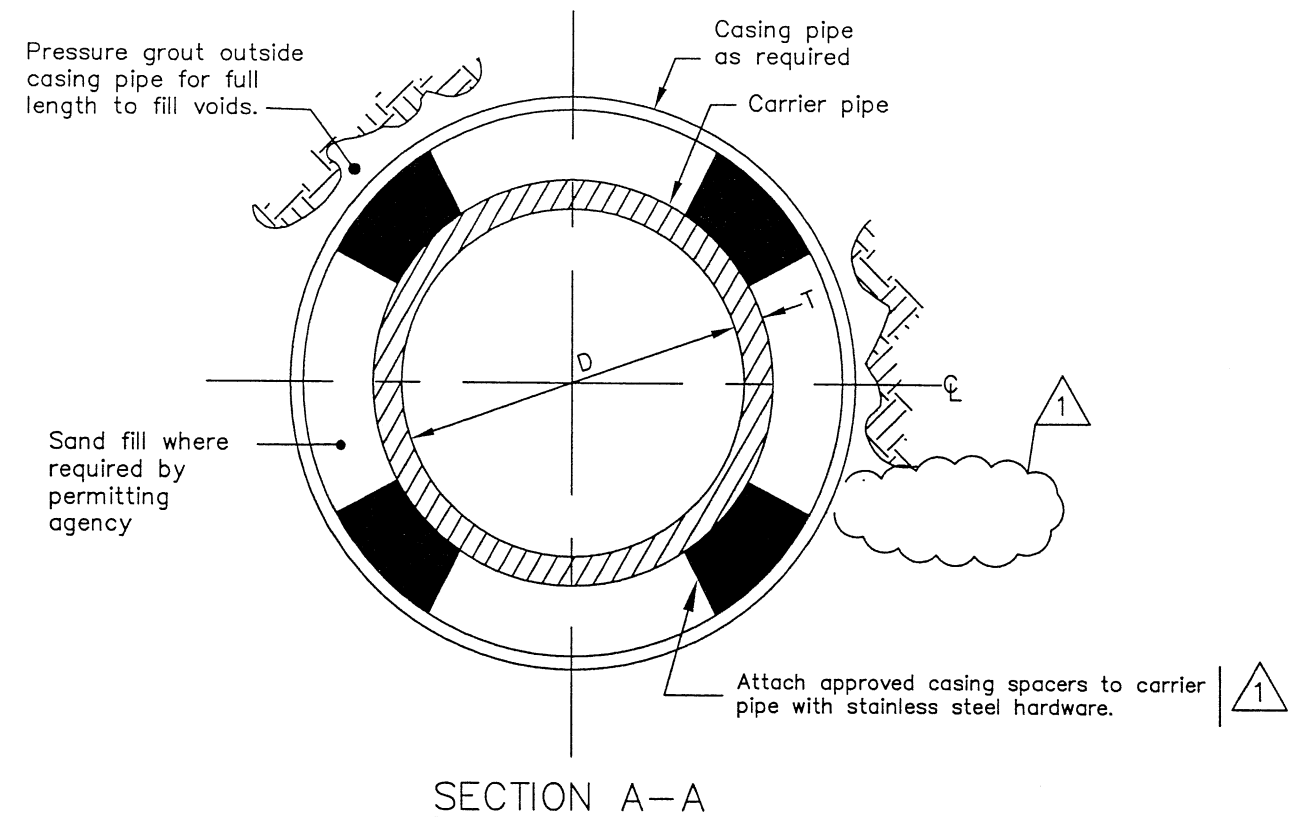


TABLE "B"										
Gauges of Liner Plate For Continuous Load-Carrying Structures										
Nominal Diameter (Inches)	Height of Cover (Feet)									
	2-5	6-10	11-15	16-20	21-25	26-30	31-35	36-40	41-45	
48	12	12	12	12	12	12	12	12	10	
54	12	12	12	12	12	12	12	10	8	
60	12	12	12	12	12	12	10	8	7	
66	12	12	12	12	12	10	8	8	5	
72	12	12	12	12	12	10	8	7	5	
78	12	12	12	12	10	8	7	5	5	
84	12	12	12	10	10	8	5	5	5	
96	12	10	10	10	10	8	5	5	5	
108	10	10	10	10	8	7	5	5	5	
120	10	10	10	8	8	7	5	5	5	
144	8	8	8	8	5	5	3	1	1	

SIZE AND THICKNESS OF PIPE FOR HIGHWAY CROSSING

- 1

 1. LINES CROSSING UNDER PAVED ROADS AND PAVED CROSSROADS WITHIN DESIGNATED CITY STREETS, AND STATE AND U.S. HIGHWAY RIGHTS-OF-WAY SHALL BE ENCASED AND INSTALLED BY BORING, JACKING, OR TUNNELLING. CASING PIPE SHALL EXTEND FROM TOE OF SHOULDER SLOPE TO TOE OF SHOULDER SLOPE. ALL WORK SHALL BE DONE AS SHOWN ON THIS DRAWING.
 2. ALL LINES SHALL HAVE A MINIMUM COVER OF 30" EXCEPT WHERE DEEPER COVER IS INDICATED ON THE DRAWINGS. ALL TRENCH EXCAVATION WITHIN THE RIGHT-OF-WAY AND NOT UNDER PAVING SHALL BE BACKFILLED BY TAMPING IN 6" LAYERS. ALL SURPLUS MATERIAL SHALL BE REMOVED FROM THE RIGHT-OF-WAY, AND THE EXCAVATION SHALL THEN BE FINISHED FLUSH WITH THE SURROUNDING GROUND.
 3. CASING PIPE SHALL BE EITHER SPIRAL WELDED STEEL PIPE OR STEEL LINER PLATE, APPLICABLE AND SUITABLE TO THE METHOD OF INSTALLATION EMPLOYED (SEE TABLE "A"). ALL CASING PIPE SHALL BE COATED INSIDE AND OUT PER SPECIFICATIONS.
 4. CARRIER PIPE FOR ALL LINES 6" TO 54" IN DIAMETER SHALL BE CAST OR DUCTILE IRON PIPE * WITH "PUSH-ON" TYPE JOINTS. CARRIER PIPE 60" IN DIAMETER AND LARGER SHALL BE REINFORCED CONCRETE WITH "BELL AND SPIGOT" JOINTS. FOR SIZE, SEE PLAN AND PROFILE DRAWINGS.
 5. ALL INSTALLATIONS SHALL BE DONE TO LEAVE FREE FLOWS IN DRAINAGE DITCHES, PIPES, CULVERTS, OR OTHER SURFACE WATER DRAINAGE FACILITIES OF THE HIGHWAY OR STREET OR ITS CONNECTIONS.
 6. THE CONTRACTOR SHALL MAKE NECESSARY ARRANGEMENTS FOR HIGHWAY TRAFFIC OVER THE CONSTRUCTION AREA DURING SUCH WORK AND SHALL PLACE NECESSARY BARRICADES, WARNING SIGNS, SIGNALS, LIGHTS, AND, IF NECESSARY, WATCHMEN FOR THE TRAVELING PUBLIC.

THE GREAT SEAL OF THE STATE OF TENNESSEE

REGISTERED ENGINEER

KV


AGRICULTURE

COMMERCE


NO. 19983

MAVEED A. MINER


24/01

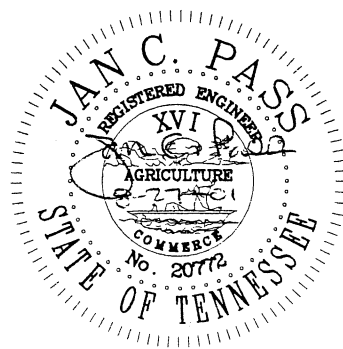

			CITY OF CHATTANOOGA AND HAMILTON COUNTY	
			<i>HIGHWAY CROSSING FOR SANITARY SEWERS</i>	
1	REVISIONS AS MARKED OR CLOUDED	8/24/01	DATE OF ORIGINAL ISSUE	
0	INITIAL ISSUE	12/10/99	<i>DECEMBER 10, 1999</i>	STANDARD NUMBER : <i>SD-304.01</i>
NO.	REVISION	DATE		

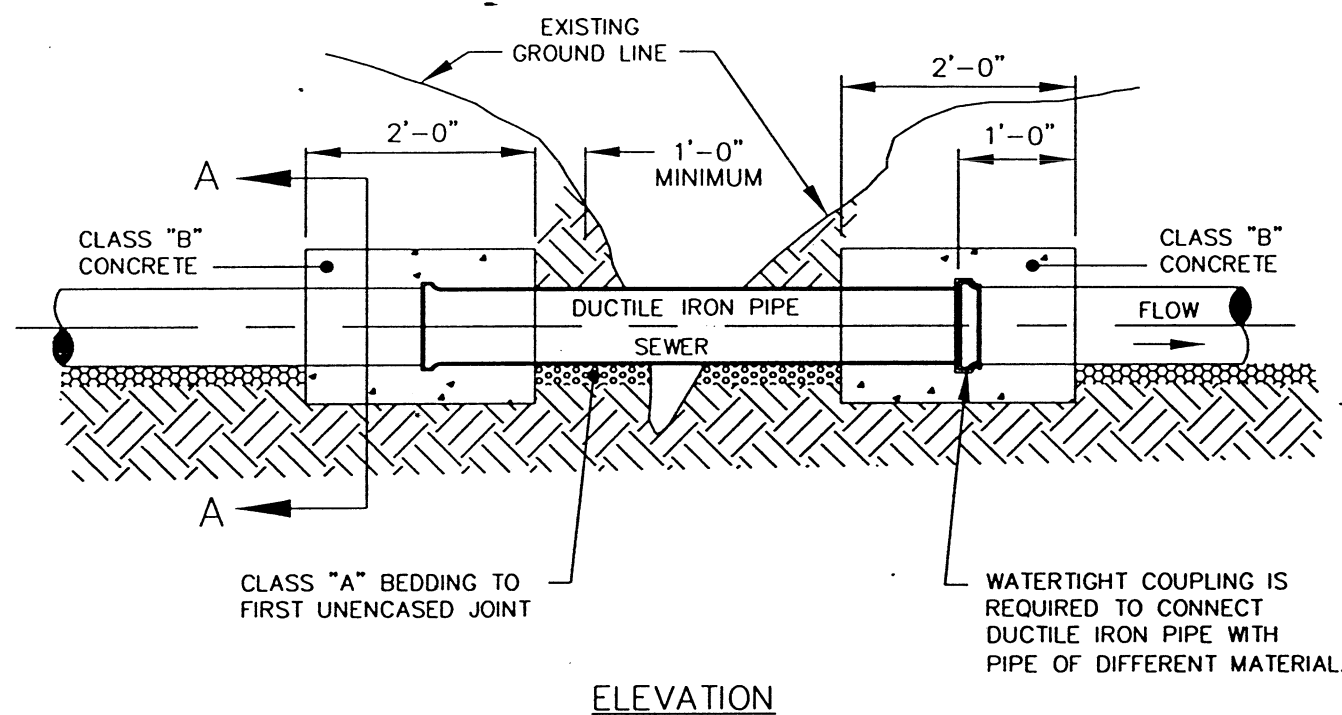


DITCH CROSSING DETAIL

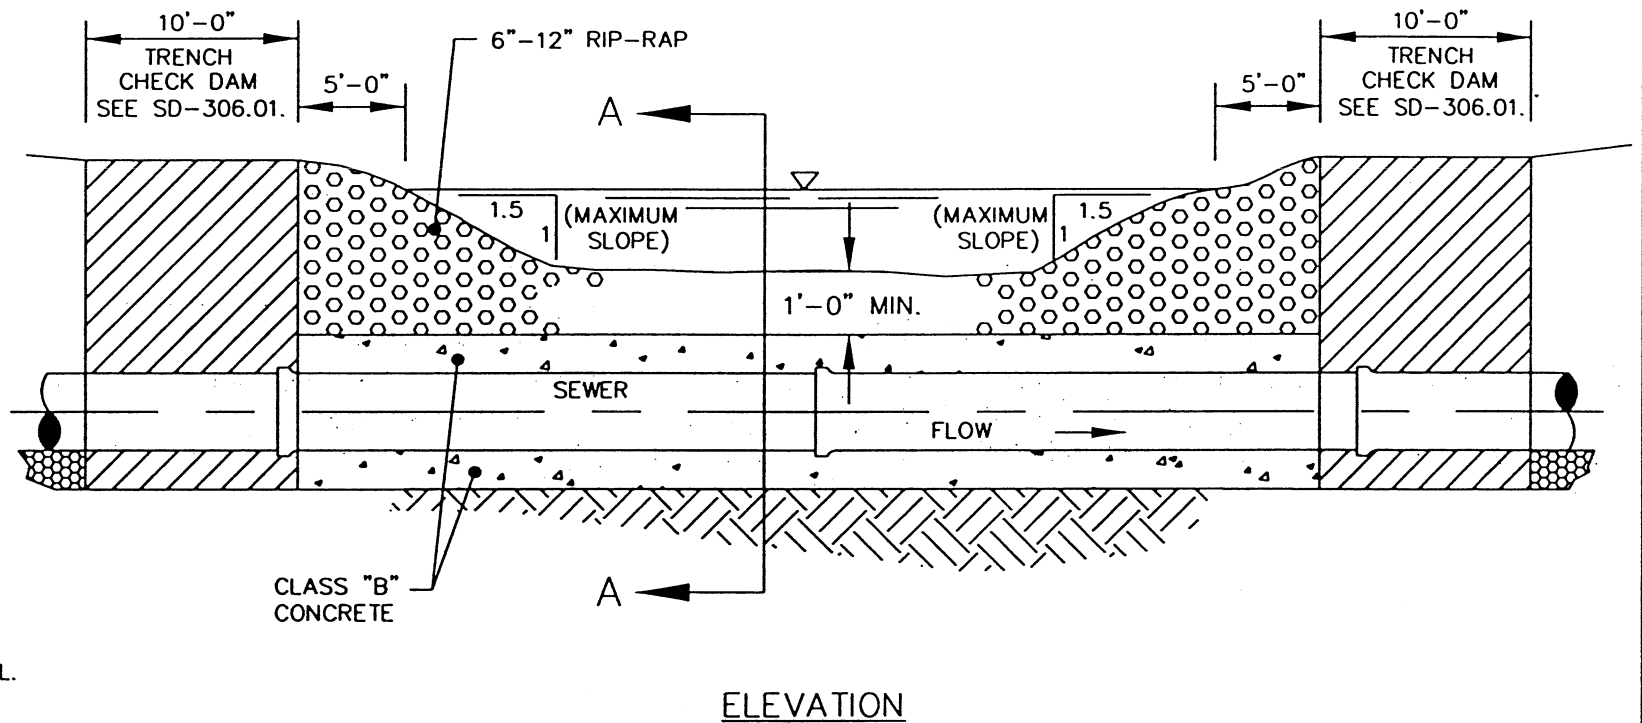


CREEK CROSSING DETAIL

PIPE SIZE "D" (IN)	TRENCH WIDTH "BD" (FT)
6	2.00
8	2.33
10	2.50
12	2.67
15	3.00
18	3.25
24	3.83
30	4.42
36	5.67
42	6.25
48	6.83

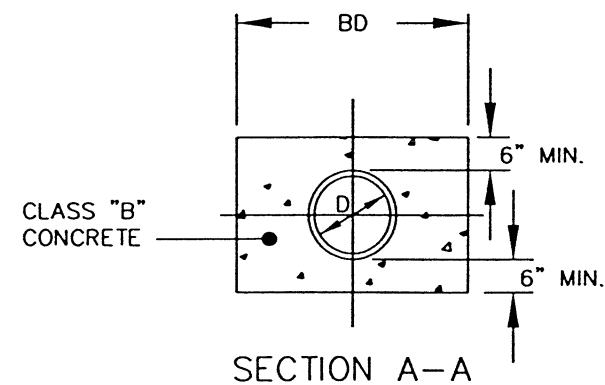


CITY OF CHATTANOOGA AND HAMILTON COUNTY			
CREEK AND DITCH CROSSINGS FOR SANITARY SEWERS			
DATE OF ORIGINAL ISSUE		STANDARD NUMBER: SD-305.01	
0	INITIAL ISSUE	12/10/99	DECEMBER 10, 1999
NO.	REVISION	DATE	

F:\STDDWGS\StdCheckDam-County\CheckDam-County.dwg

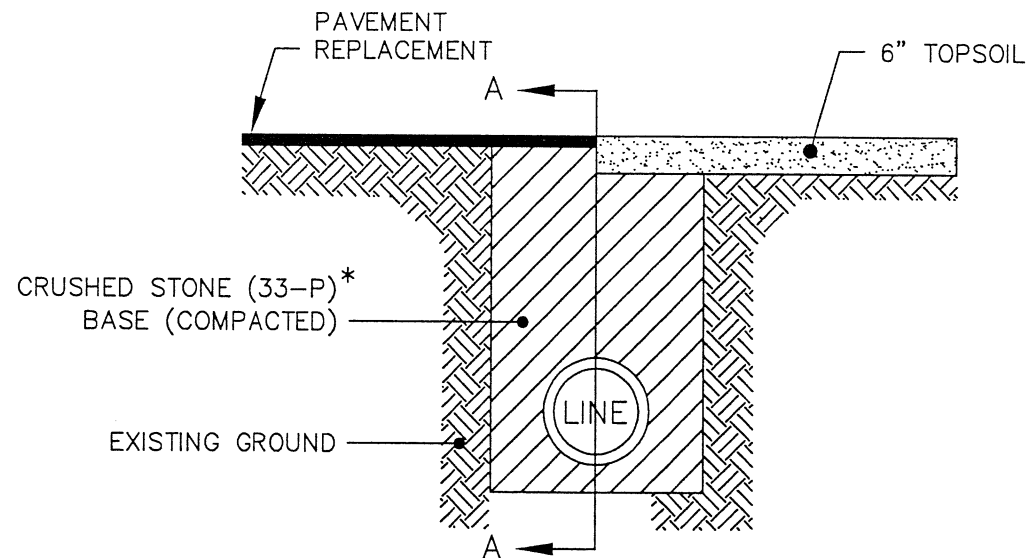

END VIEW
(SPLIT SECTION)


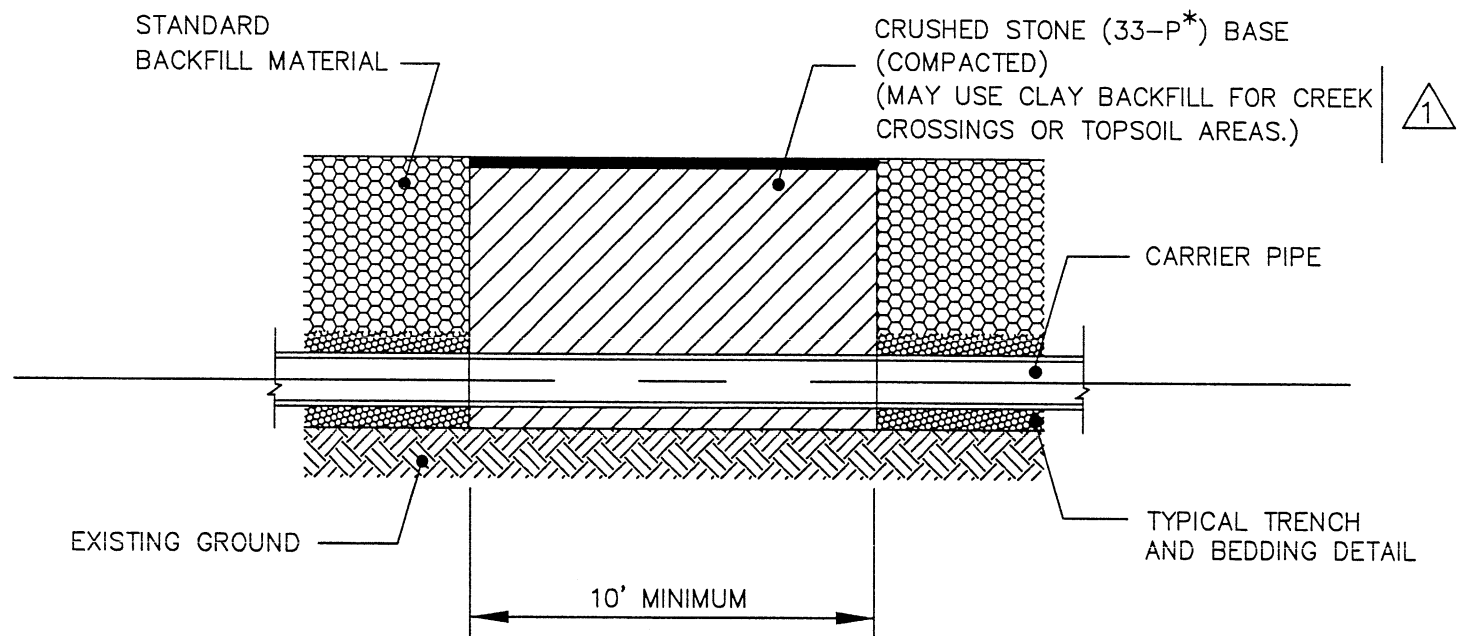


SECTION A-A

* "33-P (PUG)" - 303-01, TYPE A, GRADING D
("33-P"), TENNESSEE D.O.T. SPECIFICATIONS.

NOTE

A CHECK DAM SHALL BE LOCATED EVERY 500'
ALONG THE TRENCH UNLESS SHOWN OTHERWISE
ON THE PLANS.

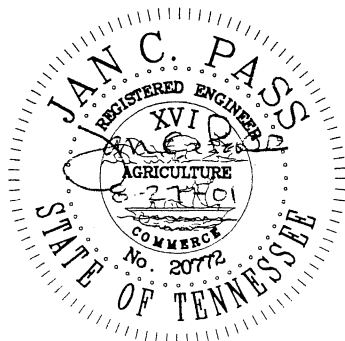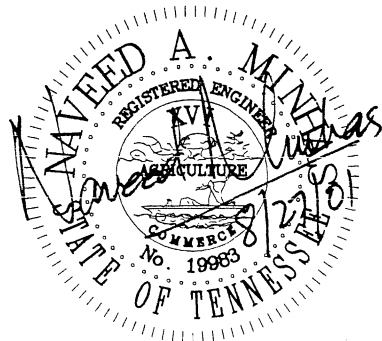

1	REVISIONS AS MARKED OR CLOUDED	8/24/01
0	INITIAL ISSUE	12/10/99
NO.	REVISION	DATE

CITY OF CHATTANOOGA AND HAMILTON COUNTY
TRENCH CHECK DAM

DATE OF ORIGINAL ISSUE
DECEMBER 10, 1999

STANDARD NUMBER : SD-306.01

PIPE DIAMETER "D" (INCHES)	TRENCH WIDTH "BD" (FEET)	TRENCH * VOLUME PER FOOT OF DEPTH	CLASS "C" BEDDING FOR CONCRETE AND DUCTILE IRON		ROCK TRENCH BEDDING	
			QTY. (C.Y.)	"S" IN (IN.)	CONC. & D.I.	PVC, ETC.
6 **	2.00	0.074	0.025	4-1/4	0.025	0.037
8	2.33	0.086	0.030	4-1/2	0.030	0.043
10	2.50	0.093	0.036	5-0	0.049	0.062
12	2.67	0.099	0.039	5-1/4	0.054	0.066
15	3.00	0.111	0.046	5-3/4	0.063	0.074
18	3.25	0.120	0.053	6-1/4	0.069	0.080
24	3.83	0.142	0.072	7-1/2	0.108	0.118
30	4.42	0.164	0.098	9-0	0.121	0.137
36	5.67	0.210	0.148	10-1/2	0.194	-----
42	6.25	0.231	0.184	12-0	0.209	-----
48	6.83	0.253	0.223	13-1/2	0.223	-----
54	7.42	0.275	0.226	15-0	0.236	-----
60	8.00	0.296	0.312	16-1/2	0.247	-----
66	8.58	0.318	0.362	18-0	0.258	-----
72	9.17	0.340	0.416	19-1/2	0.268	-----
78	9.75	0.361	0.458	20-1/2	0.291	-----
84	10.33	0.383	0.510	21-3/4	0.315	-----
96	11.50	0.426	0.604	23-3/4	0.365	-----

* ALL VOLUMES IN CUBIC YARDS/LINEAR FOOT.

** QUANTITIES AND DIMENSIONS FOR 6" SERVICE LINE SHALL APPLY TO 4" SERVICE LINE ALSO.

QUANTITIES FOR CLASS "B" AND ROCK TRENCH BEDDING ARE THE QUANTITIES IN EXCESS OF THOSE REQUIRED FOR CLASS "C" BEDDING.

SCHEDULE OF BEDDING

PIPE DIAMETER "D" (INCHES)	TRENCH WIDTH TOP OF PIPE "BD" (FT.)	CONCRETE PIPE C-76 CLASS III	CONCRETE PIPE C-76 CL. IV AWWA C-301 D.I.P.	PVC D-3034 AND ASTM F679
CLASS "C" BEDDING (STANDARD BEDDING)				
4"	2.00	---	---	NL
6"	2.00	---	---	NL
8"	2.33	---	---	NL
10"	2.50	---	---	NL
12"	2.67	---	13	NL
15"	3.00	---	12	NL
18"	3.25	---	13	NL
21"	3.54	---	14	NL
24"	3.83	---	15	
27"	4.08	11	15	
30"	4.42	11	16	
33"	4.75	11	16	
36"	5.67	10	14	
42"	6.25	11	16	
48"	6.83	12	17	
54"	7.42	13	18	
60"	8.00	13	18	
66"	8.58	14	19	
72"	9.17	15	20	
78"	9.75	16	21	
84"	10.33	16	21	
90"				

NL=NO LIMIT TO BOTTOM OF PIPE

BD=MAXIMUM TRENCH WIDTH AT 12" ABOVE TOP OF PIPE. IF DITCH IS CUT WIDER THAN BD SHOWN, THE CONTRACTOR, AT HIS OWN EXPENCE, WILL BE REQUIRED TO INCREASE BEDDING TO COMPENSATE FOR ADDITIONAL LOAD ON THE PIPE.

(PERMISSIBLE DEPTH (IN FEET) TO BOTTOM OF PIPE FOR SATURATED CLAY EARTH LOAD, 130 LBS./CU. FT. (SATURATED CLAY).)

NOTES

STANDARD BEDDING

MATERIAL SHALL BE PLACED AS SHOWN BY THE STANDARD DETAILS FOR THE TYPE OF PIPE USED. THE BEDDING SHALL BE INCLUDED FOR PAYMENT IN THE UNIT PRICE BID PER LINEAR FOOT OF PIPE FOR VARIOUS TYPES, SIZES, AND DEPTHS LISTED IN THE BID SCHEDULE.


CLASS "B" BEDDING MATERIAL (SECTION 204.04, TENNESSEE D.O.T. SPECIFICATIONS)- MATERIAL FOR CLASS "B" BEDDING FOR PIPE CULVERTS SHALL CONSIST OF SAND OR A NATURAL SANDY SOIL, ALL OF WHICH PASSES A 3/8-INCH SIEVE AND NOT MORE THAN TEN PERCENT PASSES A NO. 200 SIEVE; OR STONE, GRAVEL, CHERT, OR SLAG MEETING THE GRADING REQUIREMENTS FOR EITHER GRADING C, D, OR E OF SUBSECTION 903.05.

IN ROCK CUTS OR OTHER AREAS DESIGNATED BY THE ENGINEER WHERE A FREE DRAINAGE BEDDING OR BACKFILL MATERIAL IS REQUIRED, THE MATERIAL SHALL BE CRUSHED STONE, CRUSHED SLAG, OR WASHED GRAVEL MEETING THE REQUIREMENTS OF SUBSECTION 903.17.

PVC PIPE BEDDING MATERIAL-NO. 7 WASHED STONE (SECTION 903.22, TENNESSEE D.O.T. SPECIFICATIONS).

ROCK TRENCH BEDDING


MATERIAL SHALL BE SAME AS FOR CLASS "B" BEDDING AND SHALL BE PLACED AS SHOWN BY THE STANDARD DETAILS FOR THE TYPE OF PIPE USED. QUANTITIES FOR THE ROCK TRENCH BEDDING ARE THE AMOUNTS IN EXCESS OF THOSE REQUIRED FOR CLASS "C" BEDDING.

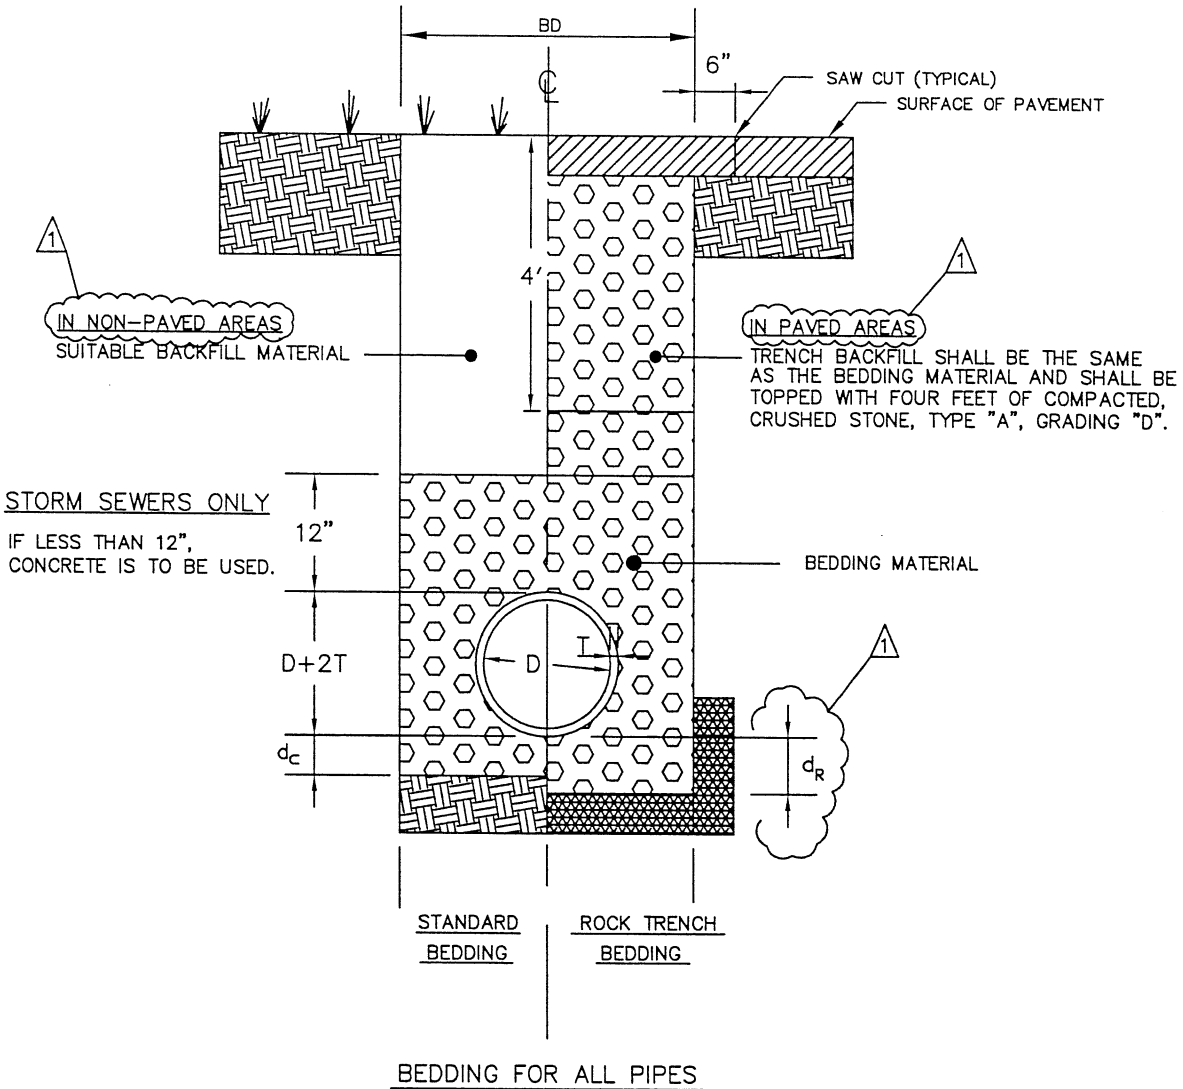

TRENCH DETAILS


D	d _C	d _R
8" AND LESS	6"	10"
10" TO 18"	8"	12"
20" TO 30"	10"	14"
32" AND LARGER	12"	16"

F:\STDDWGS\TrenchDetails\STDTRNCH.dwg

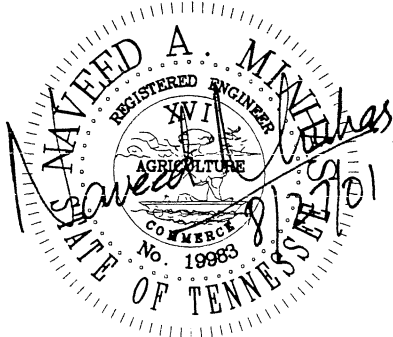

CITY OF CHATTANOOGA AND HAMILTON COUNTY			
TRENCH DETAILS AND BEDDING (STORM/SANITARY SEWERS)			
1	REVISIONS AS MARKED OR CLOUDED	8/24/01	DATE OF ORIGINAL ISSUE
0	INITIAL ISSUE	12/10/99	DECEMBER 10, 1999
NO.	REVISION	DATE	STANDARD NUMBER: SD-307.01

F:\STDDWG\TrenchDetails-County-TrenchDetails-County-Combined(concrete)_1.dwg

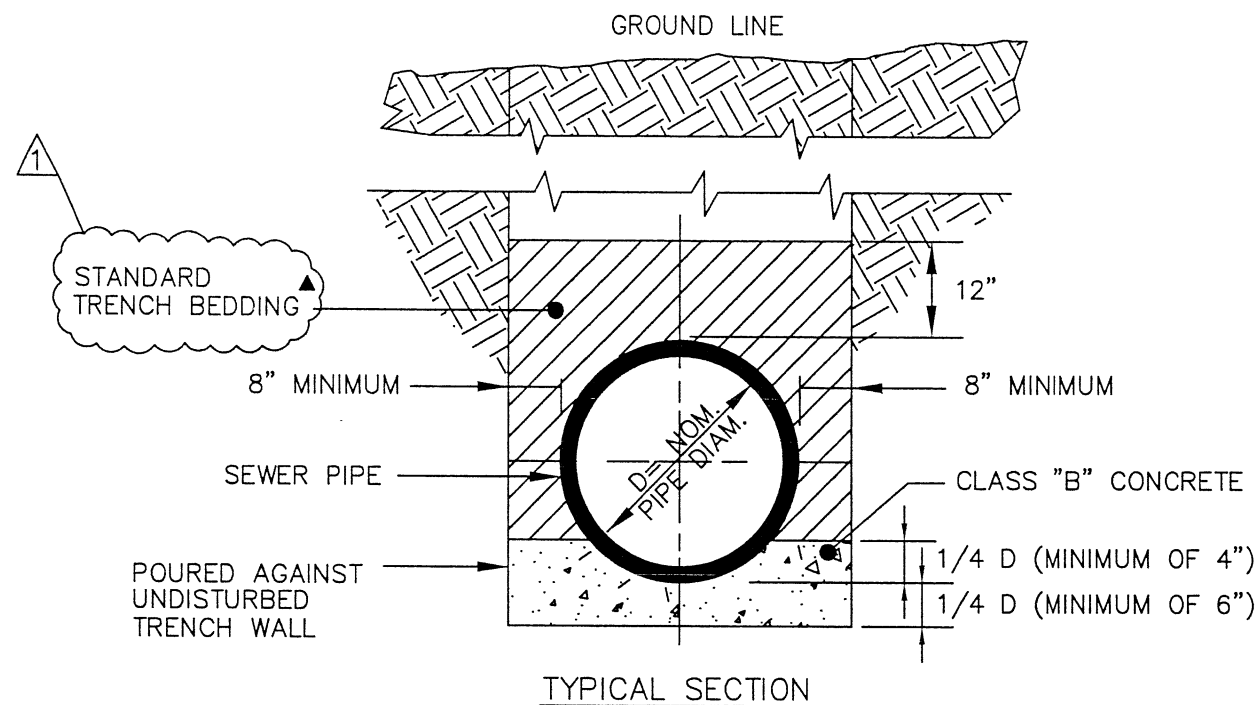


CONCRETE CRADLE

NOTES

1. CLASS "B" CONCRETE IS TO BE POURED 16 HOURS BEFORE PLACING BACKFILL, AND IN A MANNER THAT PREVENTS THE FLOATING OF PIPES.
2. PIPES ARE TO BE LAID BEFORE THE CONCRETE HARDENS.

▲ 3. SEE STANDARD DRAWING SD-307.01.


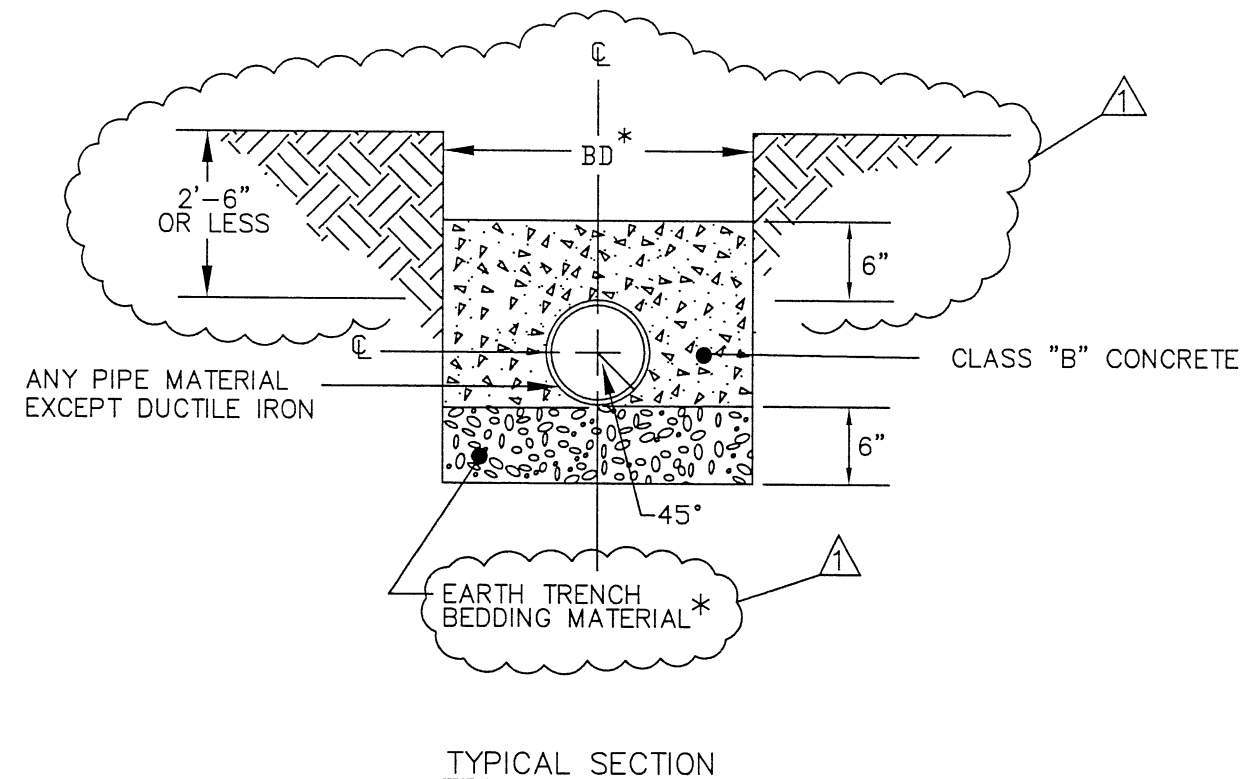


CONCRETE CAP FOR SHALLOW PIPE

NOTES


1. CLASS "B" CONCRETE IS TO BE POURED 36 HOURS BEFORE PLACING BACKFILL, AND IN A MANNER THAT PREVENTS THE FLOATING OF PIPES.
2. CONCRETE ENCASEMENT IS REQUIRED FOR DITCHES AND CREEKS WHERE THE COVER IS 2'-6" OR LESS.

▲ * 3. SEE STANDARD DRAWING SD-307.01.

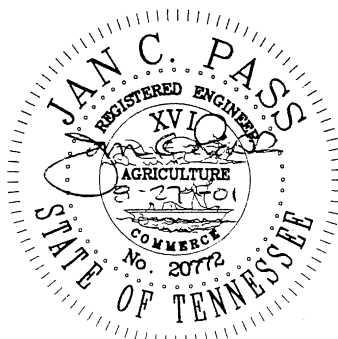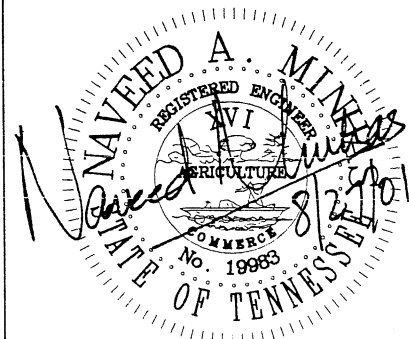


NO.	REVISION	DATE
1	REVISIONS AS MARKED OR CLOUDED	8/24/01
0	INITIAL ISSUE	12/10/99

CITY OF CHATTANOOGA AND HAMILTON COUNTY	
TRENCH DETAILS (CONCRETE PROTECTION)	
DATE OF ORIGINAL ISSUE DECEMBER 10, 1999	STANDARD NUMBER : SD-308.01

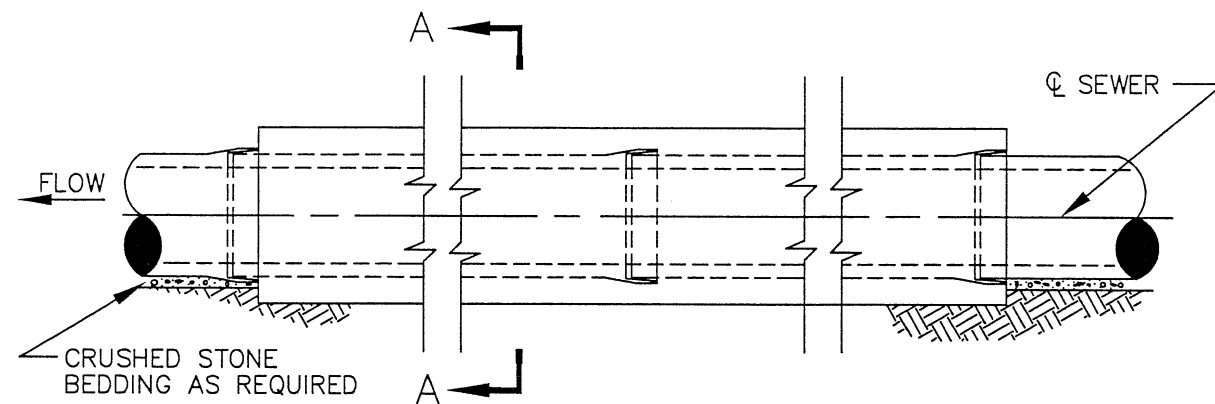


ELEVATION


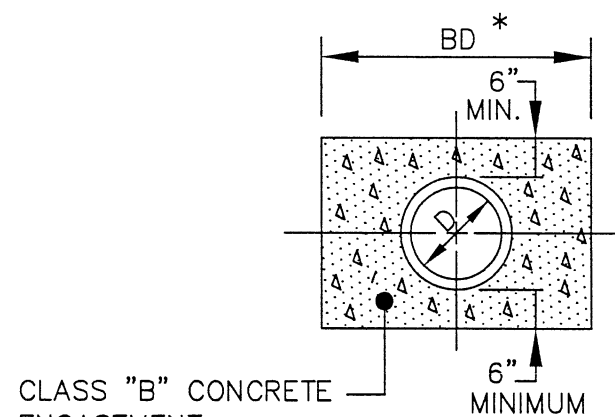


SECTION A-A

BD*—SEE STANDARD
SD-307.01.

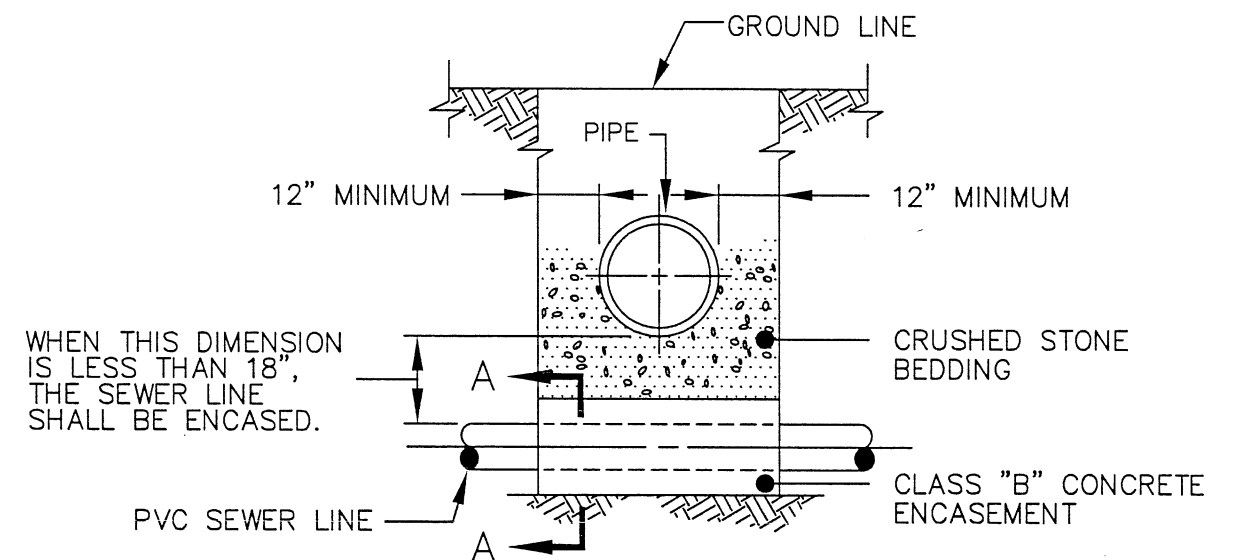

CONCRETE ENCASEMENT

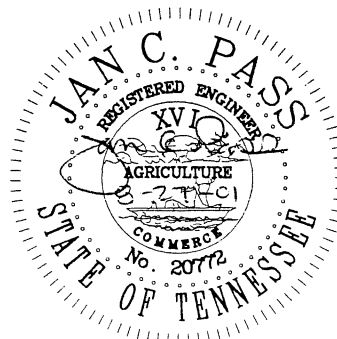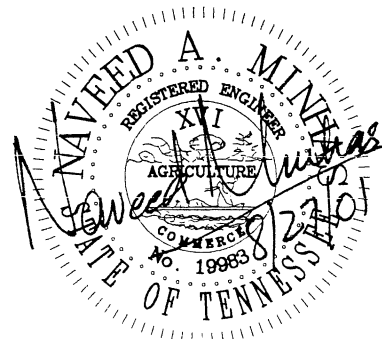


1	DELETED TABLE	8/24/01
0	INITIAL ISSUE	12/10/99
NO.	REVISION	DATE

CITY OF CHATTANOOGA AND HAMILTON COUNTY TRENCH DETAILS (CONCRETE PROTECTION)



DATE OF ORIGINAL ISSUE
DECEMBER 10, 1999

STANDARD NUMBER : SD-308.02

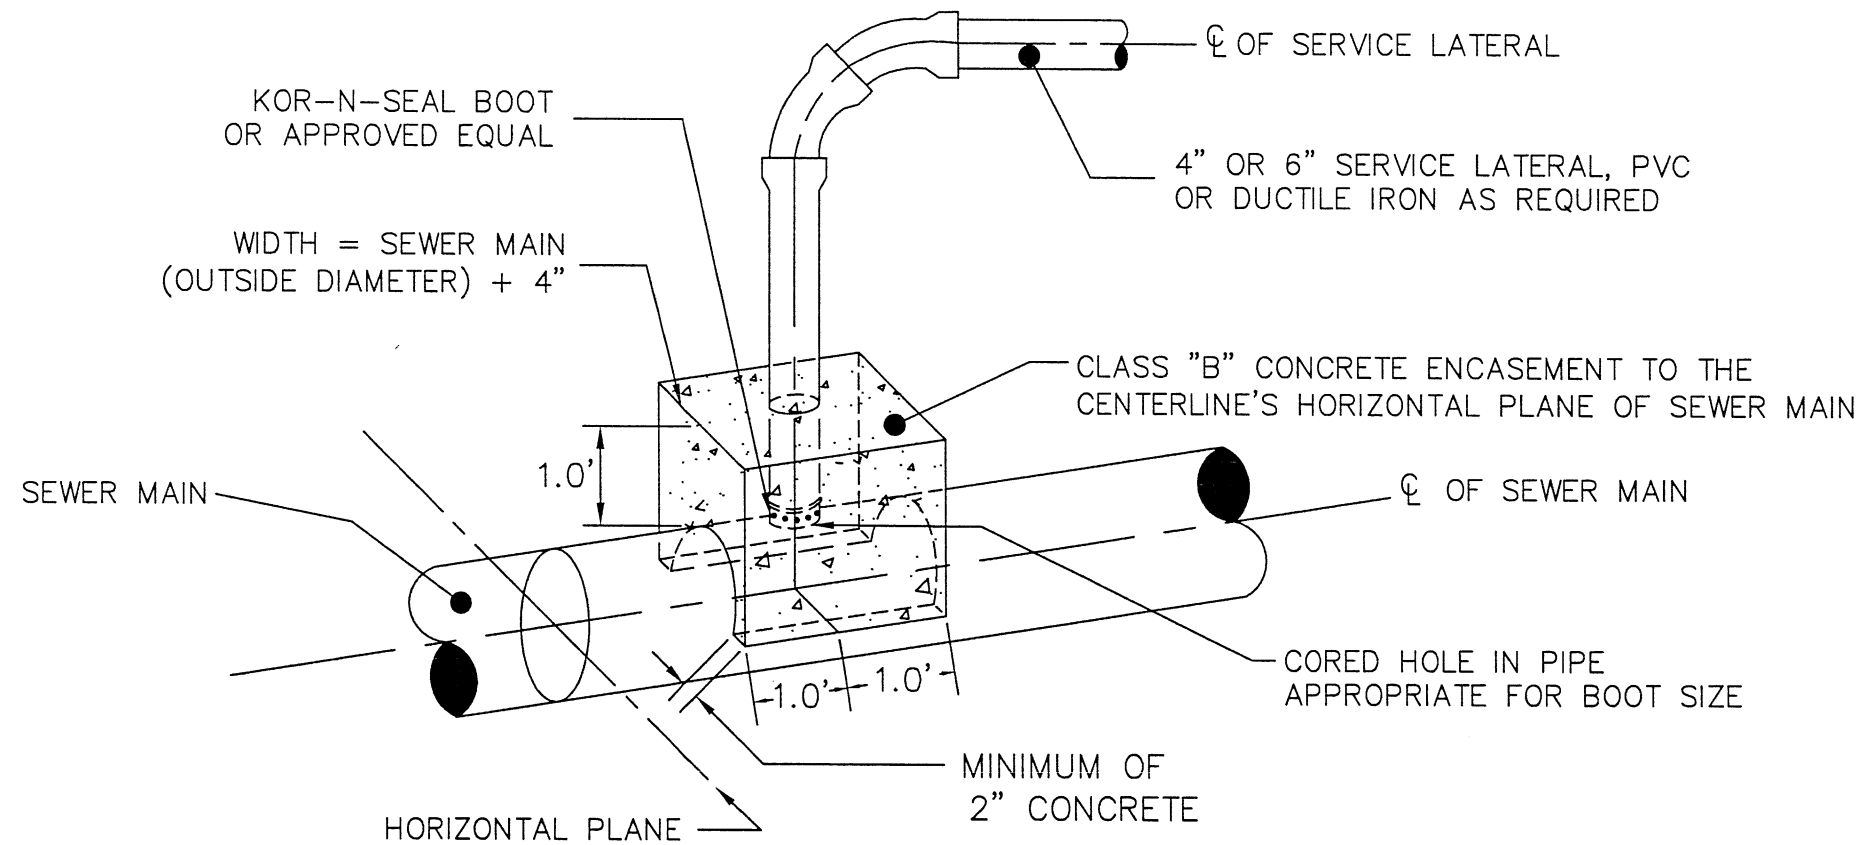


NOTE

ALL SUCH CONNECTIONS TO
PIPES 15" OR LARGER MUST
HAVE PRIOR APPROVAL BY CITY.

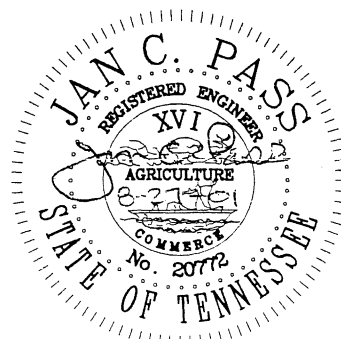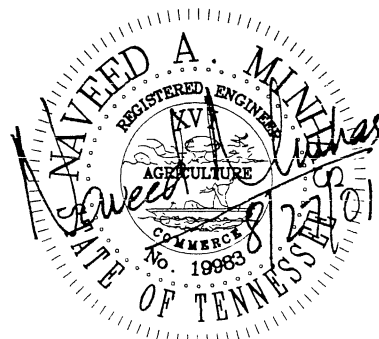


			CITY OF CHATTANOOGA AND HAMILTON COUNTY	
			SEWER SERVICE TAP (15" OR LARGER SEWER MAIN)	
			DATE OF ORIGINAL ISSUE	STANDARD NUMBER : SD-309.01
0	INITIAL ISSUE	8/24/01	AUGUST 24, 2001	
NO.	REVISION	DATE		

F:\STDDWG\OilSkimmer\Oil Skimming Baffle.dwg

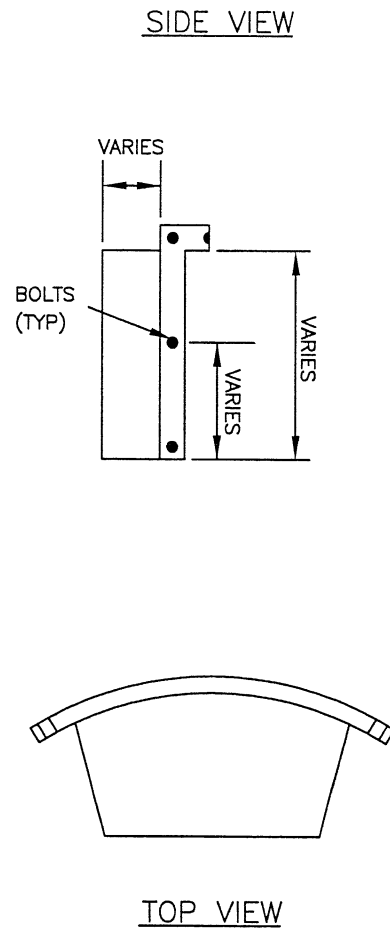

BAFFLE

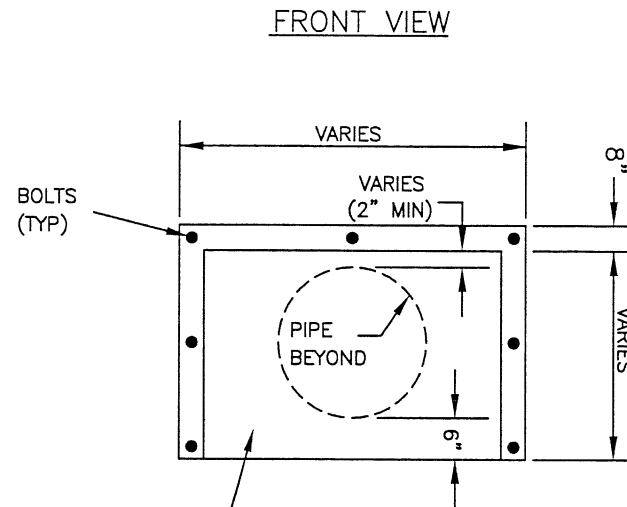


APPROVED FIBERGLASS (OR 1/4" A36 GALVANIZED STEEL PLATE) WITH CONTINUOUS WELDS, SECURED TO WALLS WITH 1/2" X 2" ANCHOR BOLTS. ALL BOLTS TO BE ZINC COATED IN ACCORDANCE WITH A.S.T.M. BS33 SCI TYPE 111.


NOTES

1. ALL MATERIAL, DESIGN, MANUFACTURE, PHYSICAL TEST REQUIREMENTS, FINISH MARKING, INSPECTION, REJECTION, AND REPAIRS SHALL MEET TENTATIVE SPECIFICATIONS FOR PRECAST, REINFORCED CONCRETE MANHOLE RISERS AND TOPS PER A.S.T.M.-C478 LATEST REVISIONS.
2. PLASTIC STEPS SHALL BE PLACED IN LINE ON 16" CENTERS.
3. FOR USE IN COMBINED SEWER AREAS AS AN ODOR TRAP OR AS DIRECTED/REQUIRED.
4. MAY BE USED IN MANHOLES AND CATCH BASINS.


TYPICAL CURB INLET TOP

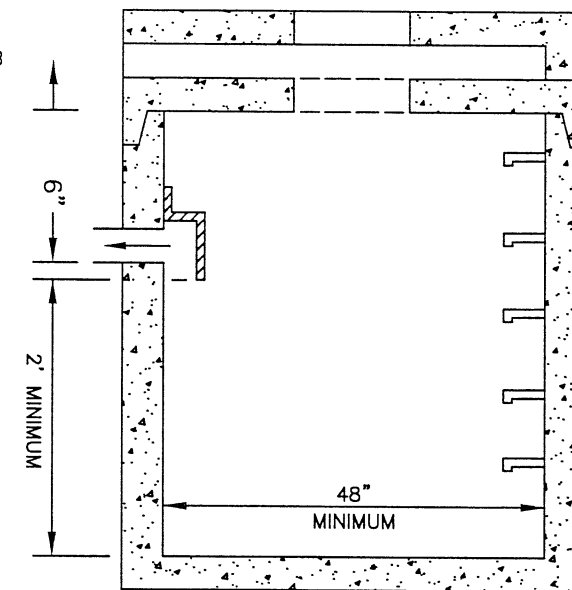

SECTION - CURB INLET

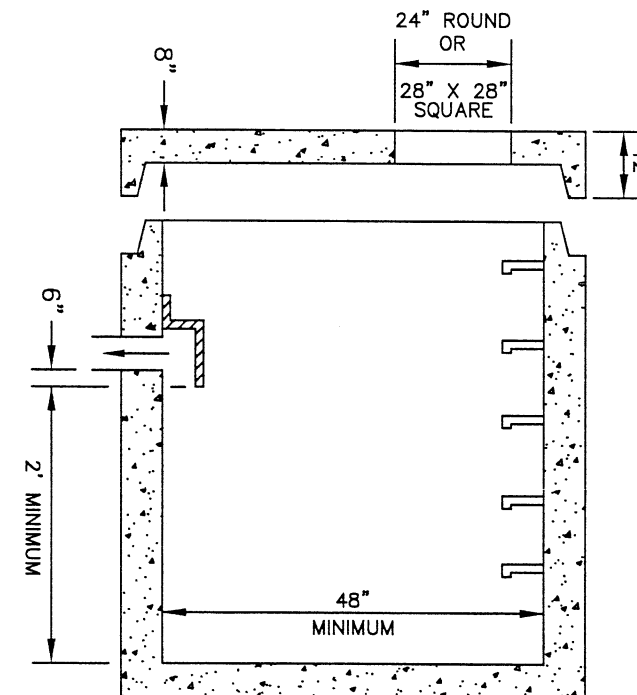

SECTION - FLAT TOP

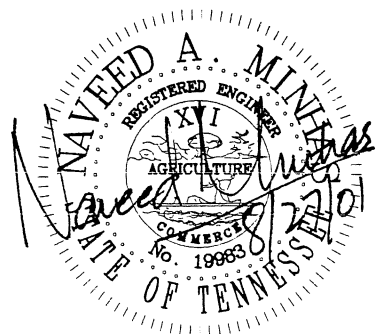

CITY OF CHATTANOOGA AND HAMILTON COUNTY


OIL SKIMMER

0	INITIAL ISSUE	8/24/01
NO.	REVISION	DATE


DATE OF ORIGINAL ISSUE
AUGUST 24, 2001

STANDARD NUMBER: SD-310.01


STREETSCAPE

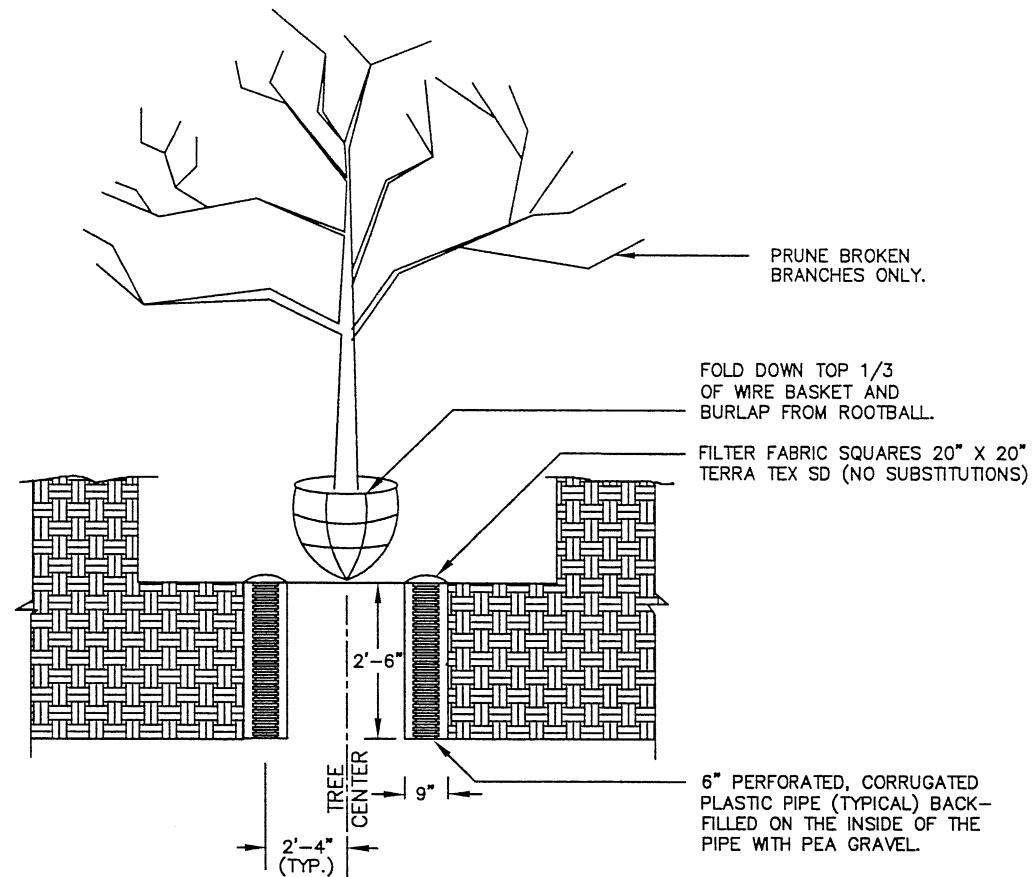


PLANTER DRAIN DETAIL

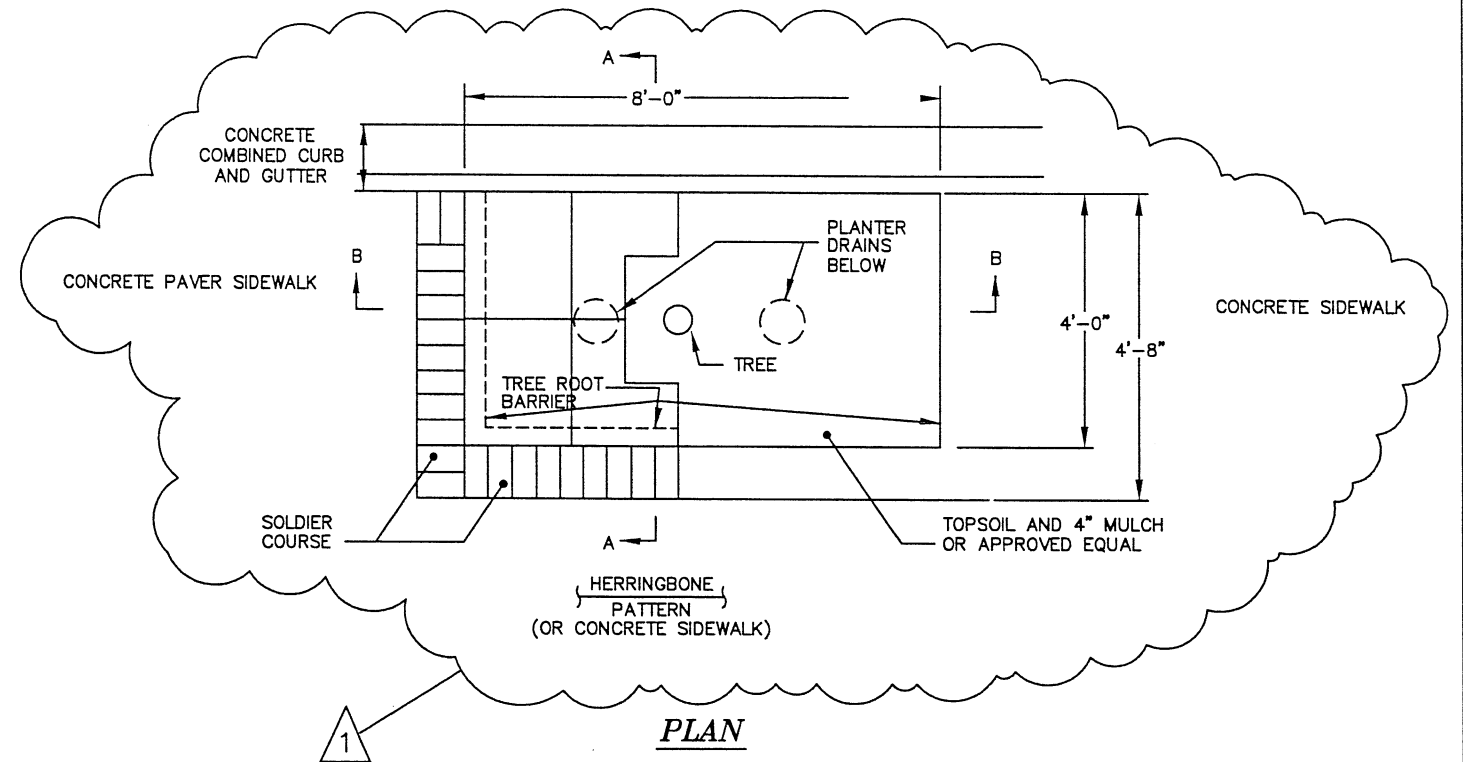


PLAN

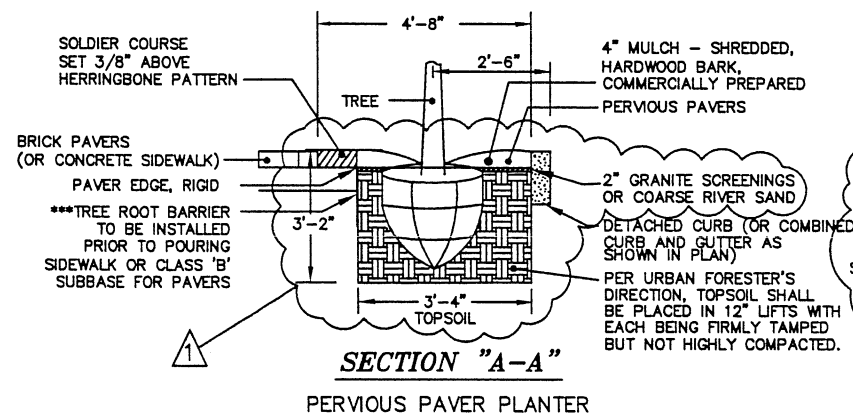


SECTION "A-A"
PERVIOUS PAVER PLANTER

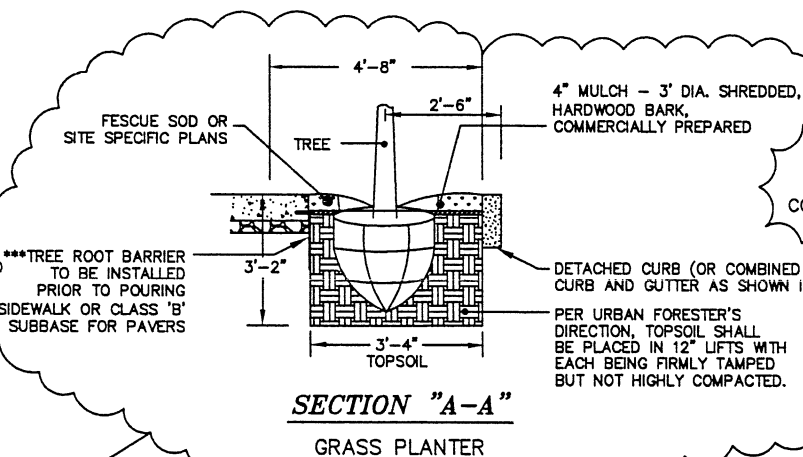

SECTION "A-A"
GRASS PLANTER

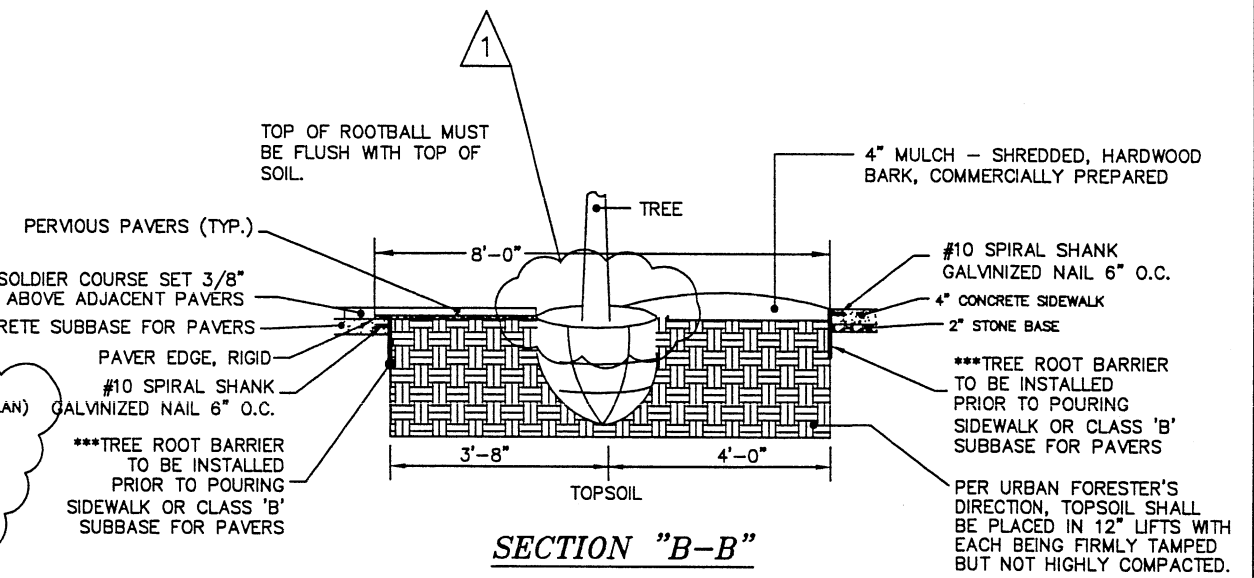

SECTION "B-B"

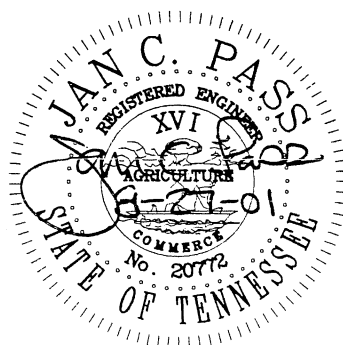

1	REVISIONS AS MARKED OR CLOUDED	8/24/01
0	INITIAL ISSUE	12/10/99
NO.	REVISION	DATE

CITY OF CHATTANOOGA AND HAMILTON COUNTY

TREEWELL DETAILS

DATE OF ORIGINAL ISSUE
DECEMBER 10, 1999

STANDARD NUMBER: **SD-500.01**

GENERAL NOTES PERTAINING TO EXISTING TREES

JOB CONDITIONS

Protections: Provide protection as required to designated landscape improvements to avoid damage caused by falling building materials or the removal of materials resulting from either construction or demolition operations.

Existing trees and other plantings designated to remain in place, shall be protected from unnecessary cutting, breaking, or skinning of roots; skinning and bruising of bark; smothering of trees by stockpiling materials of any kind within the drip line; and from excess foot or vehicular traffic or parking of vehicles within the drip line. Provide temporary guards to protect trees and plantings to be left standing.

Tree Protection: Install a shield of 1" X 4" wooden planks completely around each tree trunk from ground level to where the trunk begins to "branch out". Attach such protection with 12 gauge galvanized wire around tree trunk at the top, bottom, and middle of the planking.

Tree Pit Protection: Protect tree pits and pit vegetation from falling, sliding, or washing building materials by placing bales of straw around the perimeter of each pit or over the top of the pit as directed by the URBAN FORESTER.

Straw bales shall remain whole and unbroken and have no loose straw that may become scattered around the area.

Tree Repairs: Trees and/or vegetation that have been designated to remain and that have been damaged by demolition operations, are to be replaced or repaired in a manner acceptable to the URBAN FORESTER.

Tree Replacement: "Tree replacement" is defined as the complete excavation of an existing tree and its root system and the subsequent planting, back-filling, and adequate fertilization and watering of its replacement tree for a period of one year after planting.

The CONTRACTOR shall, at his own expense, replace trees that cannot be repaired and restored to a healthy status, as determined by the URBAN FORESTER. Replacement trees shall be in good health and shall be equal in species, height, shape, and caliper to the tree(s) being replaced.

GENERAL NOTES PERTAINING TO PROPOSED TREES

No tree shall be placed until the URBAN FORESTER has inspected and accepted it.

△ The tree shall be placed in the pit so that the top of the rootball is at approximately the same level as the surrounding soil.

The top 1/3 of the wire basket and the burlap around the rootball shall each be folded down.

All rope, trunk wrap, and other restrictive materials shall be removed at the time of planting.

No staking shall be permitted unless there is a demonstrated need approved by the URBAN FORESTER (Examples: windy sites, sandy soils, or a need to reduce vandalism). All staking materials including hose, straps, wire, and stakes shall be removed twelve (12) months after installation of the tree.

Only broken or crossing branches may be removed at the time of planting.


After a tree has been installed, the tree pit should be backfilled in 12" lifts of approved topsoil with each lift being firmly tamped but not highly compacted. Acceptable firmness may be attained with the use of a roller no heavier than 200 pounds and with at least two passes (perpendicular) of the roller.

Four inches (4") of shredded, hardwood bark mulch, commercially prepared, shall be placed over the top of the rootball of each newly installed tree.

TOPSOIL SPECIFICATIONS


This material shall be native topsoil, natural and fertile, and shall be either screened or void of roots, large rocks, and rootballs of plants, especially Johnson grass. Any soil with high clay content or a pH higher than 7.0 shall be rejected. A small volume of soil, approximately one pint, shall be submitted to the URBAN FORESTER for inspection and approval before use in the planting pits. Soil ammendment recommendations shall be made based on the lab analysis of the soil sample. (Preferred blend is "HydeMix" available from Agricultural Distributors, Inc., or approved equal.)

△

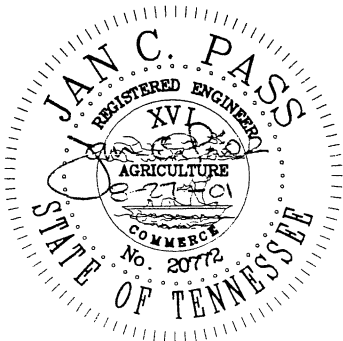


			CITY OF CHATTANOOGA AND HAMILTON COUNTY	
			TREEWELL DETAILS	
1	REVISIONS AS MARKED OR CLOUDED	8/24/01	DATE OF ORIGINAL ISSUE	STANDARD NUMBER : SD-500.02
0	INITIAL ISSUE	12/10/99	DECEMBER 10, 1999	
NO.	REVISION	DATE		


F:\STDDWG\PAVER\STYP PAVR LAYOUT_1.dwg

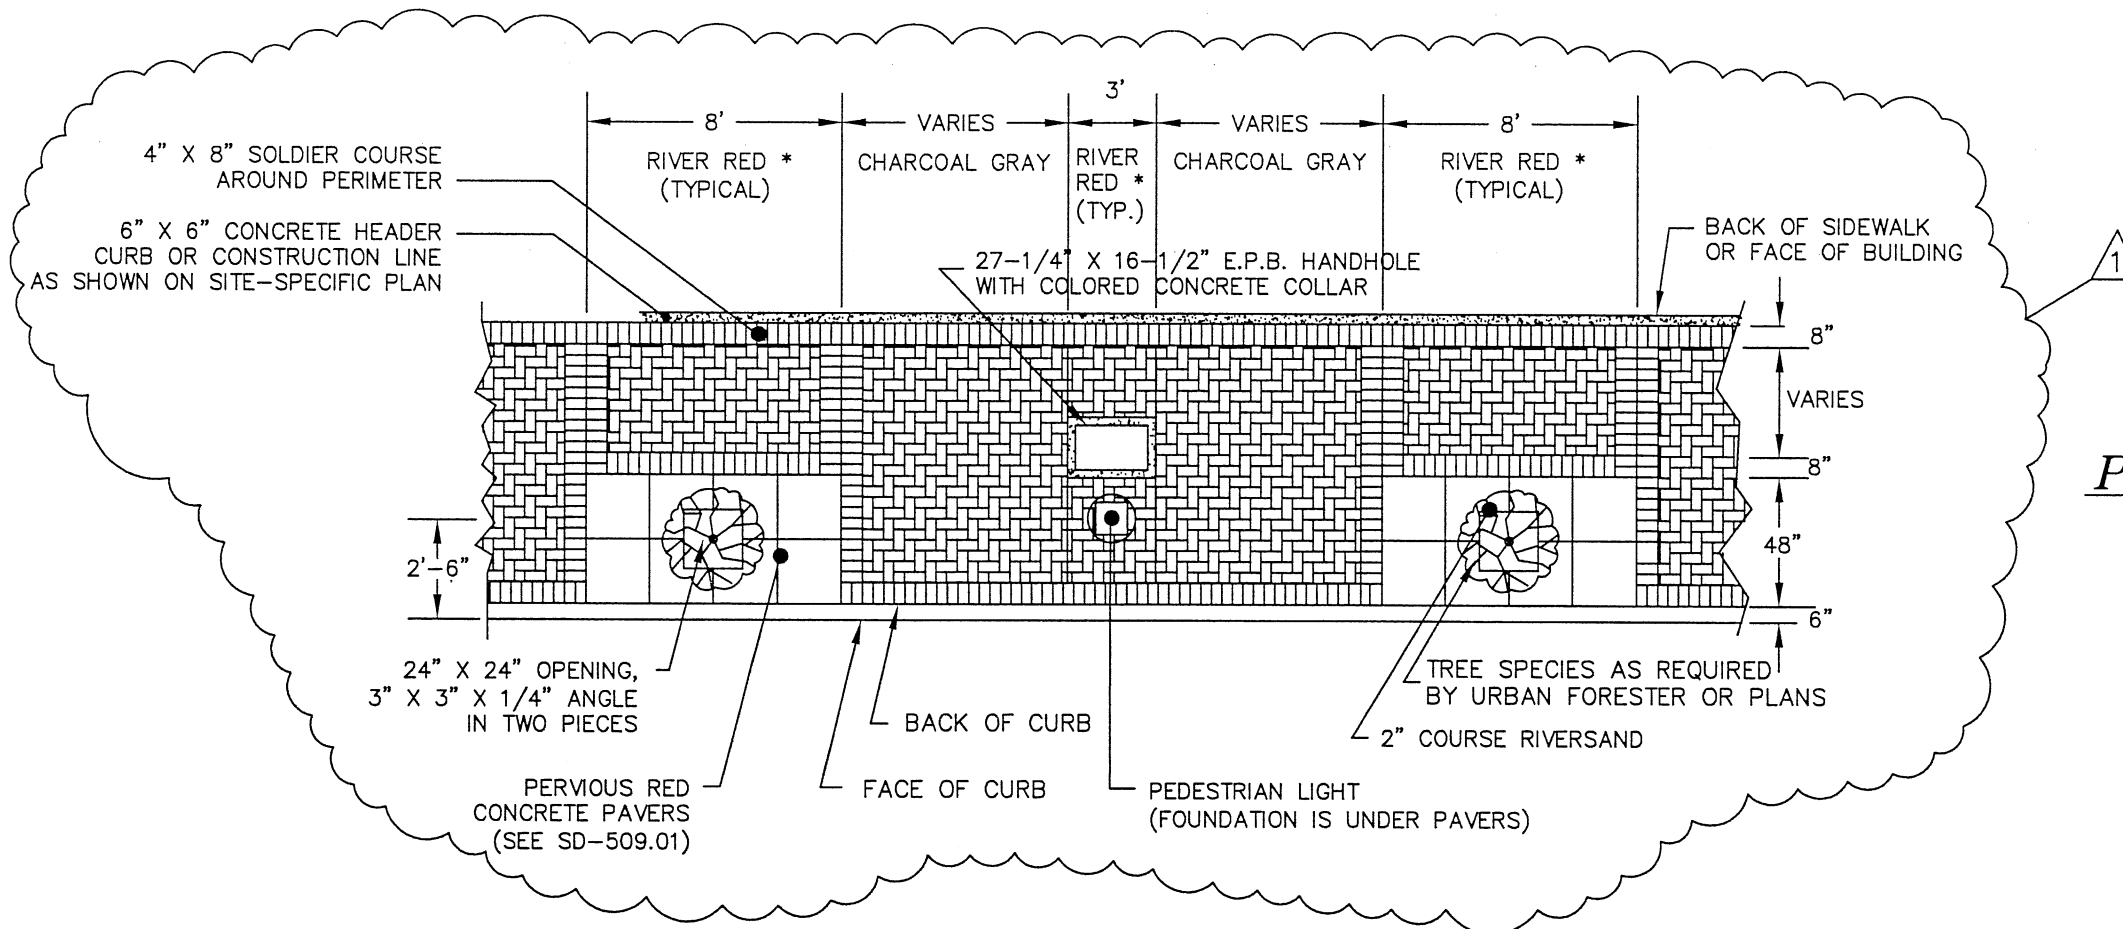

PAVER LAYOUT DETAIL



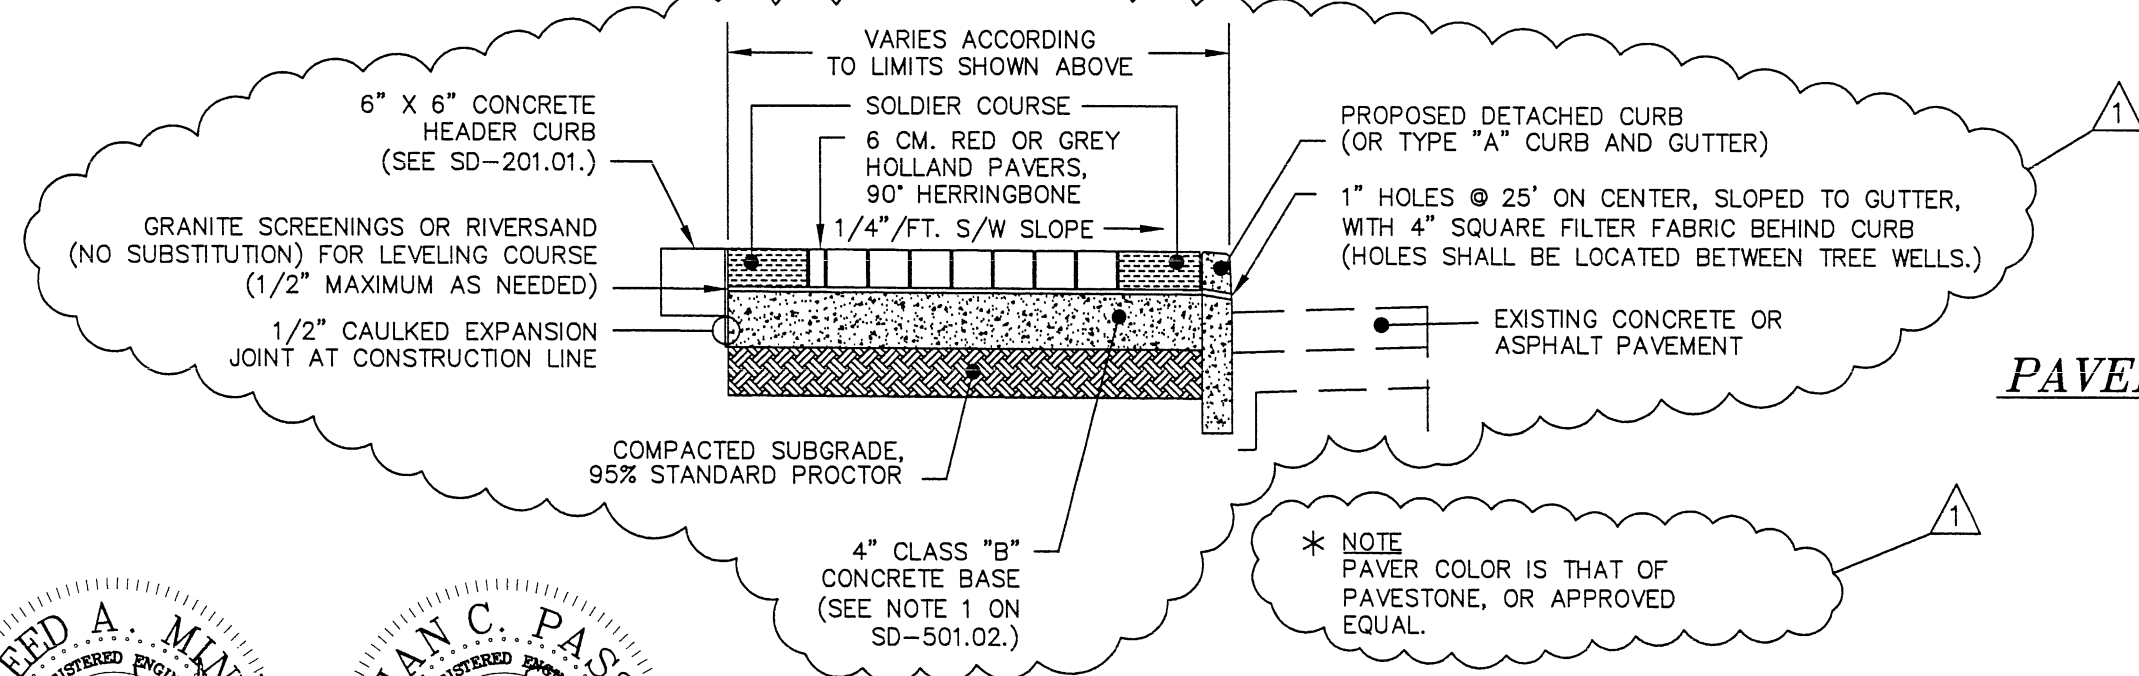


PAVER SIDEWALK DETAIL

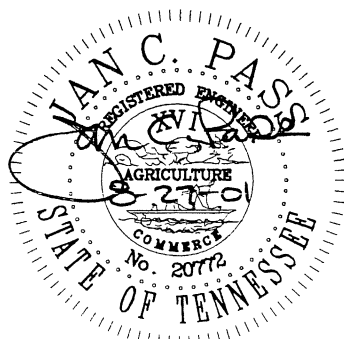



CITY OF CHATTANOOGA AND HAMILTON COUNTY			
PAVER LAYOUT			
1	REVISIONS AS MARKED OR CLOUDED	8/24/01	DATE OF ORIGINAL ISSUE DECEMBER 10, 1999
0	INITIAL ISSUE	12/10/99	
NO.	REVISION	DATE	STANDARD NUMBER: SD-501.01

F:\STDDWG\PAVERS\TYP PAVR LAYOUT_2.dwg

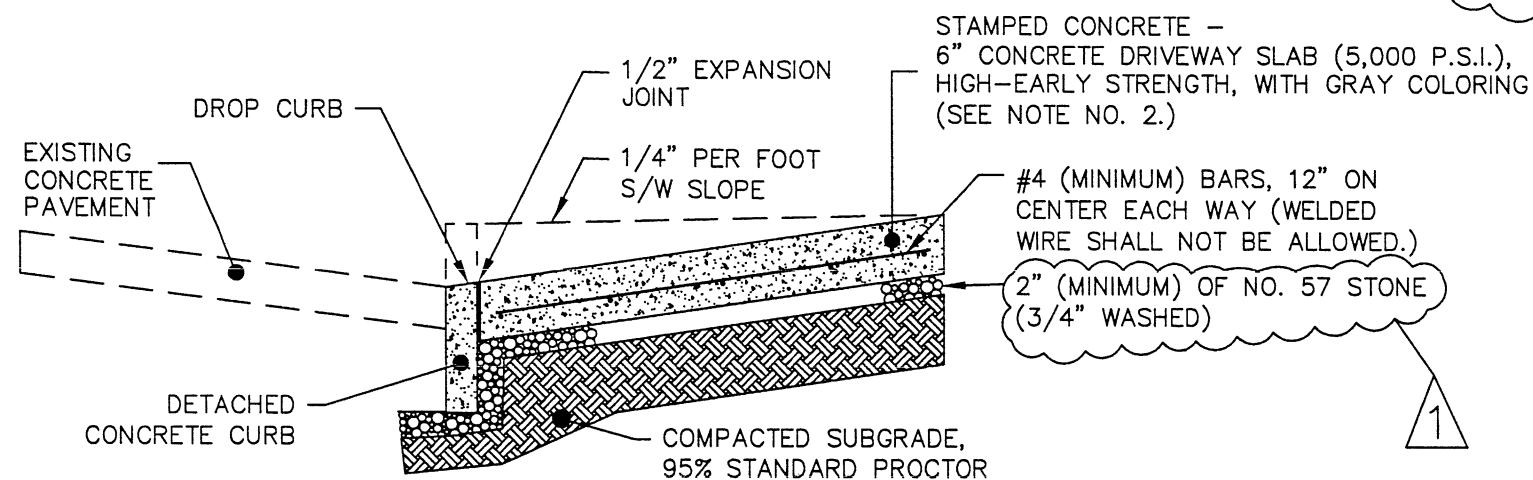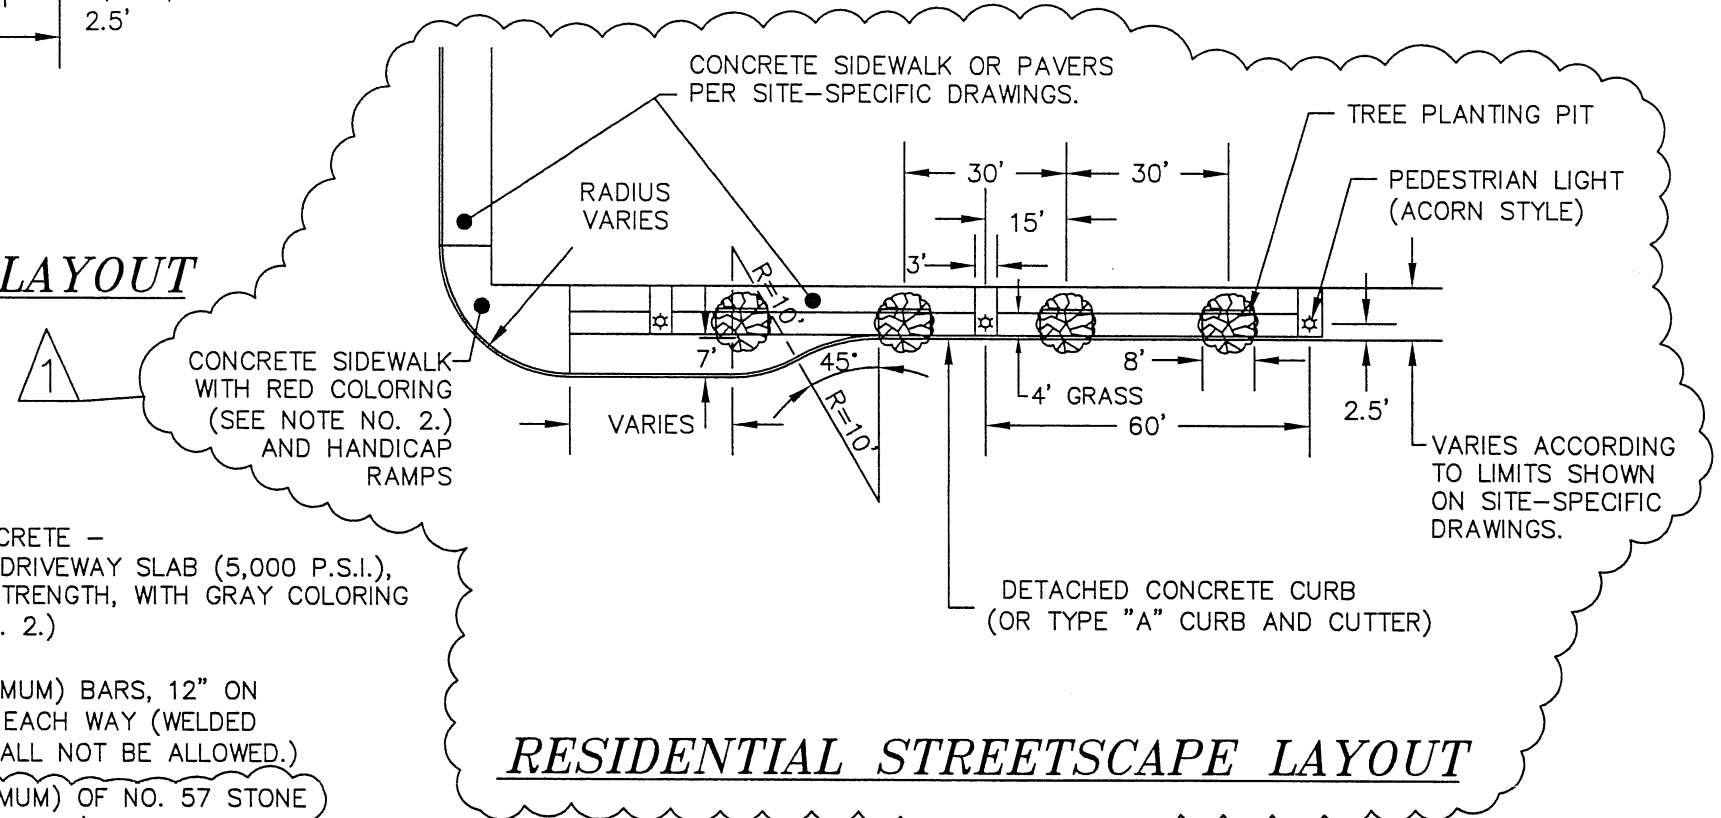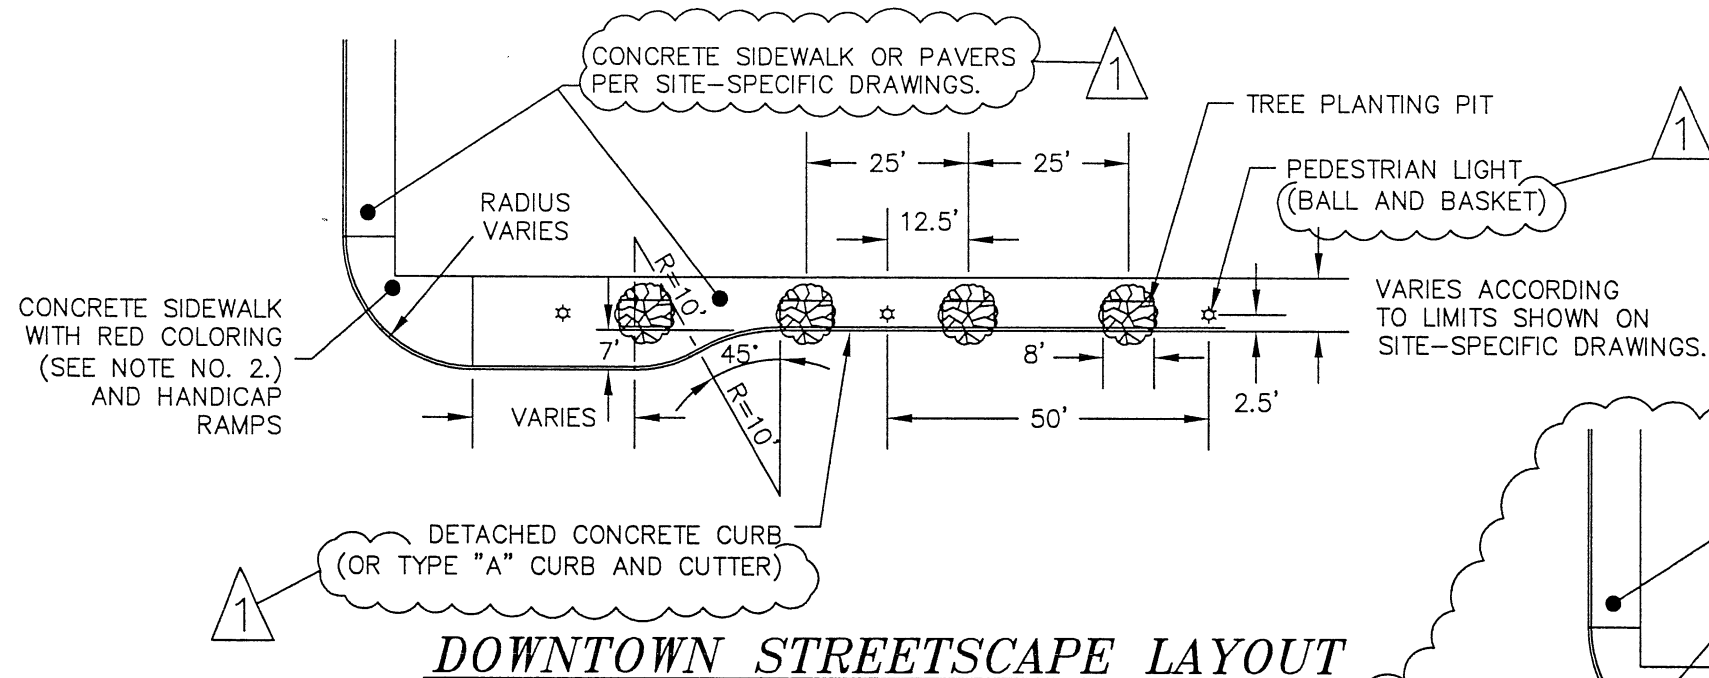

NOTES

1. ALL SECTIONS OF THE APPROPRIATE SPECIFICATION SHALL APPLY, INCLUDING THOSE FOR CONSTRUCTION AND EXPANSION JOINTS, EXCEPT THAT CLASS "B" CONCRETE SHALL BE USED FOR A 4" CONCRETE BASE UNDER THE PAVERS.
2. ALL PIGMENTATION MATERIAL SHALL BE ACCORDING TO THE CONCRETE COLOR CHART ON STANDARD DRAWING NO. SD-503.01. CONTRACTOR MAY USE AN EQUIVALENT PIGMENTATION ONLY WITH GOVERNMENTAL ENGINEER'S APPROVAL.

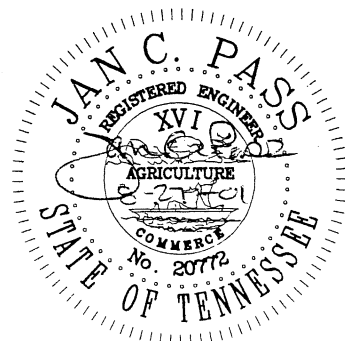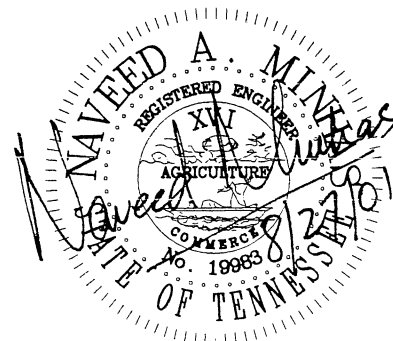

1	REVISIONS AS MARKED OR CLOUDED	8/24/01
0	INITIAL ISSUE	12/10/99
NO.	REVISION	DATE

CITY OF CHATTANOOGA AND HAMILTON COUNTY
PAVER LAYOUT

DATE OF ORIGINAL ISSUE
DECEMBER 10, 1999


STANDARD NUMBER : **SD-501.02**

F:\STDWGS\utilcwr\utilcwr.dwg Wed Dec 08 16:34:46 1999 STATIONS 24

INSTALL SOLDIER COURSE
AROUND UTILITY COLLAR.

12" MINIMUM
(TYPICAL)
ALL SIDES

CORNER TIE BAR

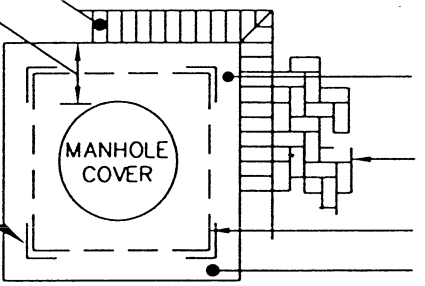

COLORED TO MATCH
ADJACENT CONCRETE
PAVERS OR STAMPING

90° HERRINGBONE
STAMPING

BAR - SEE SECTION BELOW
FOR SIZE AND LOCATION.

CONCRETE COLLAR WITH
COARSE BROOM FINISH

NOTE

FOR COLOR MIX, SEE
CONCRETE COLOR CHART
ON STANDARD DRAWING
SD-503.01.

PLAN

INSTALL SOLDIER COURSE
AROUND UTILITY COLLAR.


90° HERRINGBONE
STAMPING

CORNER TIE BAR

COLORED TO MATCH
ADJACENT CONCRETE
PAVERS OR STAMPING

12" MINIMUM
(TYPICAL)
ALL SIDES

CONCRETE COLLAR WITH
COARSE BROOM FINISH

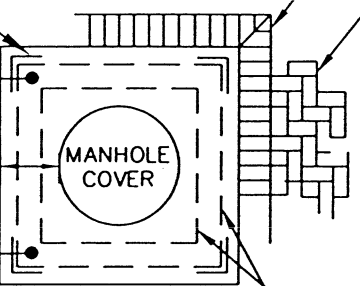

BAR - SEE SECTION BELOW
FOR SIZES AND LOCATIONS.

PLAN

ONE #4 BAR,
2" MINIMUM
CLEARANCE


BRICK PAVERS
(OR CONCRETE
SIDEWALK)

FINISHED ELEVATION OF CONCRETE
COLLAR 1/4" BELOW PAVERS

CONCRETE COLLAR

UTILITY
STRUCTURE WALL

6" MINIMUM
DEPTH ON
ALL SIDES

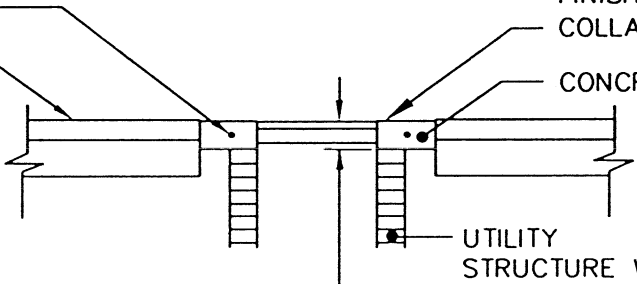

TYPICAL SECTION

UTILITY COLLAR - SIDEWALK

MANHOLE DIAMETER
+ 2' MINIMUM


1/2" EXPANSION JOINT

CONCRETE COLLAR

UTILITY
STRUCTURE WALL

#4 BARS 4" ON CENTER
WITH #2 STIRRUPS

12" MINIMUM
DEPTH ON
ALL SIDES

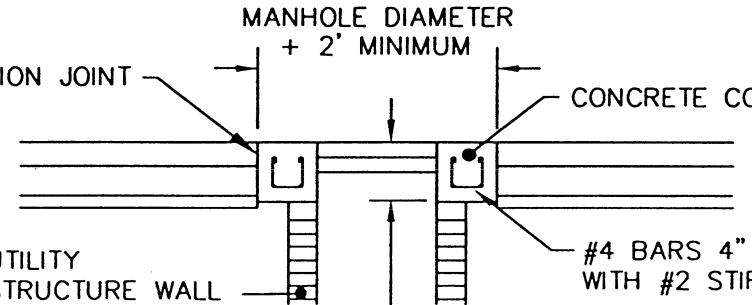


TYPICAL SECTION

UTILITY COLLAR - ROADWAY

NOTES

1. ALL BARS SHALL BE 60 K.S.I.
DEFORMED BARS.
2. CONCRETE UTILITY COLLARS
SHALL BE SQUARE AND AT
RIGHT ANGLES TO THE BRICK
PATTERN.

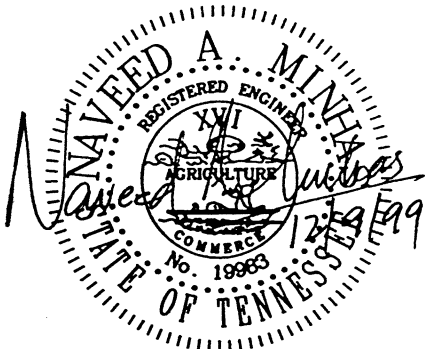


0	INITIAL ISSUE	12/10/99
NO.	REVISION	DATE

CITY OF CHATTANOOGA AND HAMILTON COUNTY


STREETSCAPE UTILITY COLLAR DETAILS

DATE OF ORIGINAL ISSUE
DECEMBER 10, 1999

STANDARD NUMBER: **SD-502.01**

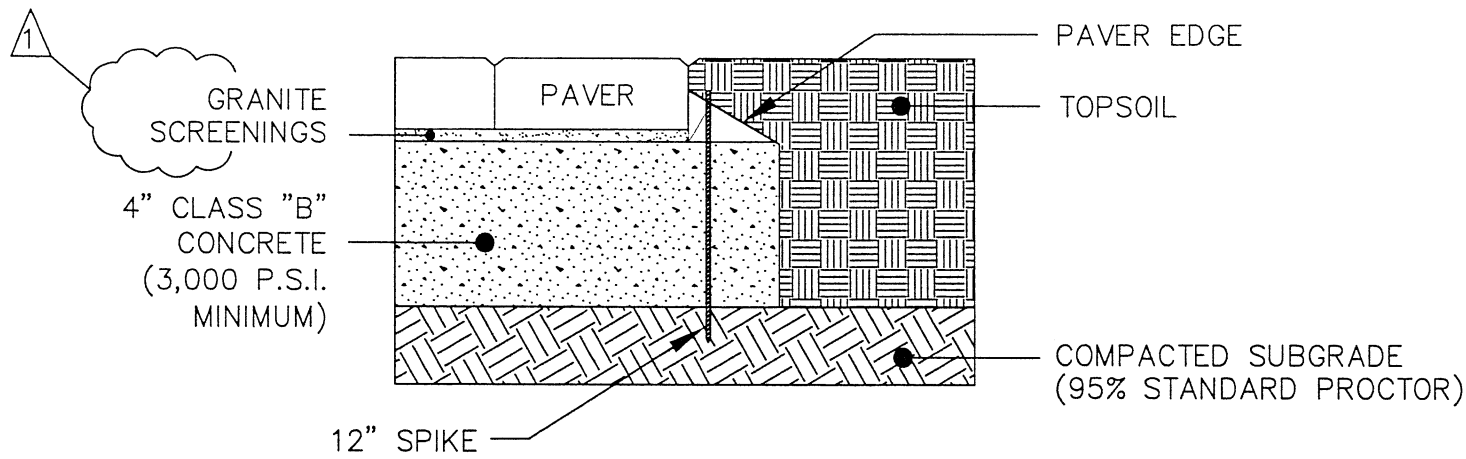

NOTE
ALL PAVER EDGES WILL
BE RIGID UNLESS OTHER-
WISE SPECIFIED.

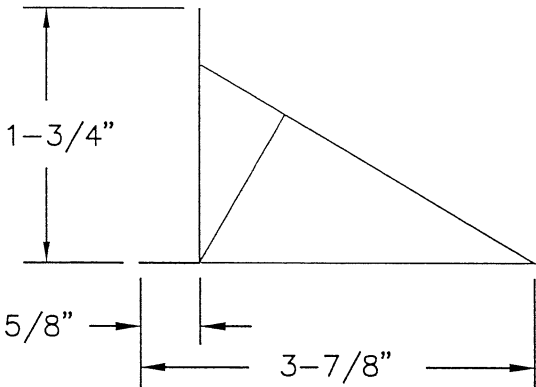

TYPICAL SECTION
PAVER EDGE INSTALLATION



RIGID
PAVER EDGE

CONCRETE COLOR CHART *

INTEGRAL COLOR	INCRETE SYSTEMS COLORCRETE	RED	GRAY
		20 LBS. PER C.Y. TILE RED	15 LBS. PER C.Y. CHARCOAL GRAY
COLOR HARDENER	INCRETE SYSTEMS COLOR HARDENER	AB RED	AB GRAY
RELEASE AGENT	INCRETE SYSTEMS COLOR RELEASE	SUN GRAY	DARK GRAY
SEALANT	INCRETE SYSTEMS CLEAR SEAL	YES	YES
90° HERRING-BONE	KRAFT TOOL CO. NEW HERRINGBONE BRICK TOOL #CC505R	YES	YES

- * 1. BRAND NAMES LISTED ABOVE ESTABLISH A STANDARD. OTHER COMBINATIONS REQUIRE THE ENGINEER'S APPROVAL.
2. CONTRACTOR SHALL ENSURE COLOR MATCH BETWEEN CONCRETE AND PAVERS BY SUBMITTAL OF A 4' X 4' ON-SITE SAMPLE FOR THE ENGINEER'S APPROVAL PRIOR TO PLACEMENT OF STAMPED CONCRETE OR BRICK PAVERS.


F:\STDDWG\GS\utilcvt\pavededge.dwg

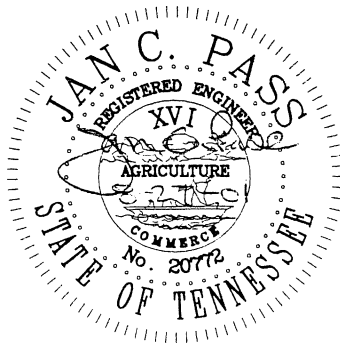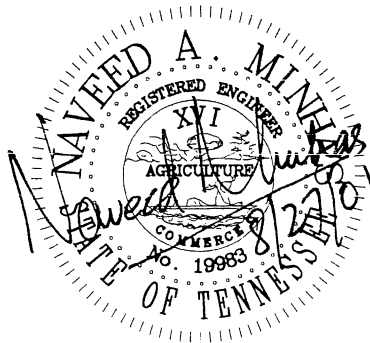

1	REVISIONS AS MARKED OR CLOUDED	8/24/01
0	INITIAL ISSUE	12/10/99
NO.	REVISION	DATE

CITY OF CHATTANOOGA AND HAMILTON COUNTY	
PAVER EDGE DETAILS AND COLOR CHART	
DATE OF ORIGINAL ISSUE DECEMBER 10, 1999	STANDARD NUMBER : SD-503.01



F:\STDWGS\PAVER Intersection\PAVEINT.dwg

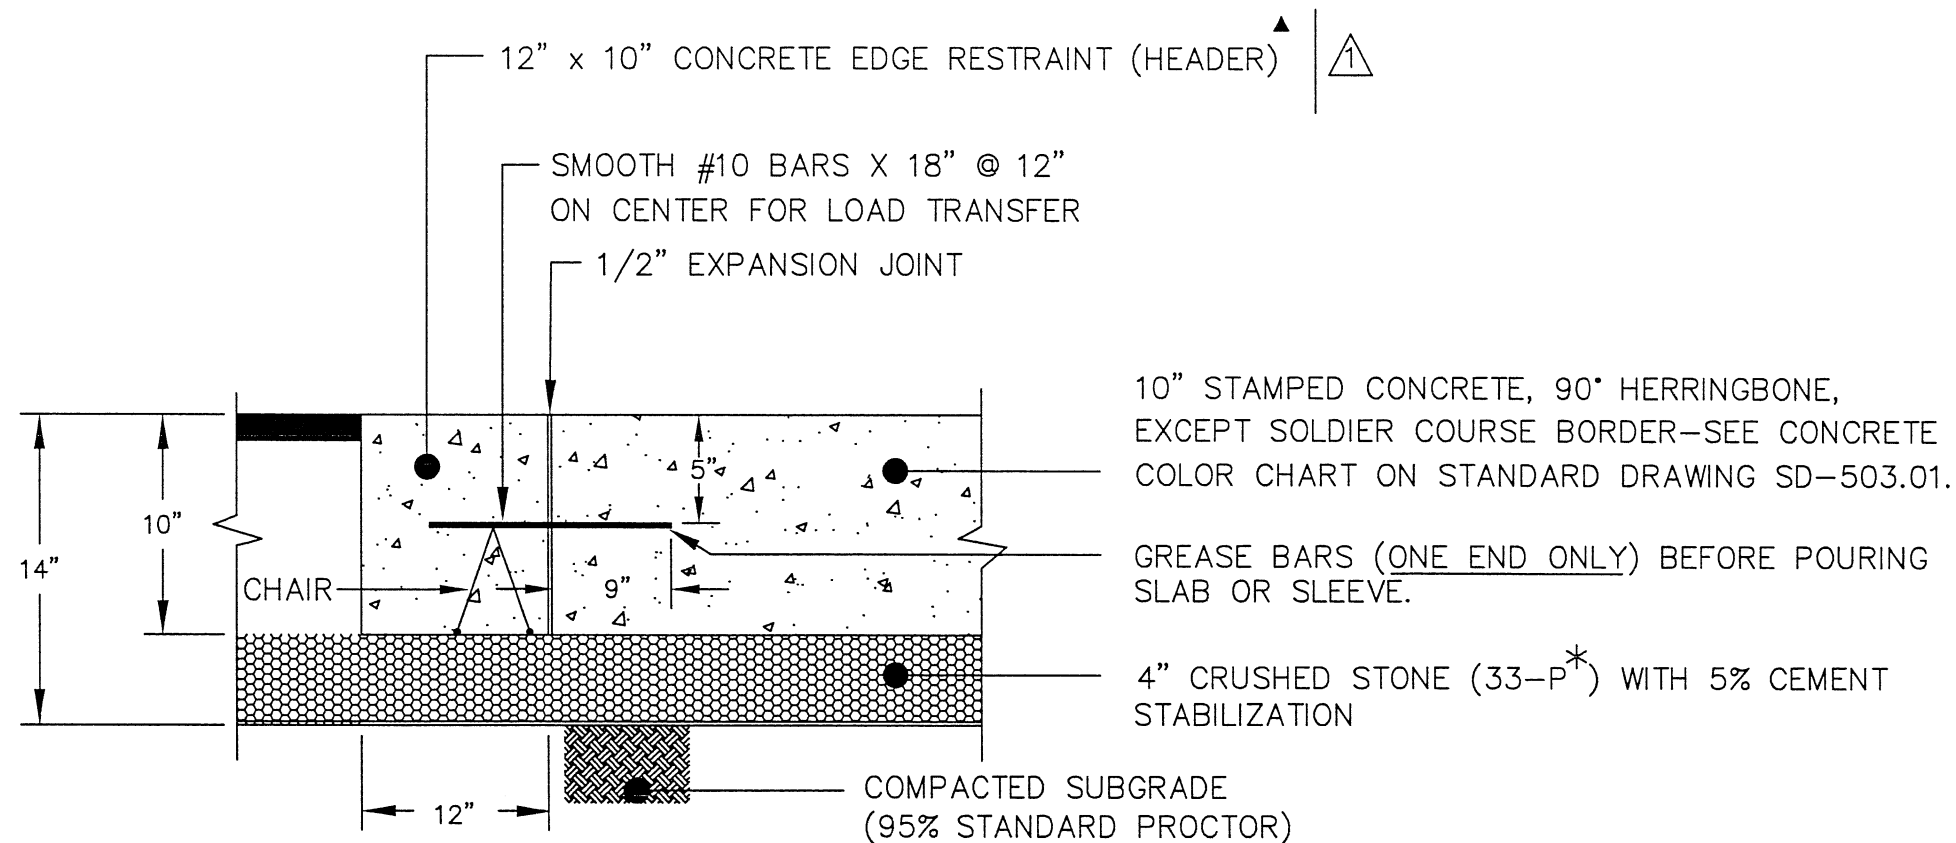


NOTES

1. ALL BARS SHALL BE PERPENDICULAR TO THE FACE AND BE LEVEL.
2. SAWED CONTROL JOINTS SHALL BE CAULKED WITH APPROPRIATELY COLORED SEALANT.
3. CONSTRUCTION JOINTS SHALL OCCUR ON LANE LINES.
- ▲ 4. EDGE RESTRAINT (HEADER) SHALL BE CONSTRUCTED BETWEEN RED COLOR STAMPED CONCRETE AND CHARCOAL COLOR STAMPED CONCRETE.

* "33-P (PUG)" — 303-01, TYPE A,
GRADING D ("33-P"), TENNESSEE
D.O.T. SPECIFICATIONS.

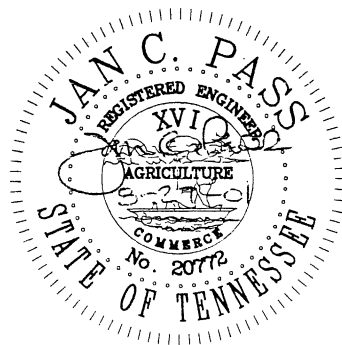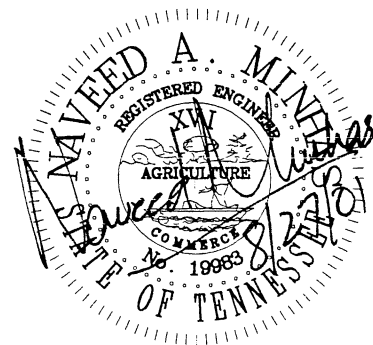

CITY OF CHATTANOOGA AND HAMILTON COUNTY			
PAVER INTERSECTION DETAIL			
1	REVISIONS AS MARKED OR CLOUDED	8/24/01	DATE OF ORIGINAL ISSUE
0	INITIAL ISSUE	12/10/99	DECEMBER 10, 1999
NO.	REVISION	DATE	STANDARD NUMBER : SD-504.01

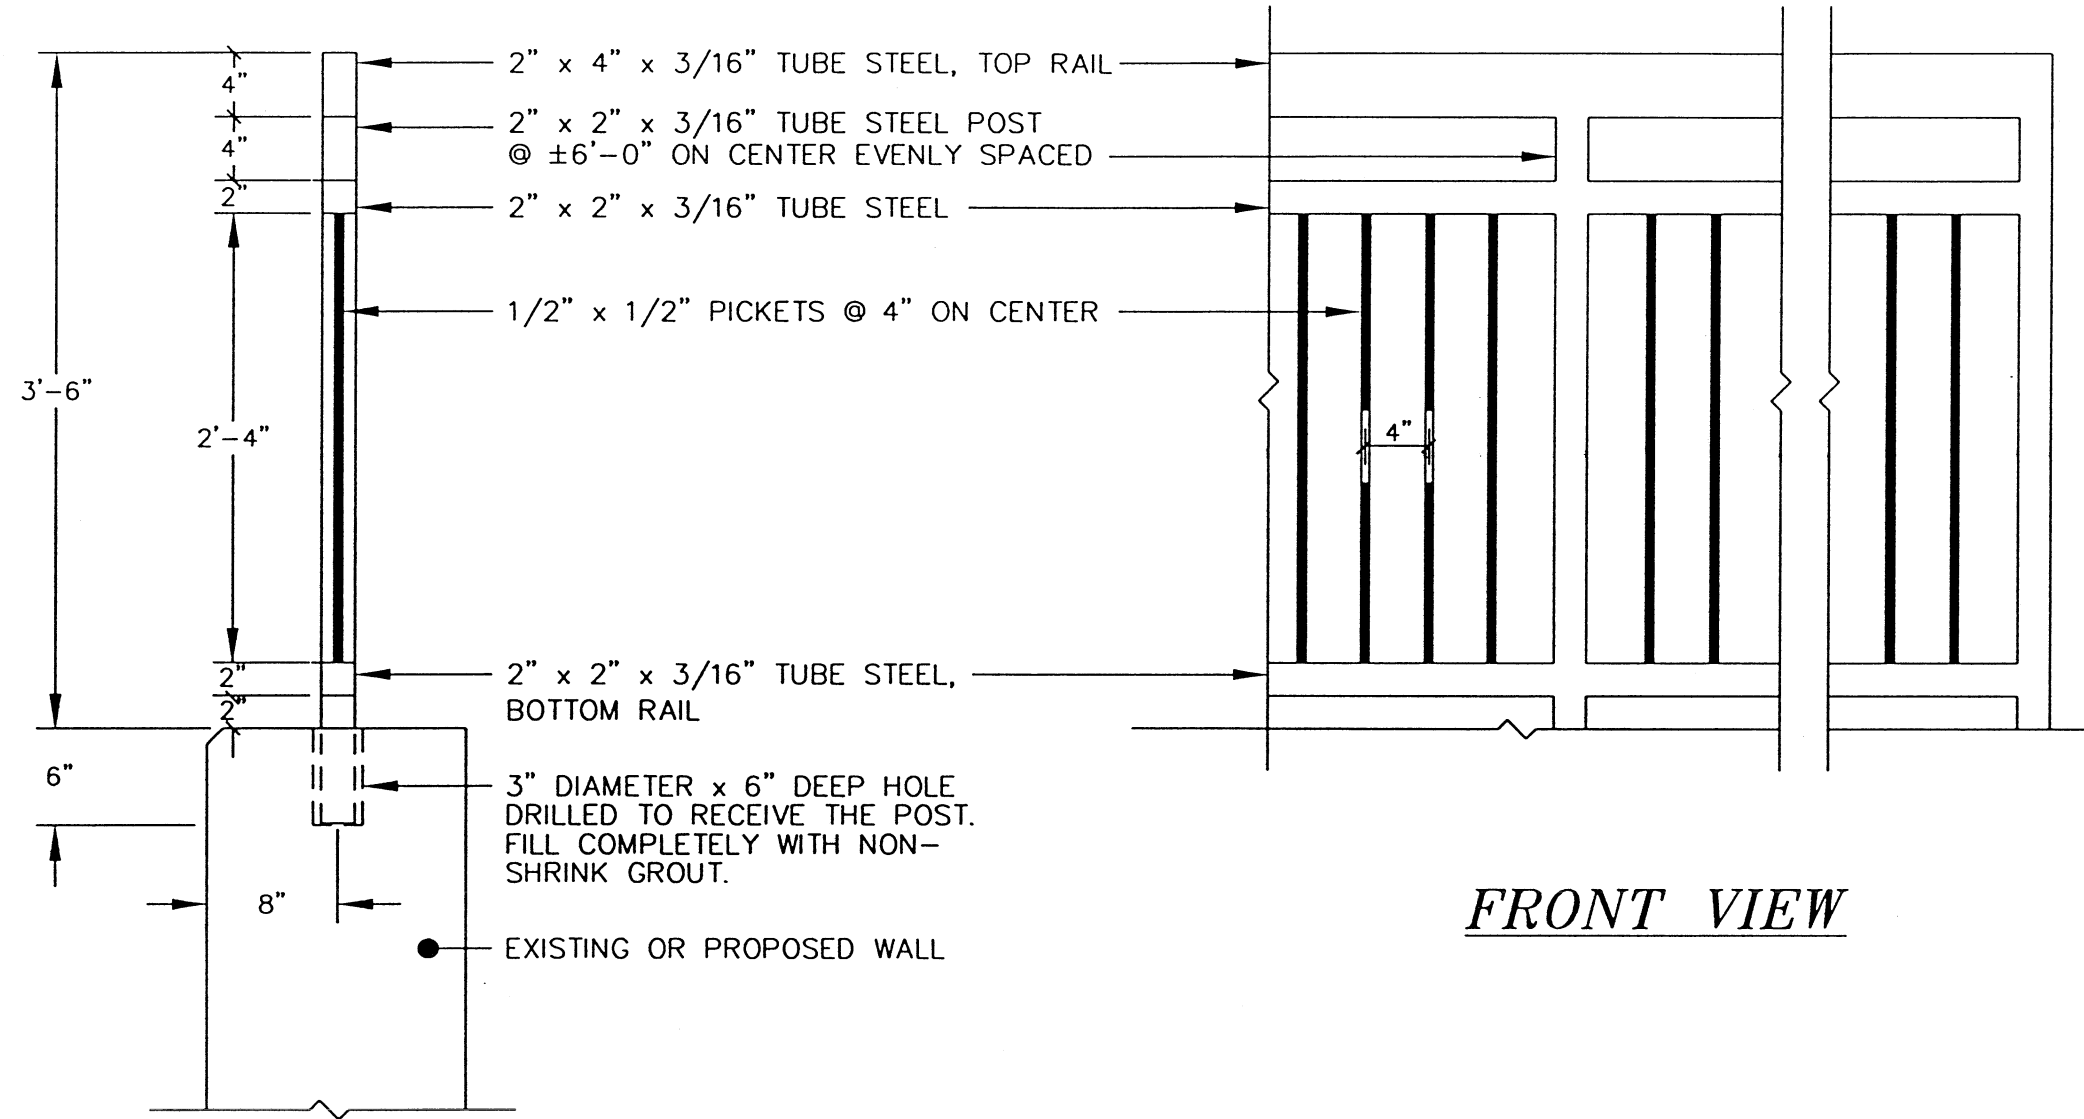


FRONT VIEW

SIDE VIEW


NOTE

PAINT SHALL BE JONES-BLAIR
"POLE GREEN PAINT", OR AS
APPROVED BY THE GOVERNMENTAL
ENGINEER, APPLIED PER MANUFAC-
TURER'S RECOMMENDATIONS.

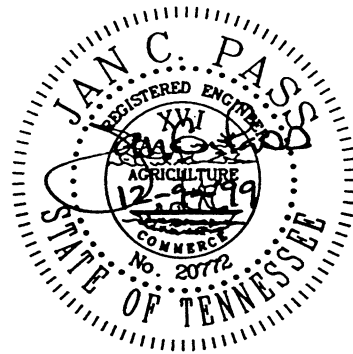


CITY OF CHATTANOOGA AND HAMILTON COUNTY			
STREETScape GUARDRAIL DETAIL			
DATE OF ORIGINAL ISSUE		STANDARD NUMBER: SD-505.01	
0	INITIAL ISSUE	12/10/99	DECEMBER 10, 1999
NO.	REVISION	DATE	


STDDWGS\Foundation Details - 39' Pole\FOUND.TLS.dwg

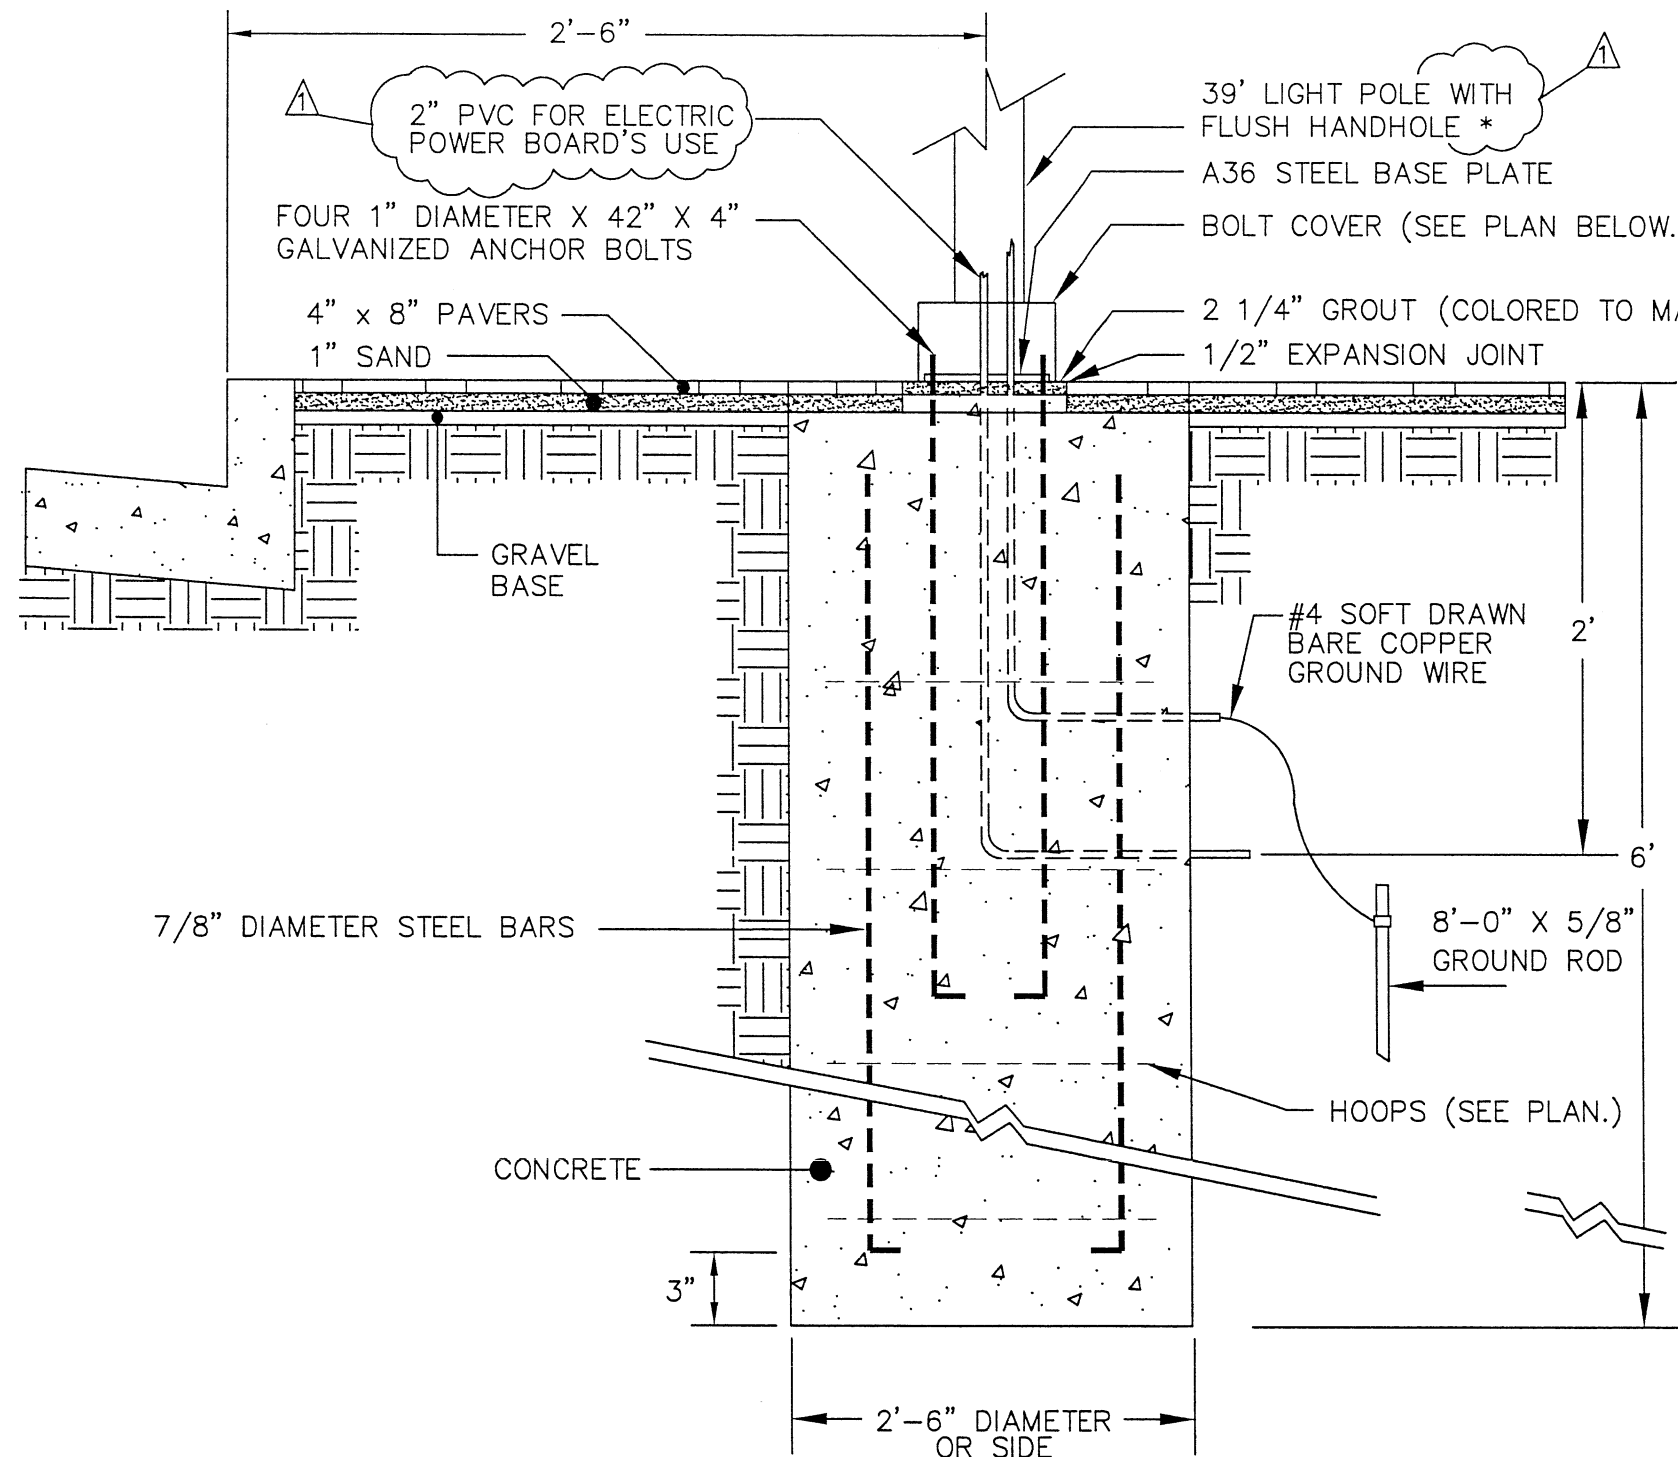

ELEVATION

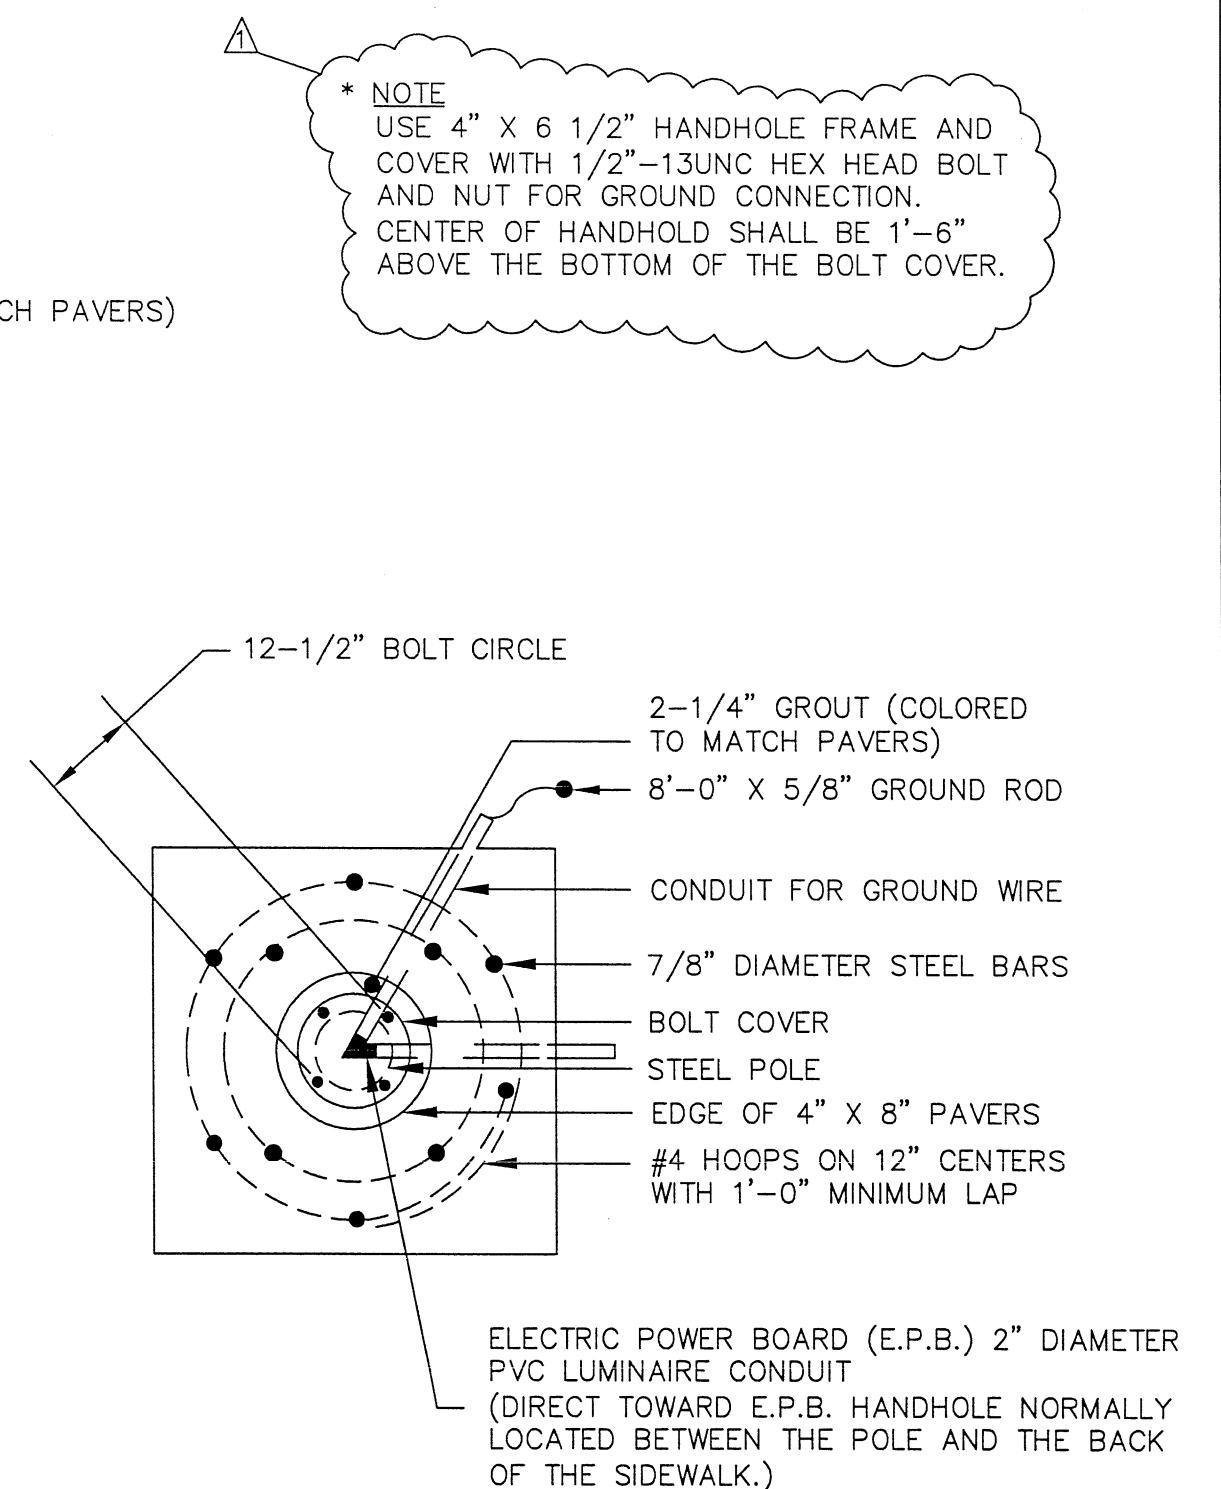

PLAN

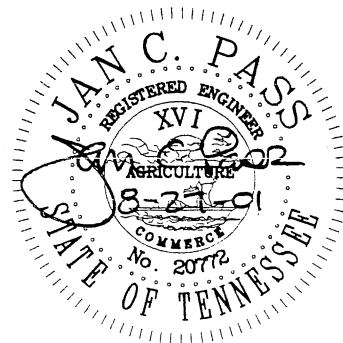



1	REVISIONS AS MARKED OR CLOUDED	8/24/01
0	INITIAL ISSUE	12/10/99
NO.	REVISION	DATE

CITY OF CHATTANOOGA AND HAMILTON COUNTY
FOUNDATION DETAILS (39' STREETLIGHT POLE)

DATE OF ORIGINAL ISSUE
DECEMBER 10, 1999

STANDARD NUMBER : **SD-506.01**


F:\STDWGS\Pedlight 12' Eureka\PEDLIGHT.dwg

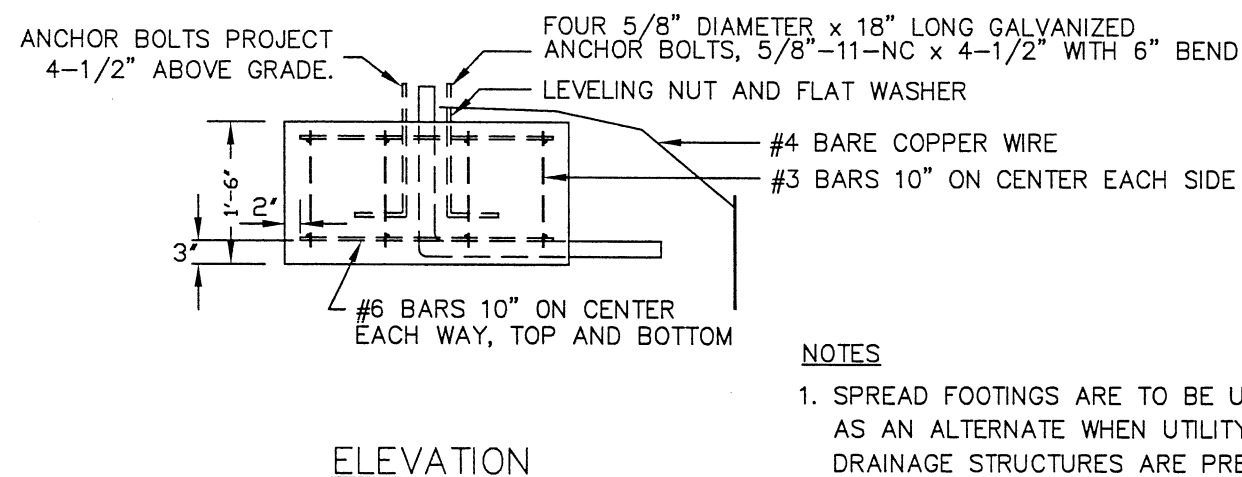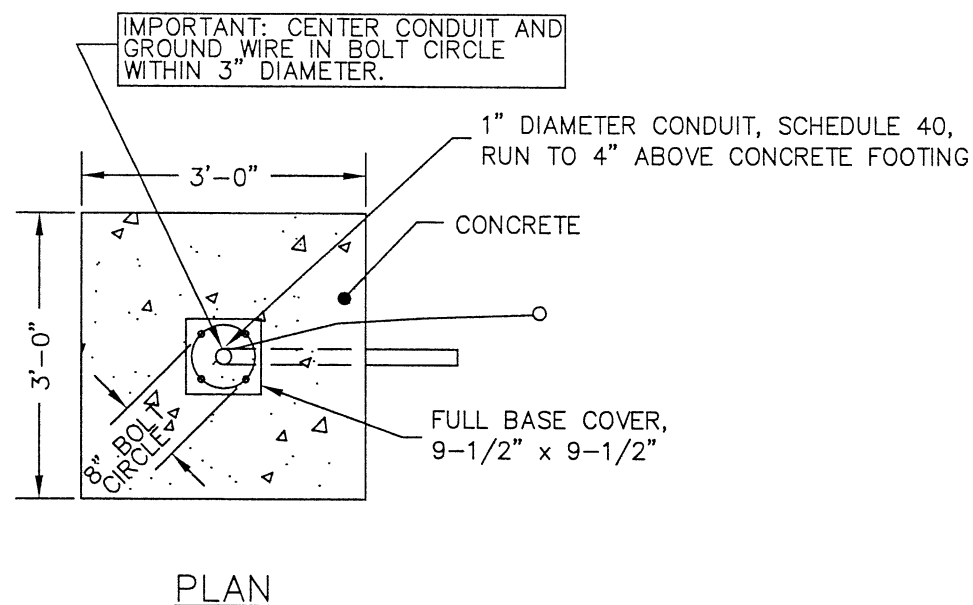

SPREAD FOOTING


NOTES

1. SPREAD FOOTINGS ARE TO BE USED AS AN ALTERNATE WHEN UTILITY AND DRAINAGE STRUCTURES ARE PRESENT, SUBJECT TO THE APPROVAL OF THE GOVERNMENTAL ENGINEER.
2. ELECTRIC PULL BOXES (HANDHOLES) ARE TO BE A UNIFORM DISTANCE FROM THE BACK OF THE SIDEWALK. LOCATIONS SHALL BE DETERMINED BY ELECTRIC POWER BOARD (E.P.B.) INSPECTOR AND GOVERNMENTAL INSPECTOR.
3. CONDUIT TRENCHING PER E.P.B. APPROVED SITE PLAN DRAWING AND TRENCH SPECIFICATION OF 24" DEEP X 6" WIDE. BACKFILL TRENCH WITH 33-P* STONE.

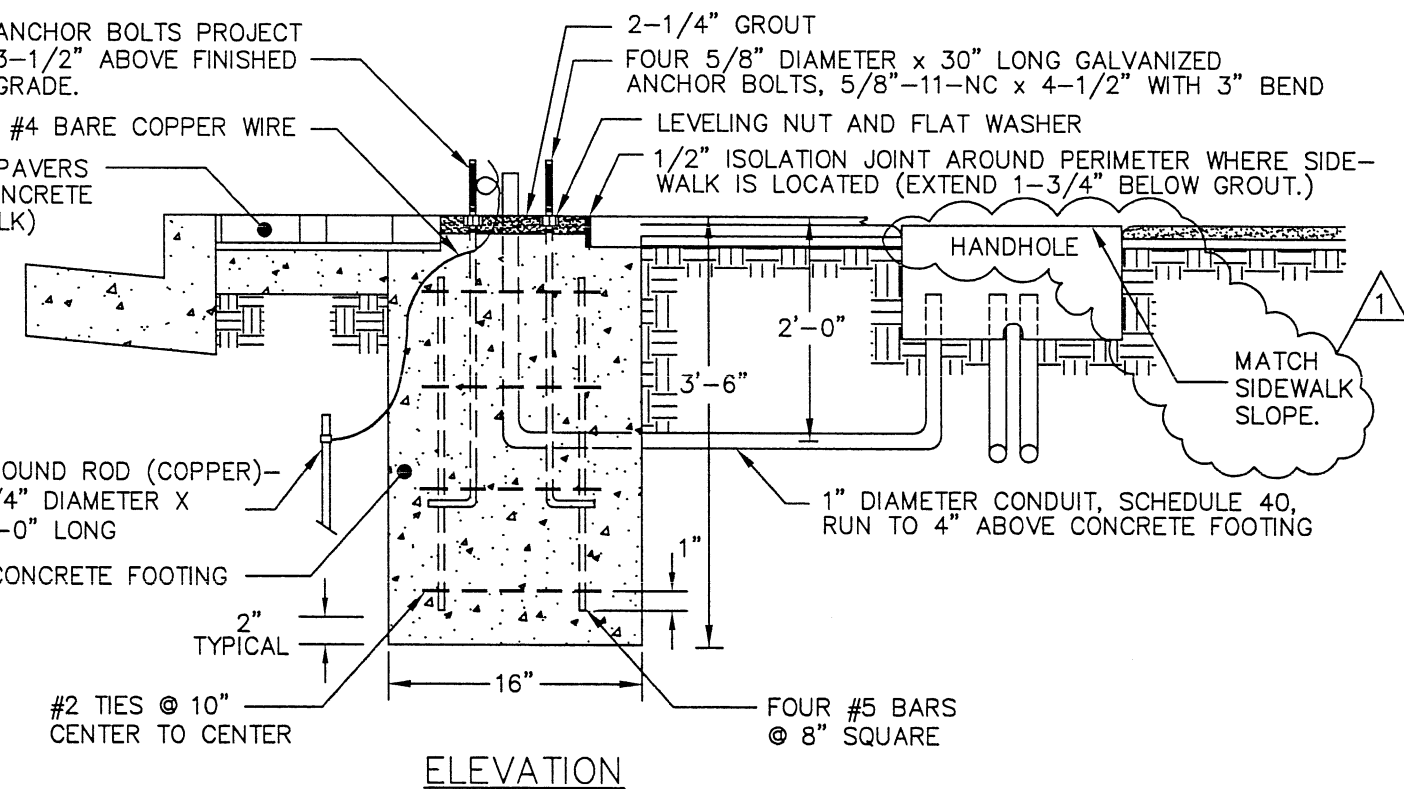

FOUNDATION

*"33-P (PUG)" - 303.01, TYPE A, GRADING D ("33-P"), TENNESSEE D.O.T. SPECIFICATIONS

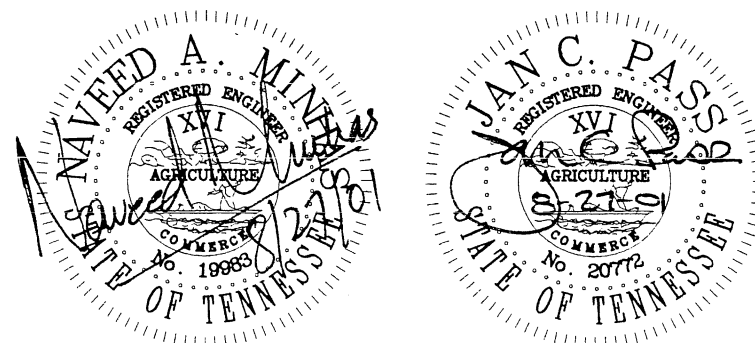


NO.	REVISION	DATE
1	REVISIONS AS MARKED OR CLOUDED	8/24/01
0	INITIAL ISSUE	12/10/99

CITY OF CHATTANOOGA AND HAMILTON COUNTY	
FOUNDATION DETAILS (12' PEDESTRIAN LIGHT POLE)	
DATE OF ORIGINAL ISSUE DECEMBER 10, 1999	STANDARD NUMBER: SD-507.01

NOTE


USE CONCRETE COLOR AS
SPECIFIED ON CONCRETE
COLOR CHART, SD-503.01.

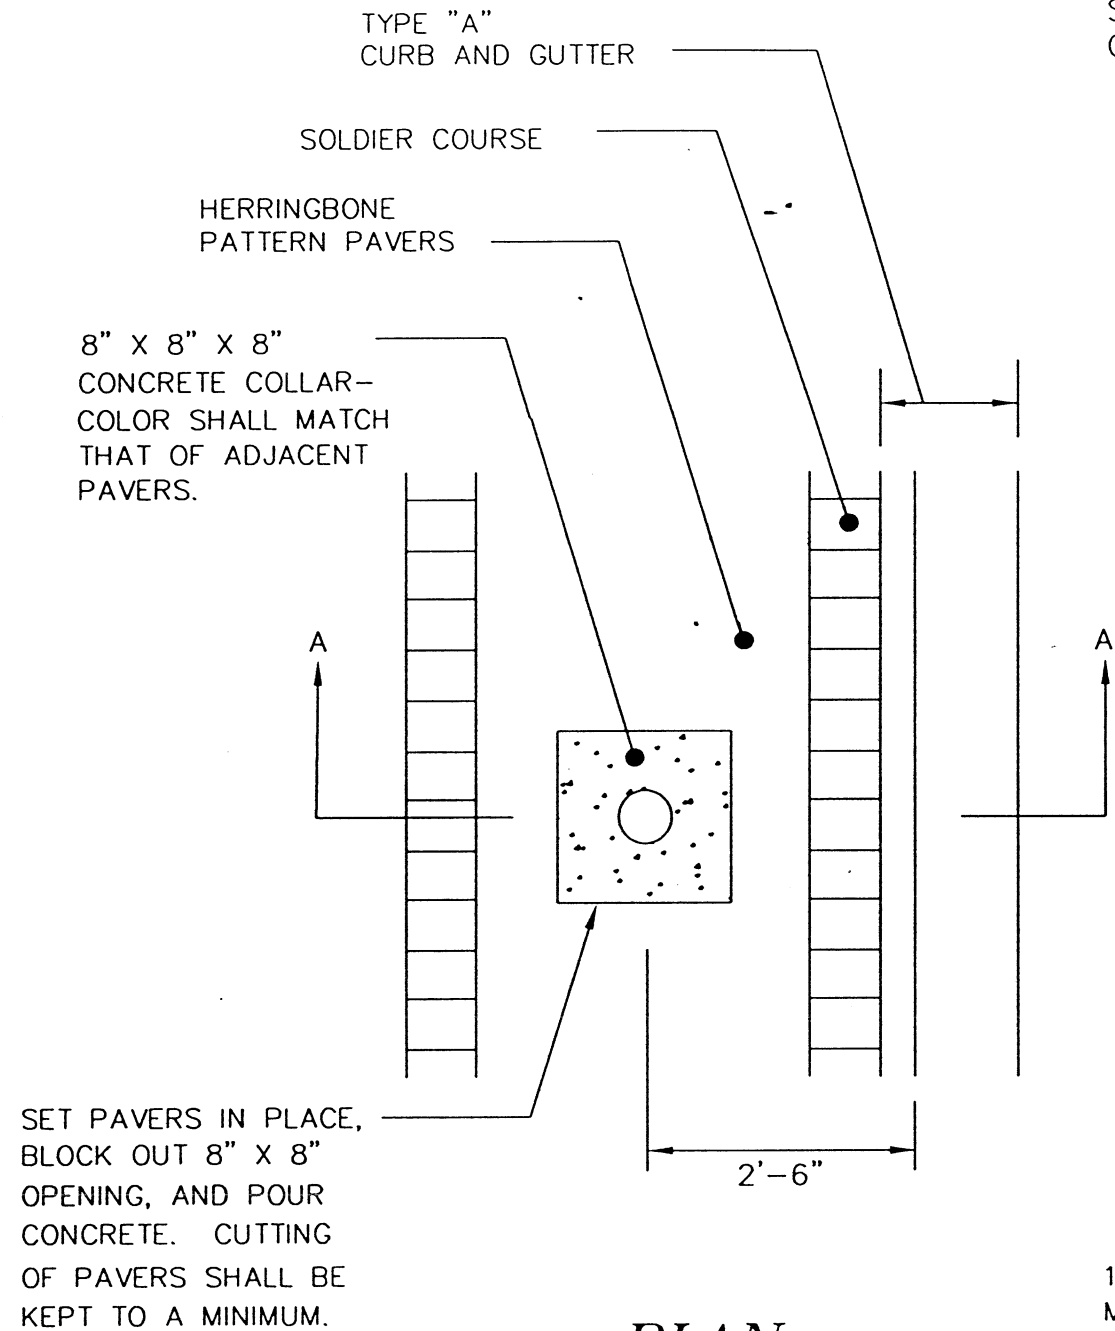



PLAN

4" CLASS "B" CONCRETE


1/2" SAND OR OTHER LEVELING
MATERIAL APPROVED BY THE
ENGINEER

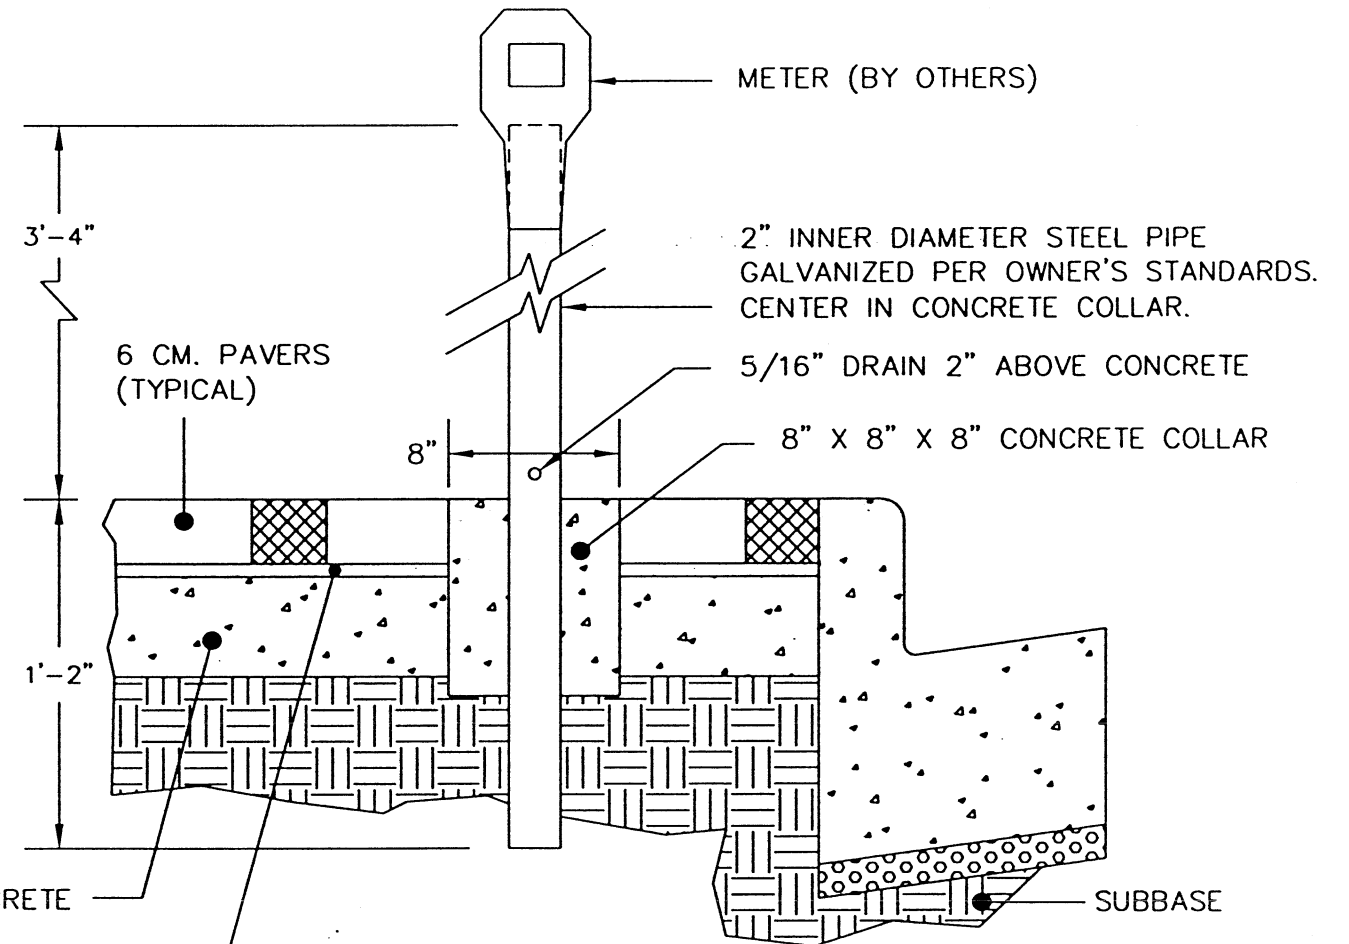


SECTION A-A

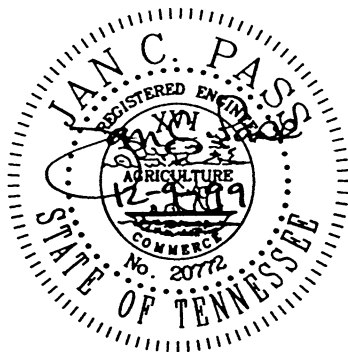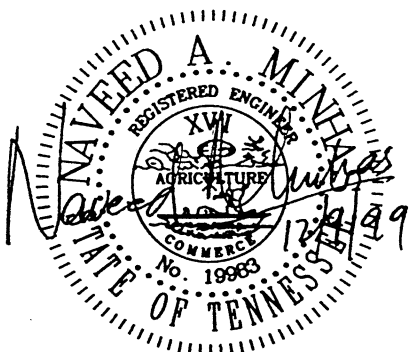


CITY OF CHATTANOOGA AND HAMILTON COUNTY			
PARKING METER DETAILS			
DATE OF ORIGINAL ISSUE		STANDARD NUMBER :	
DECEMBER 10, 1999		SD-508.01	
0	INITIAL ISSUE	12/10/99	
NO.	REVISION	DATE	

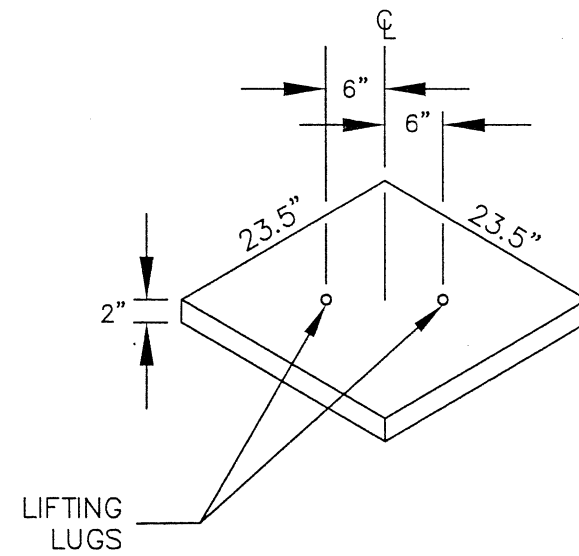

TYPE "A"

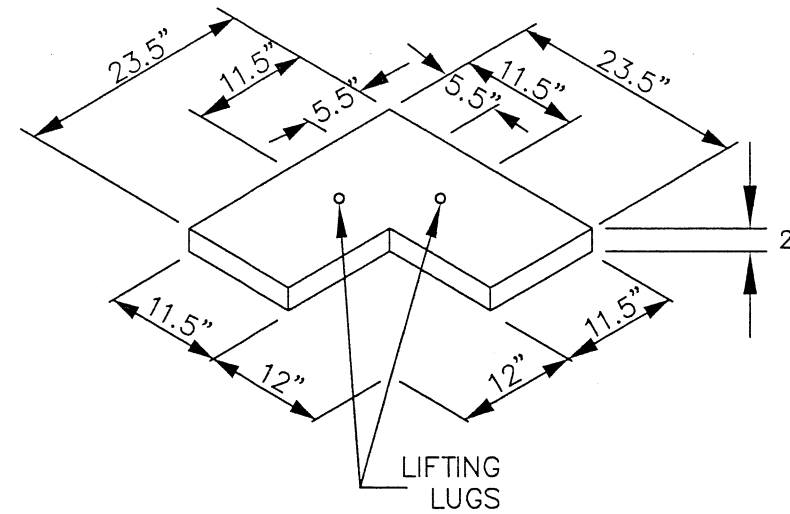


TYPE "B"

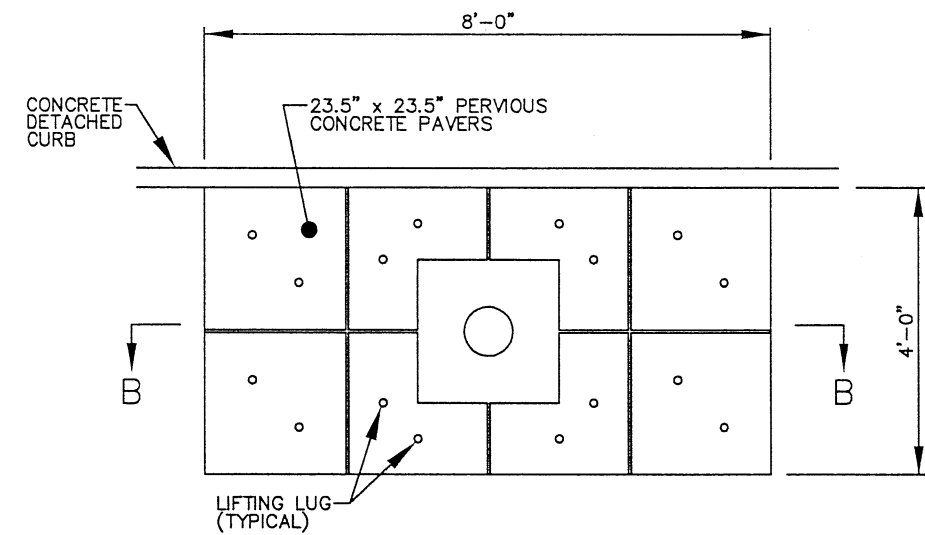

PLAN



NOTES

1. PERVIOUS CONCRETE PAVERS AS MANUFACTURED BY ARCHITECTURAL ORNAMENTAL CASTINGS OF TENNESSEE, LLC, OR APPROVED EQUAL - PAVERS SHALL BE CAPABLE OF ALLOWING PASSAGE OF A MINIMUM OF 70% OF WATER THROUGH BLOCK.
2. THE PAVERS SHALL BE CONSTRUCTED OF A MIXTURE OF #89 STONE, FIBERMESH, AND PORTLAND CEMENT.
3. COLOR - BRICK RED - WITH STANDARD 7% RED CEMENT COLOR FROM SOUTHERN COLOR, OR APPROVED EQUAL.
4. EACH PAVER SHALL HAVE INSTALLED LIFTING LUGS AS SHOWN TO FACILITATE INSTALLATION AND MAINTENANCE. LIFTING LUGS SHALL BE $\frac{1}{2}$ " FX-19 FERRULE WING INSERTS WITH $\frac{1}{2}$ " FC-18 THREADED PLASTIC PLUG BY MEADOW BURKE PRODUCTS, OR APPROVED EQUAL.
5. COARSE RIVER SAND SHALL BE SWEEPED INTO CRACKS (TYPICAL).
6. SEE STANDARD DRAWINGS SD-500.01 AND SD-500.02.

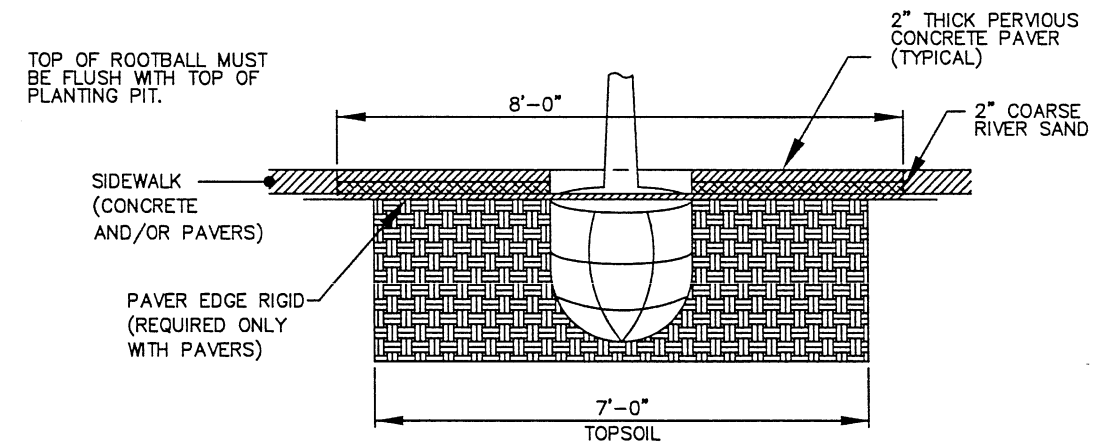

SECTION B-B

TREE PLANTER WITH PERVIOUS PAVERS

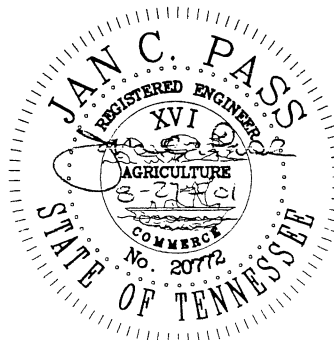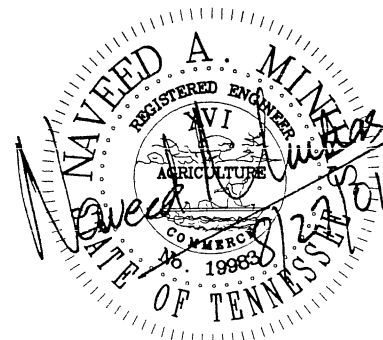


0	INITIAL ISSUE	8/24/01
NO.	REVISION	DATE

CITY OF CHATTANOOGA AND HAMILTON COUNTY
PERVIOUS CONCRETE PAVER DETAIL

DATE OF ORIGINAL ISSUE
AUGUST 24, 2001

STANDARD NUMBER : **SD-509.01**

DRAINAGE

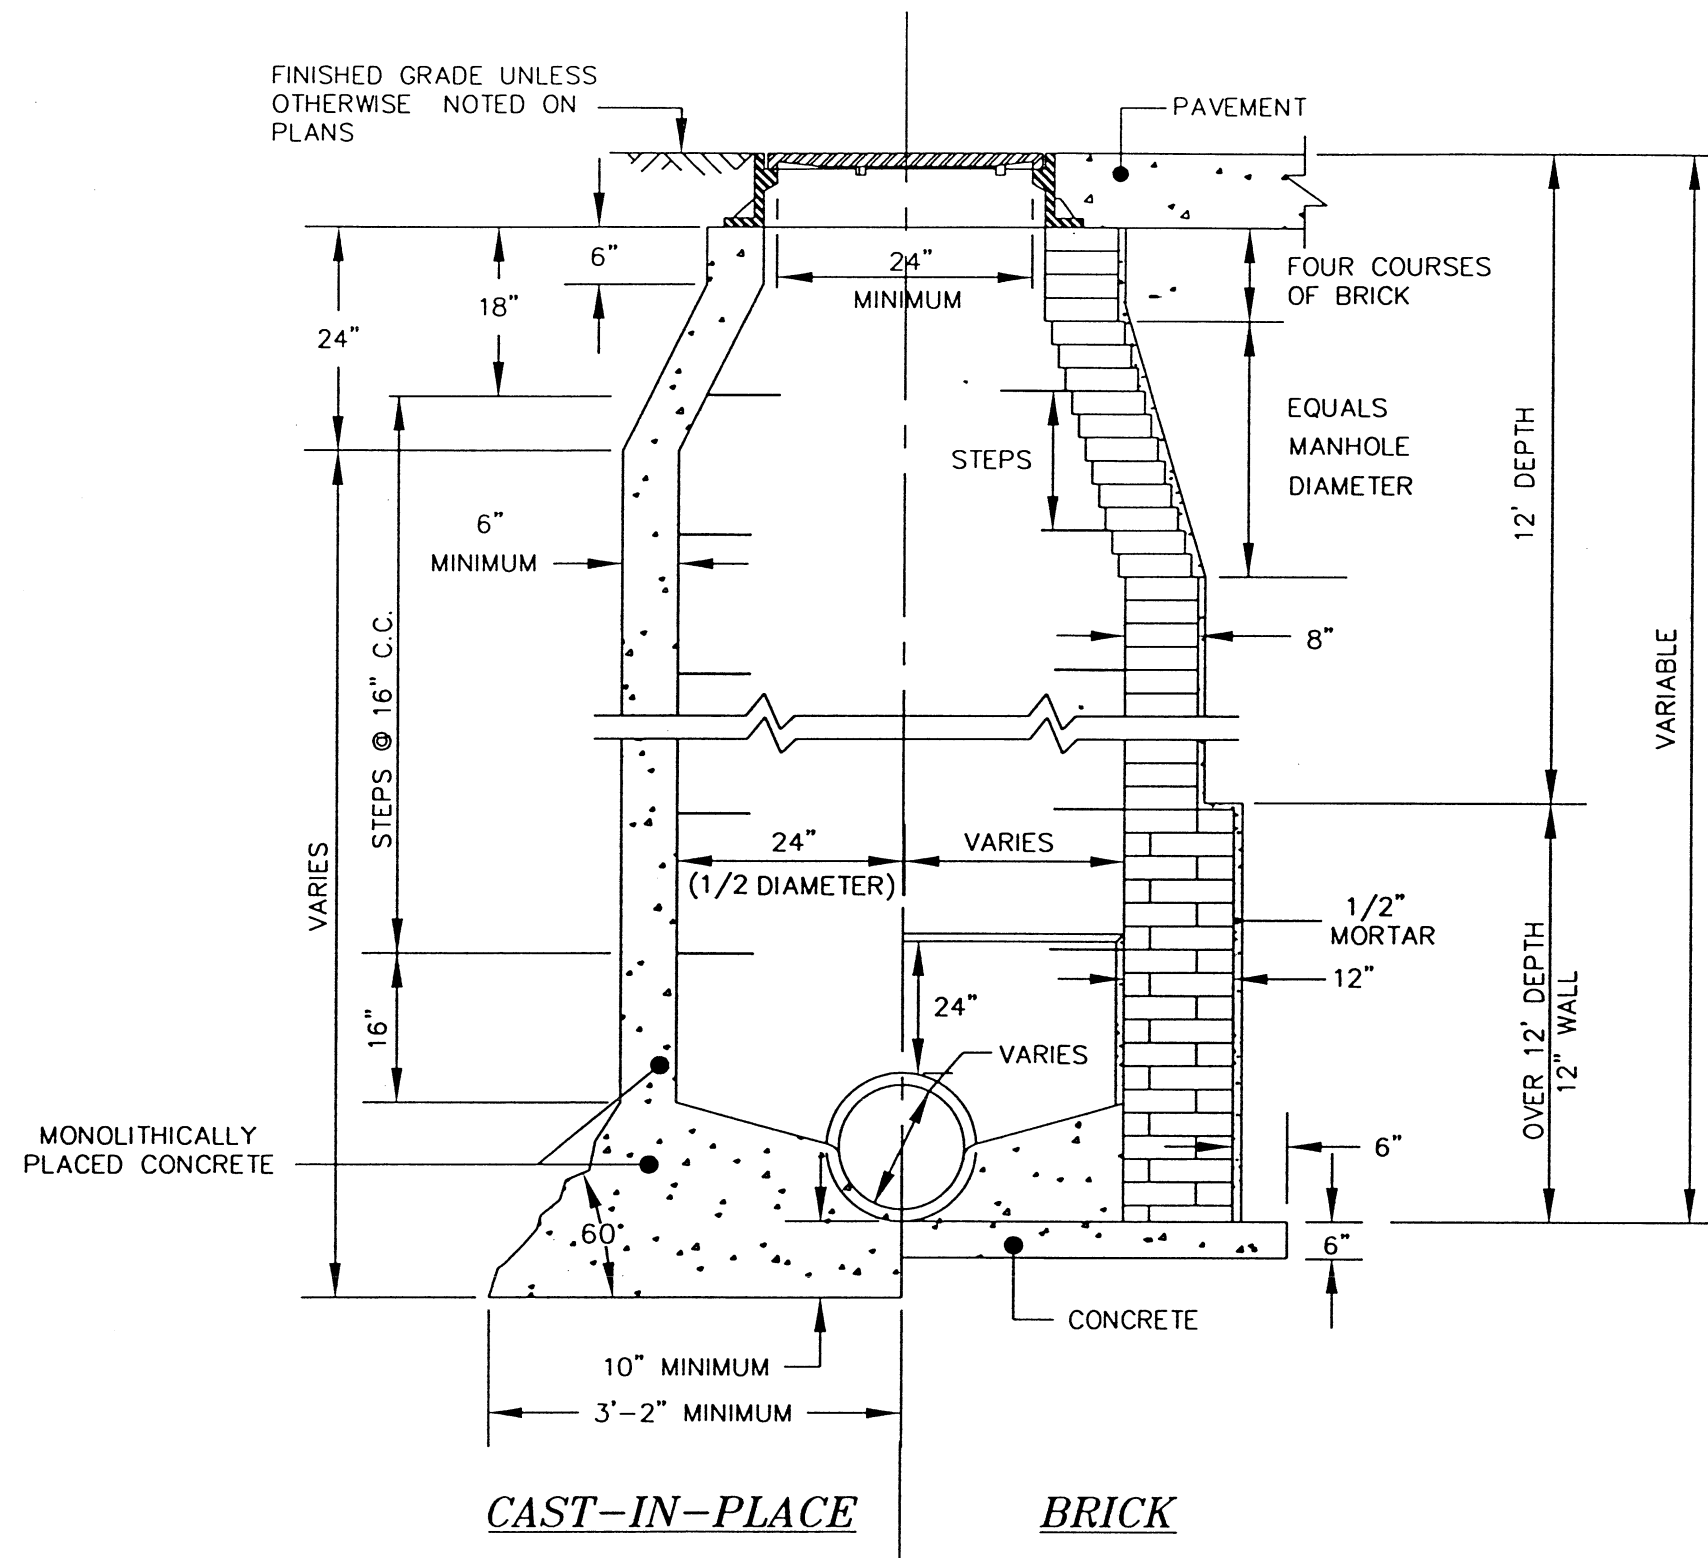

NOTES

CAST-IN-PLACE



1. CONCRETE SHALL BE VIBRATED INSIDE OF FORMS AND OUT AS DIRECTED BY THE ENGINEER
2. A MANHOLE MORE THAN 12' IN DEPTH SHALL HAVE APPROVED REINFORCING.
3. A MAXIMUM OF TWO CONCRETE RINGS MAY BE USED FOR ELEVATION ADJUSTMENT OF MANHOLE FRAMES.

BRICK

4. FOR BRICK CONSTRUCTION, JOINTS SHALL ALWAYS BE COMPLETELY FILLED WITH MORTAR. BRICKS SHALL BE LAID WITH VERTICAL MORTAR JOINTS NOT MORE THAN 3/8" THICK AND HORIZONTAL MORTAR JOINTS NOT LESS THAN 3/8" THICK AT THE INSIDE FACE. INSIDE JOINTS SHALL BE TROWEL STRUCK, FLUSH JOINTS TO PROVIDE A SMOOTH, CLEAN SURFACE, WHILE OUTSIDE WALLS SHALL BE ENTIRELY COVERED WITH MORTAR FOR A SMOOTH, CLEAN SURFACE.

ALL

5. FOR INVERT DETAILS, SEE SD-301.01.
6. FOR MANHOLE STEP DETAILS, SEE SD-301.04.
7. FOR MANHOLE FRAME AND COVER DETAILS, SEE SD-301.03.

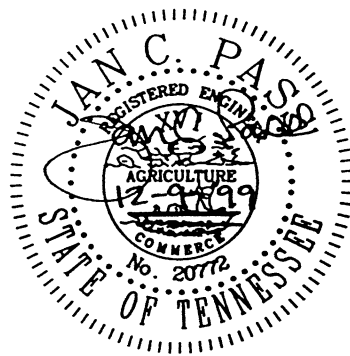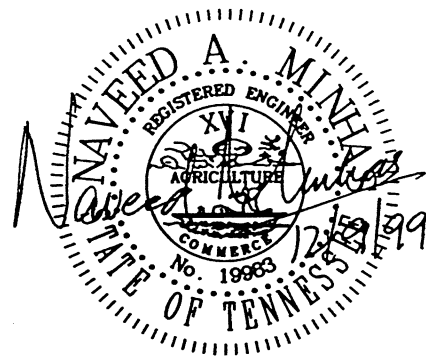

0	INITIAL ISSUE	12/10/99
NO.	REVISION	DATE


CITY OF CHATTANOOGA AND HAMILTON COUNTY

STORM MANHOLE (BRICK/CAST-IN-PLACE)


DATE OF ORIGINAL ISSUE
DECEMBER 10, 1999

STANDARD NUMBER: SD-600.01


F:\STDWGS\Endwall-Concrete\ENDWALL (STRAIGHT).dwg Thu Dec 09 07:59:33 1999 STATIONS 24

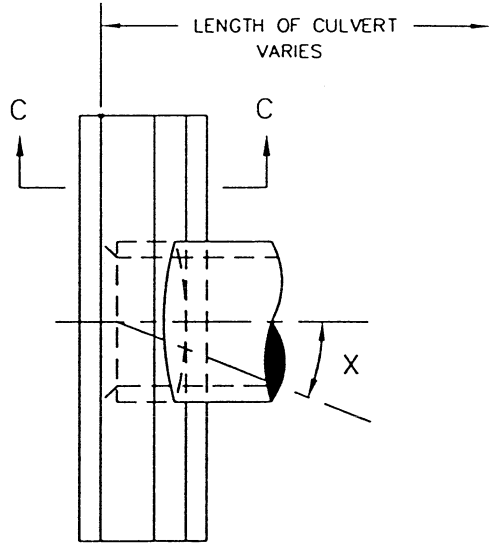

PLAN

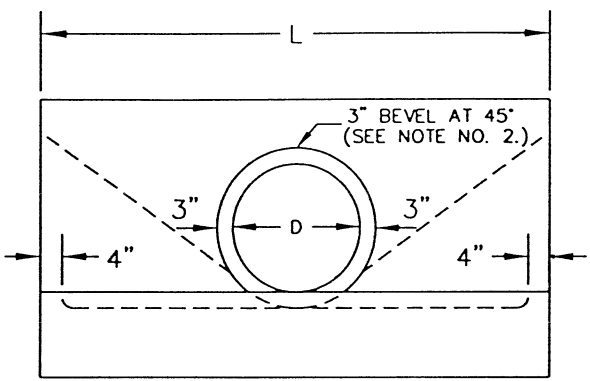


FRONT ELEVATION

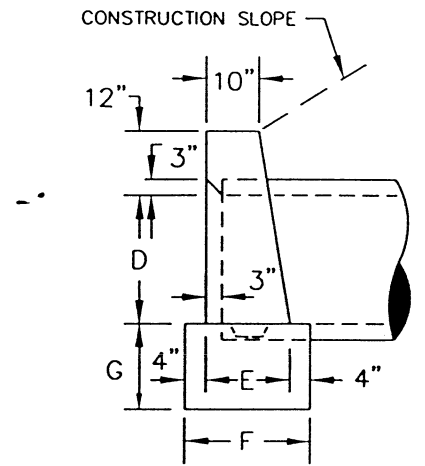


SIDE ELEVATION

TABLE "A" - DIMENSIONS FOR ONE STRAIGHT, CONCRETE ENDWALL (X=0°)					
DIMENSIONS					
OPENING	WALL		FOOTING		
D	L	H	E	F	G
1'-6"	6'-0"	2'-6"	1'-3"	1'-11"	1'-3"
2'-0"	8'-0"	3'-0"	1'-4"	2'-0"	1'-4"
2'-6"	10'-0"	3'-6"	1'-6"	2'-2"	1'-6"

TABLE "B" - VALUE OF "L" WHEN ANGLE "X" IS GREATER THAN 0°					
D	0(+)-10'	10(+)-20'	20(+)-30'	30(+)-40'	40(+)-50'
1'-6"	6'-0"	6'-5"	6'-11"	7'-10"	9'-4"
2'-0"	8'-2"	8'-6"	9'-3"	10'-5"	12'-6"
2'-6"	10'-2"	10'-7"	11'-6"	13'-2"	15'-7"

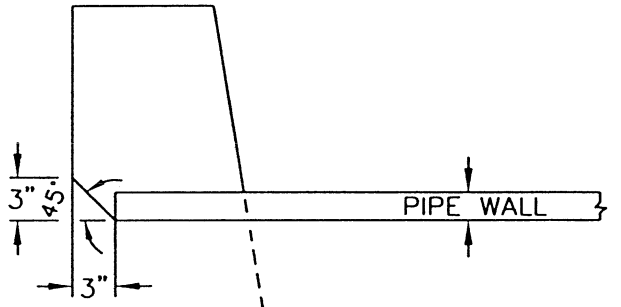


DETAIL OF BEVEL

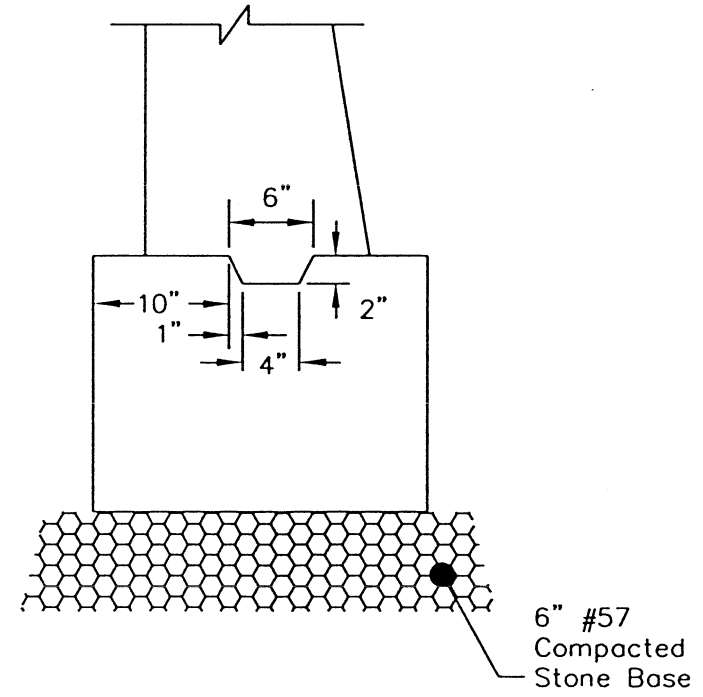


SECTION C-C
SHOWING CONSTRUCTION JOINT

NOTES


1. WHEN A PIPE IS ON A SKEW, REFER TO TABLE "B" FOR THE VALUE OF "L".
2. ALL TYPE "S", CONCRETE ENDWALLS ON THE INLET END OF THE PIPE AND AT 90° TO THE PIPE SHALL BE BEVELED 3" AT A 45° ANGLE. THE BEVEL WILL NOT BE REQUIRED WHEN THE ENDWALL IS CONSTRUCTED ON THE "BELLED" END OF A CONCRETE PIPE.
3. WHEN MORE THAN ONE LINE OF PIPE IS REQUIRED, THE DISTANCE FROM CENTER TO CENTER OF PIPES SHALL BE (D+1'-0").
4. A 1" CHAMFER SHALL BE USED ON EACH EXPOSED EDGE AND CORNER.
5. ENDWALLS SHALL HAVE #4 BARS AT 12" ON CENTER, EACH WAY, IN THE CENTER OF ALL SLABS AND WALLS.
6. EIGHT INCH (8") BRICK WALLS MAY BE SUBSTITUTED FOR CONCRETE WALLS WHEN "D" IS 36" OR LESS.

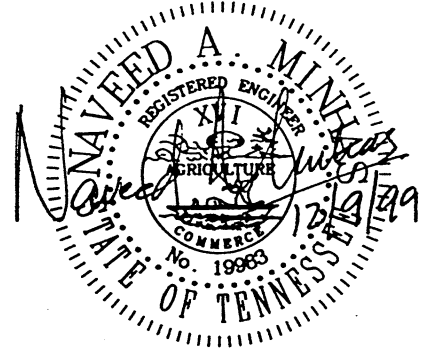


CITY OF CHATTANOOGA AND HAMILTON COUNTY			
CONCRETE ENDWALL (TYPE "S")			
DATE OF ORIGINAL ISSUE		STANDARD NUMBER: SD-601.01	
DECEMBER 10, 1999			
0	INITIAL ISSUE	12/10/99	
NO.	REVISION	DATE	

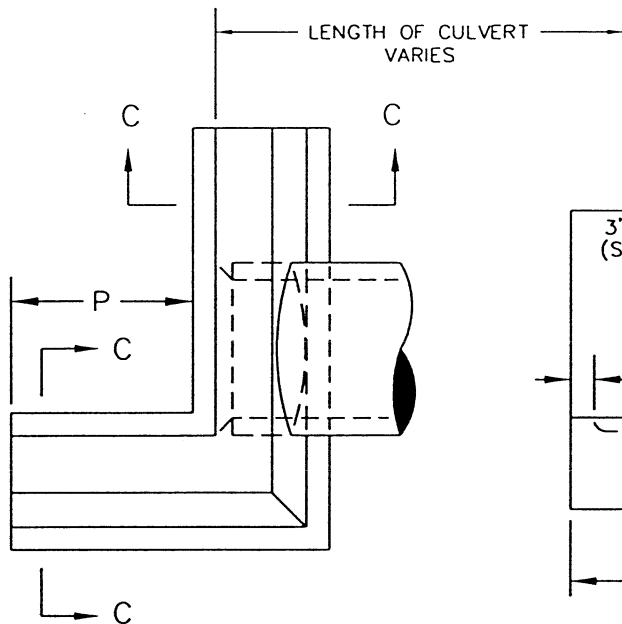

PLAN

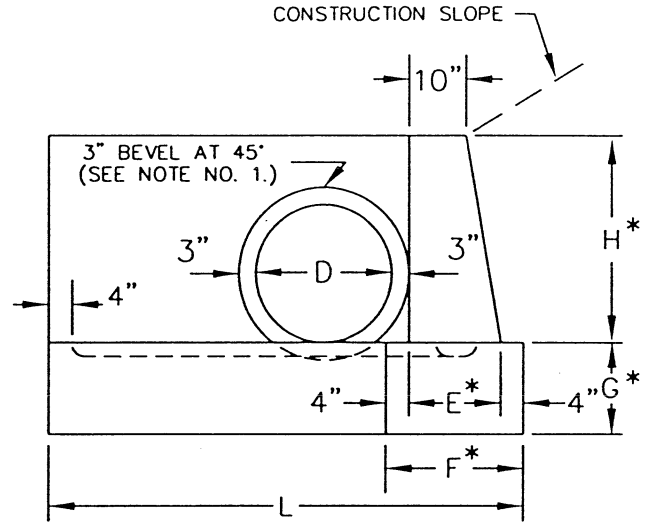


FRONT ELEVATION

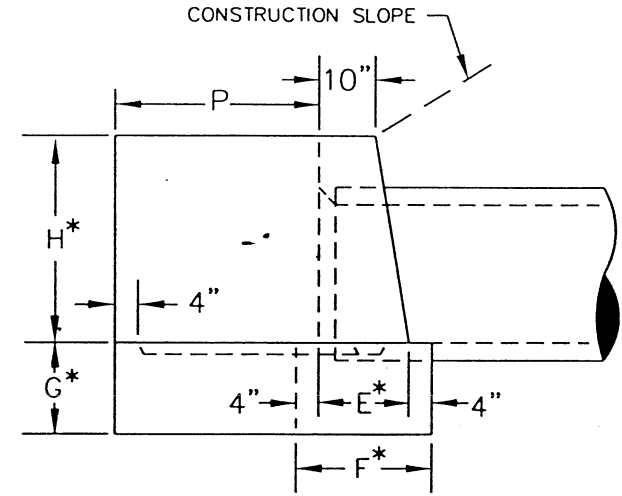


SIDE ELEVATION

TABLE OF DIMENSIONS FOR ONE TYPE "L", CONCRETE ENDWALL		
DIMENSIONS *		
D	P	L
1'-3"	2'-3"	5'-9"
1'-6"	2'-3"	6'-0"
2'-0"	3'-0"	8'-0"
2'-6"	3'-9"	10'-0"

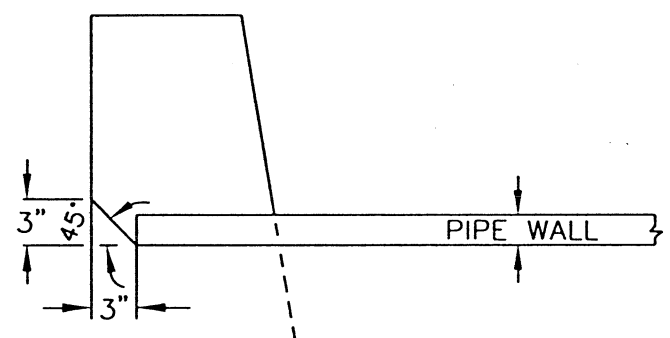

DETAIL OF BEVEL

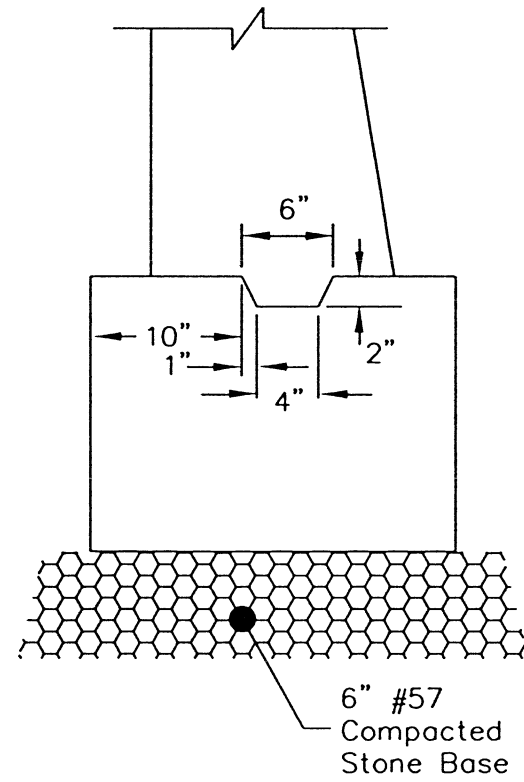


SECTION C-C
SHOWING CONSTRUCTION JOINT


- NOTES
- 1. ALL TYPE "L", CONCRETE ENDWALLS ON THE INLET END OF THE PIPE AND AT 90° TO THE PIPE SHALL BE BEVELED 3" AT A 45° ANGLE. THE BEVEL WILL NOT BE REQUIRED WHEN THE ENDWALL IS CONSTRUCTED ON THE "BELLED" END OF A CONCRETE PIPE.
 - 2. WHEN MORE THAN ONE LINE OF PIPE IS REQUIRED, THE DISTANCE FROM CENTER TO CENTER OF PIPES SHALL BE (D+1'-0").
 - 3. A 1" CHAMFER SHALL BE USED ON EACH EXPOSED EDGE AND CORNER.
 - 4. ENDWALLS SHALL HAVE #4 BARS AT 12" ON CENTER, EACH WAY, IN THE CENTER OF ALL SLABS AND WALLS.
 - * 5. DIMENSIONS NOT SHOWN IN THE TABLE ARE THE SAME AS THOSE FOR A TYPE "S" ENDWALL. SEE SD-601.01.




CITY OF CHATTANOOGA AND HAMILTON COUNTY			
CONCRETE ENDWALL (TYPE "L")			
DATE OF ORIGINAL ISSUE		STANDARD NUMBER: SD-602.01	
DECEMBER 10, 1999			
0	INITIAL ISSUE	12/10/99	
NO.	REVISION	DATE	

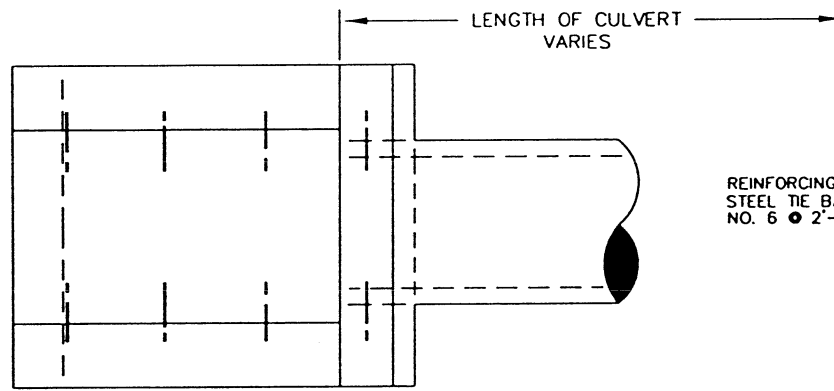

PLAN

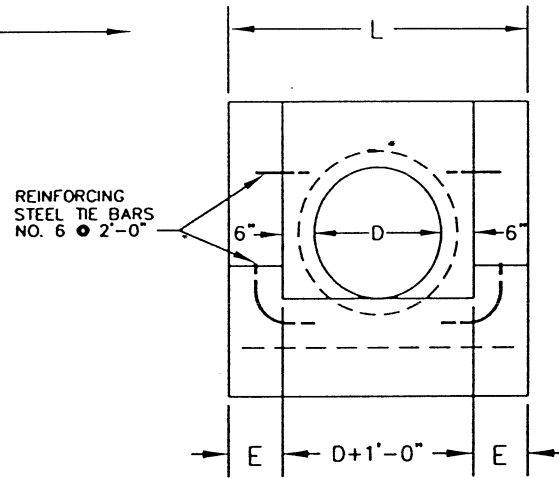

FRONT ELEVATION

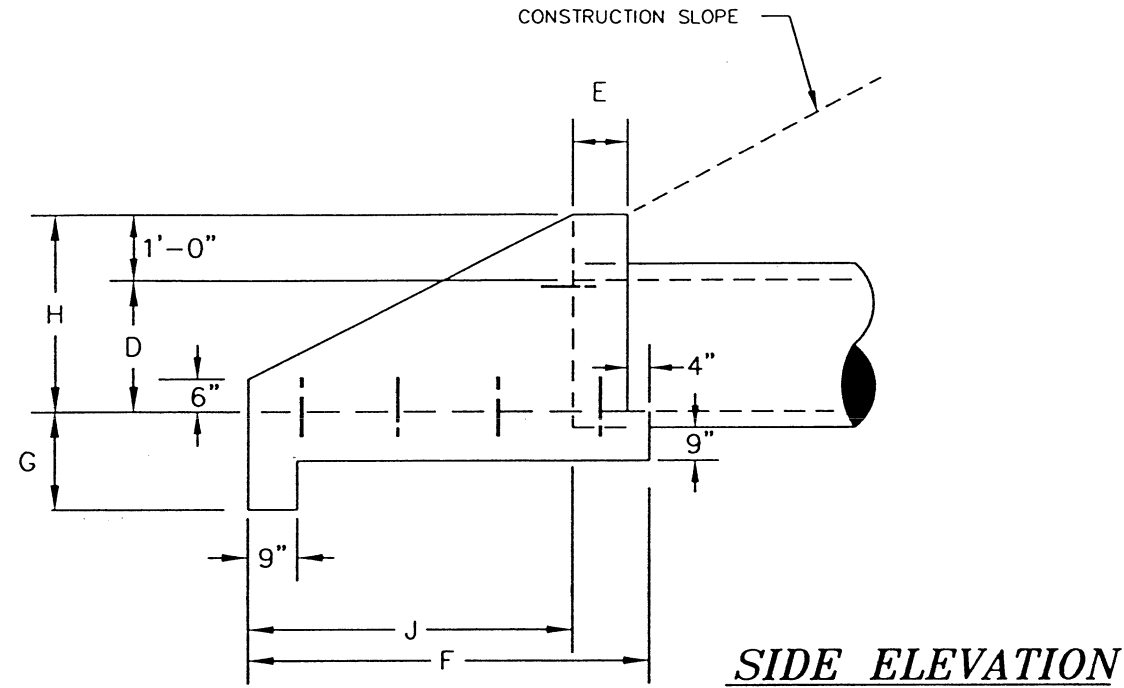


SIDE ELEVATION

NOTES

1. WHEN MORE THAN ONE LINE OF PIPE IS REQUIRED, THE DISTANCE FROM CENTER TO CENTER OF PIPES SHALL BE (D+1'-0").
2. A 1" CHAMFER SHALL BE USED ON EACH EXPOSED EDGE AND CORNER.
3. ENDWALLS SHALL HAVE #4 BARS AT 12" ON CENTER, EACH WAY, IN CENTER OF ALL SLABS AND WALLS.

TABLE OF DIMENSIONS TYPE "U", CONCRETE ENDWALL (SLOPE 1-1/2:1 & 2:1)						
DIMENSIONS						
OPENING	WALL			FOOTING		
D	L	H	E	J	F	G
1'-3"	3'-9"	2'-3"	9"	4'-0"	5'-1"	1'-3"
1'-6"	4'-0"	2'-6"	9"	4'-0"	5'-1"	1'-3"
2'-0"	4'-8"	3'-0"	10"	5'-0"	6'-2"	1'-6"
2'-6"	5'-2"	3'-6"	10"	6'-0"	7'-2"	1'-6"

TABLE OF DIMENSIONS TYPE "U", CONCRETE ENDWALL (SLOPE 3:1 OR FLATTER)						
DIMENSIONS						
OPENING	WALL			FOOTING		
D	L	H	E	J	F	G
1'-3"	3'-9"	2'-3"	9"	6'-0"	7'-1"	1'-3"
1'-6"	4'-0"	2'-6"	9"	6'-0"	7'-1"	1'-3"
2'-0"	4'-8"	3'-0"	10"	7'-6"	8'-8"	1'-6"
2'-6"	5'-2"	3'-6"	10"	9'-0"	10'-2"	1'-6"

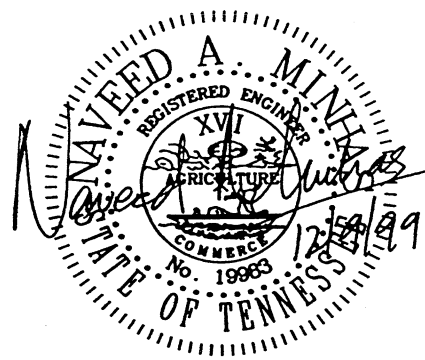


NO.	REVISION	DATE
0	INITIAL ISSUE	12/10/99


CITY OF CHATTANOOGA AND HAMILTON COUNTY
CONCRETE ENDWALL (TYPE "U")

DATE OF ORIGINAL ISSUE
DECEMBER 10, 1999


STANDARD NUMBER: SD-603.01

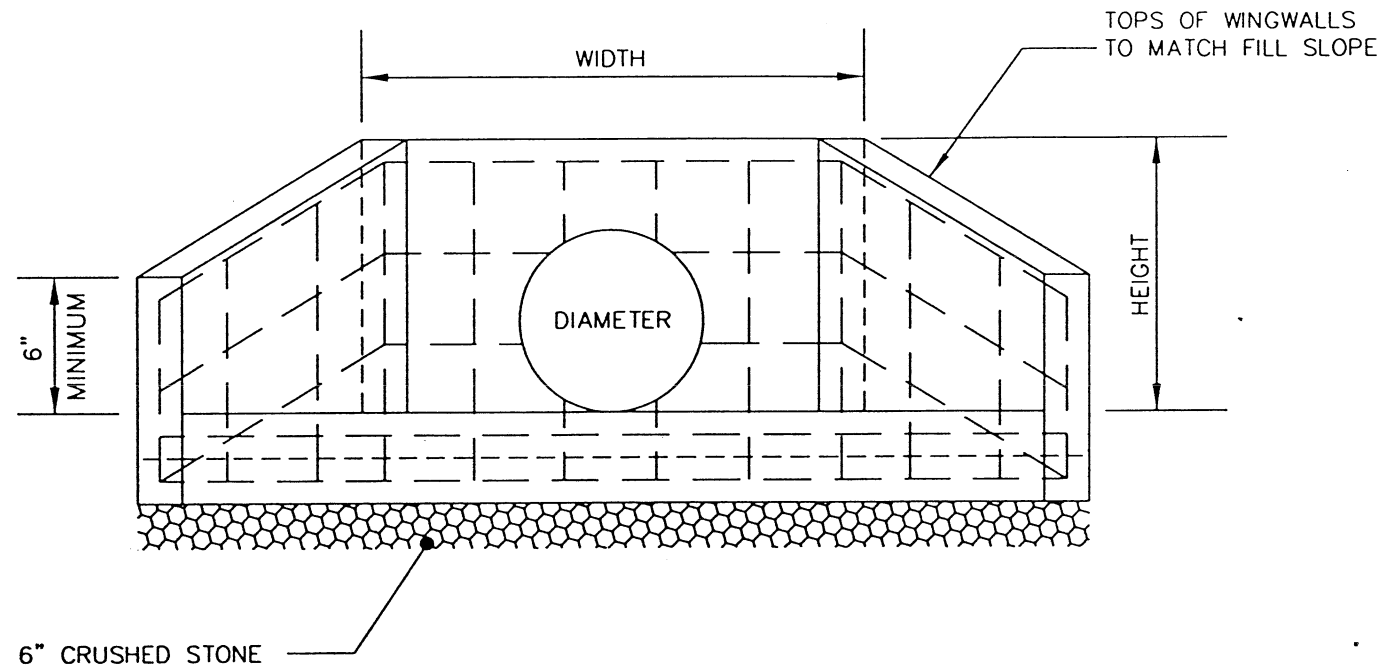

FRONT VIEW

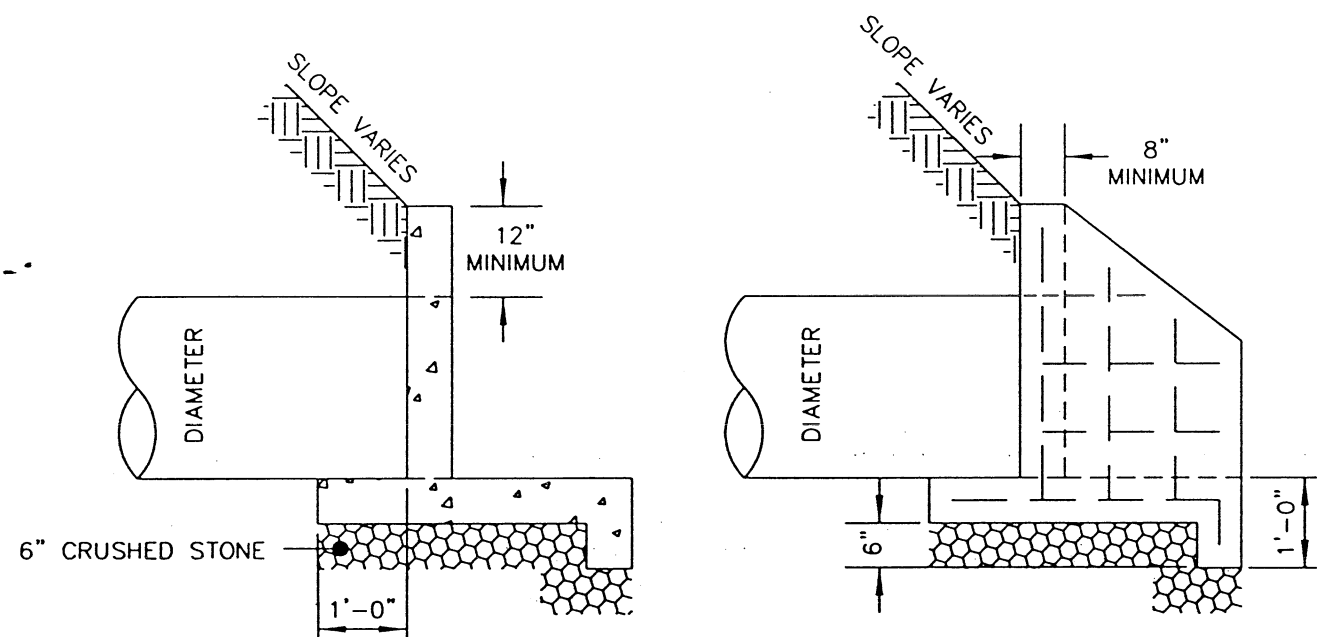

CROSS SECTION

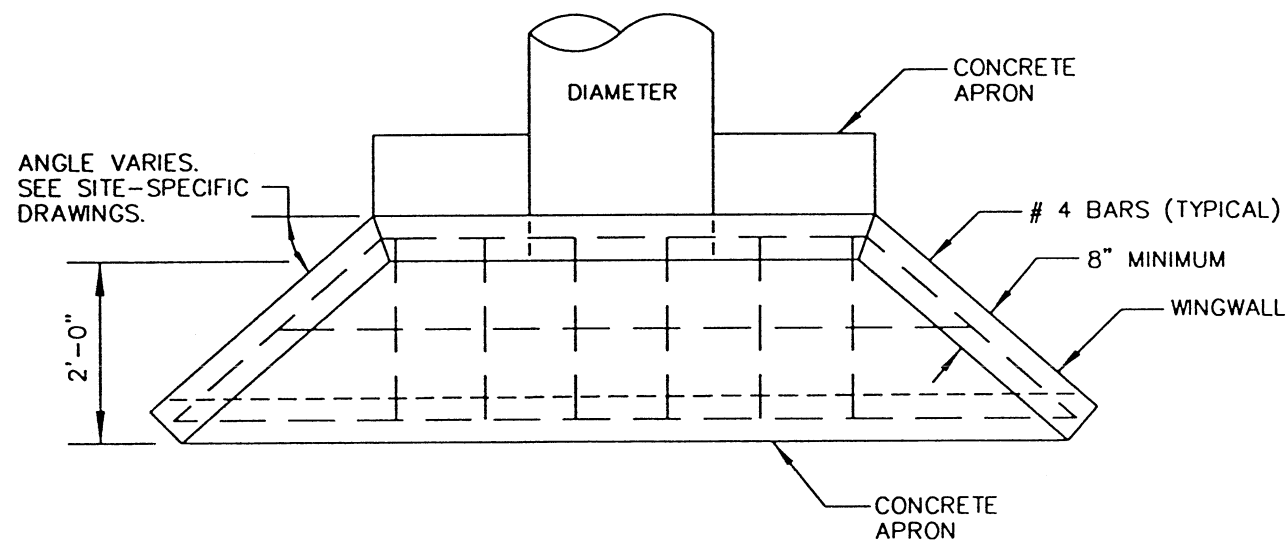



PLAN

PIPE SIZE CHART *				
DIAMETER	15"	18"	24"	30"
HEIGHT	2'-9"	3'-0"	3'-6"	4'-0"
WIDTH	4'-3"	4'-6"	5'-0"	5'-6"

* ALL DIMENSIONS SHOWN ARE MINIMUMS.

NOTES

1. IF CONDITIONS REQUIRE ANY VARIATION IN THE SIZE OF A WINGWALL, IT MUST FIRST BE APPROVED BY THE GOVERNMENTAL ENGINEER BEFORE CONSTRUCTION BEGINS.
2. ALL REINFORCING STEEL SHALL HAVE A 2" (MINIMUM) CONCRETE COVER.
3. SEE PIPE SIZE CHART FOR DIMENSIONS ASSOCIATED WITH PIPE DIAMETERS.
4. A 1" CHAMFER SHALL BE USED ON EACH EXPOSED EDGE AND CORNER.
5. #4 BARS (TYPICAL) SHALL BE @ 1'-0" C.C. EACH WAY IN THE CENTER OF SLABS AND WALLS.

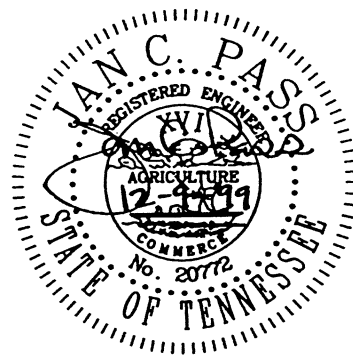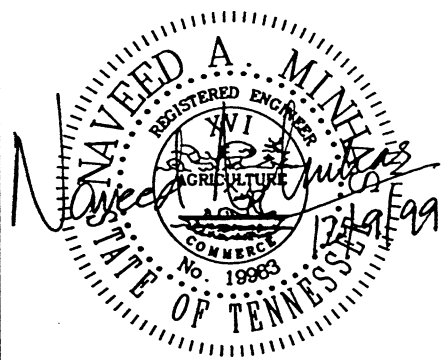


0	INITIAL ISSUE	12/10/99
NO.	REVISION	DATE

CITY OF CHATTANOOGA AND HAMILTON COUNTY
CONCRETE ENDWALL (TYPE "W")

DATE OF ORIGINAL ISSUE
DECEMBER 10, 1999

STANDARD NUMBER: SD-604.01

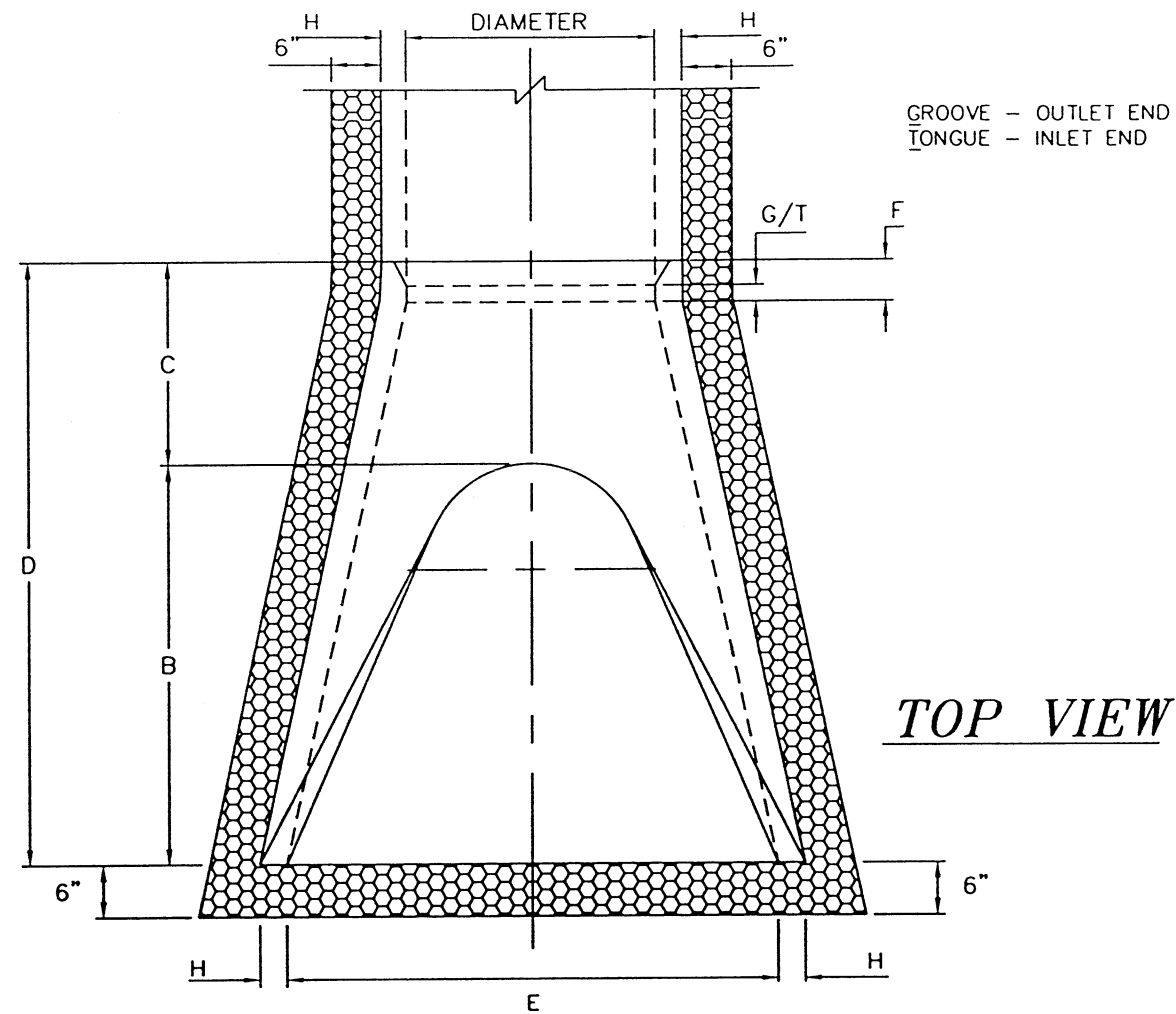


TOP VIEW

FLARED-END SECTION DIMENSIONS (INCHES)


PIPE SIZE	A	B	C	D	E	F	G/T	H
15"	6.0	27.0	46.00	73.00	30	3.5	2.0	2.25
18"	9.0	27.0	46.00	73.00	36	4.0	2.5	2.50
24"	9.5	43.5	30.00	73.50	48	4.5	2.5	3.00
30"	12	54.0	19.75	73.75	60	5.0	3.0	3.25

NOTES


G DENOTES GROOVE - OUTLET END.
T DENOTES TONGUE - INLET END.
H DENOTES THE WALL THICKNESS.

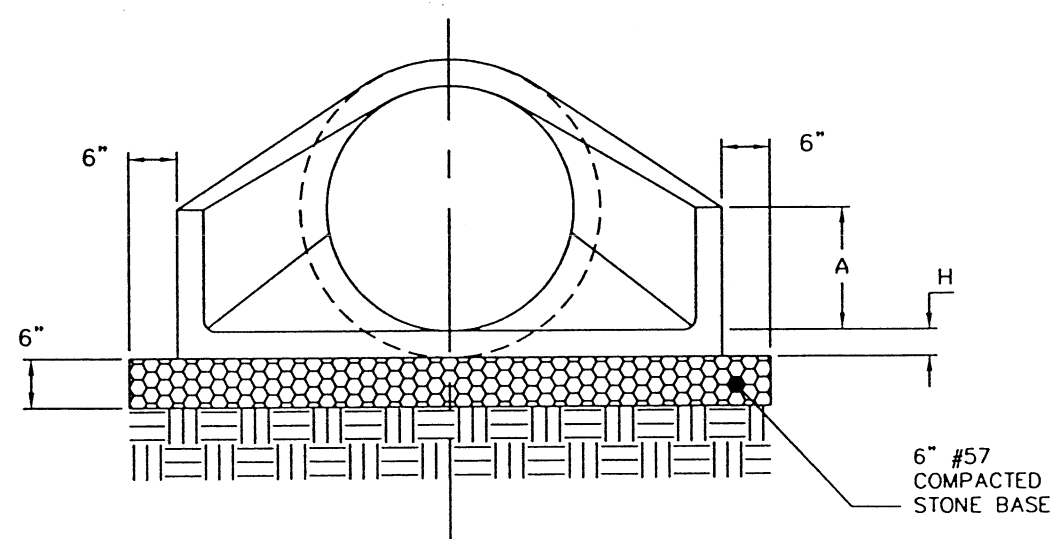

FRONT VIEW

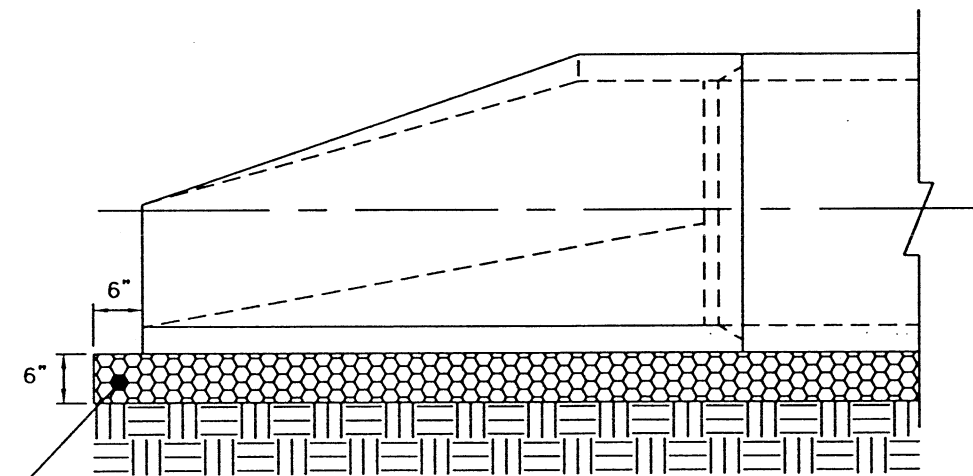


RIGHT SIDE VIEW

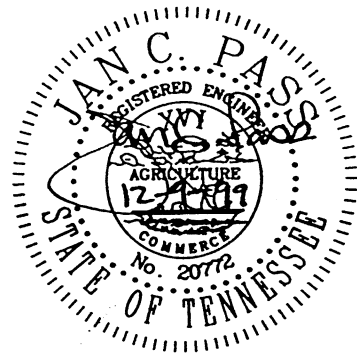


			CITY OF CHATTANOOGA AND HAMILTON COUNTY	
			CONCRETE ENDWALL (PRECAST/FLARED)	
			DATE OF ORIGINAL ISSUE	STANDARD NUMBER : SD-605.01
			DECEMBER 10, 1999	
0	INITIAL ISSUE	12/10/99		
NO.	REVISION	DATE		


F:\STDWGS\DropInlet\DropInlet.dwg Thu Dec 09 08:07:14 1999 STATIONS 2-

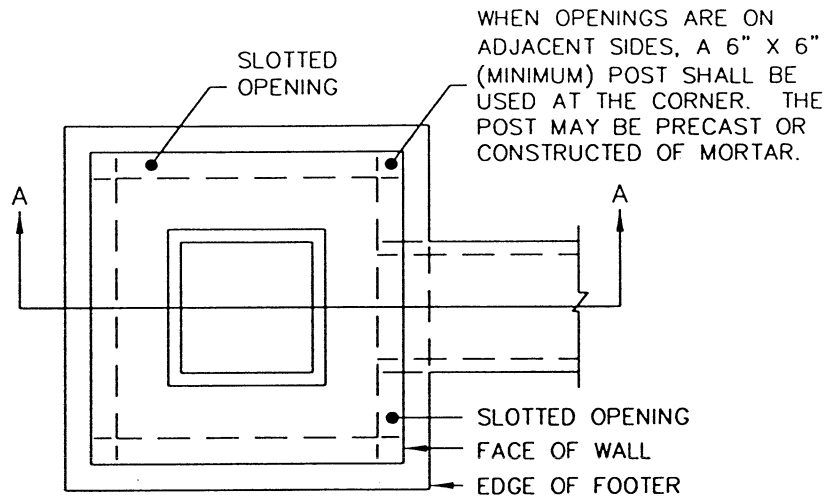

PLAN

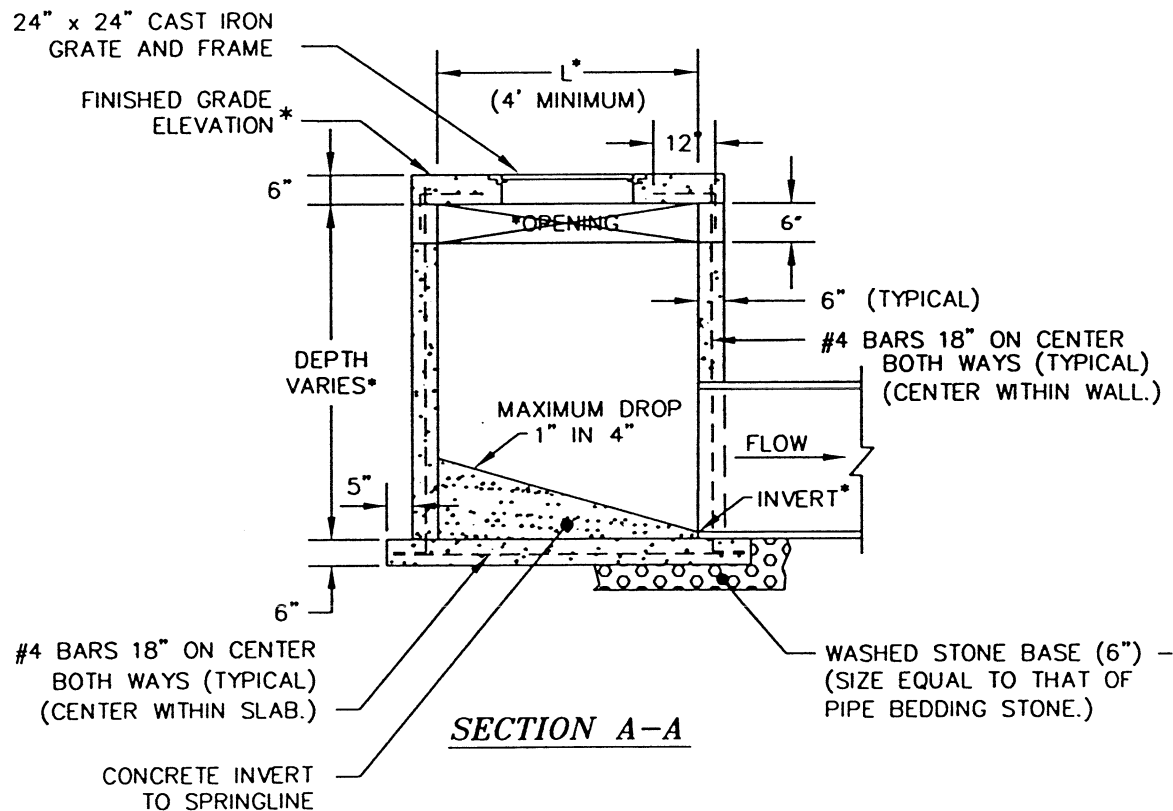

SECTION A-A

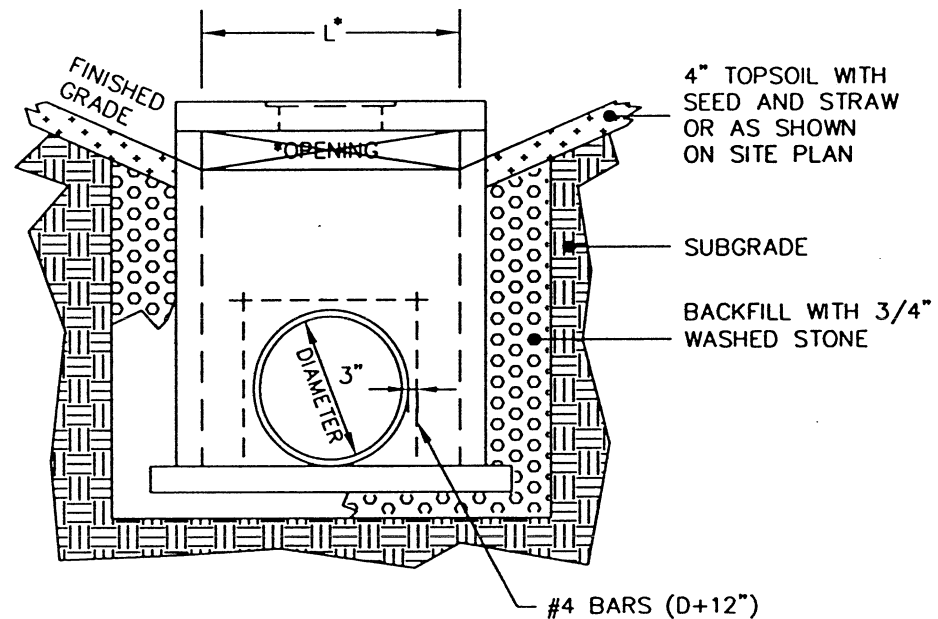


SIDE VIEW

NOTES

1. WHEN THE DEPTH OF THE STRUCTURE IS GREATER THAN 4'-0", STEPS SHALL BE PROVIDED AT 16" ON CENTER.
2. PRECAST ELEMENTS SHALL BE ALLOWED UP TO THE BOTTOM OF THE OPENING, WITH DOWELS ON 12" CENTERS SECURING THE REMAINDER THAT SHALL BE CAST-IN-PLACE CONCRETE.
3. CONCRETE CONSTRUCTION IS SHOWING, BUT 8" BRICK CONSTRUCTION WILL BE ALLOWED.

* SEE SITE-SPECIFIC PLANS AND PROFILES FOR 'L', DEPTHS, ELEVATIONS, AND NUMBER AND LOCATIONS OF OPENINGS.

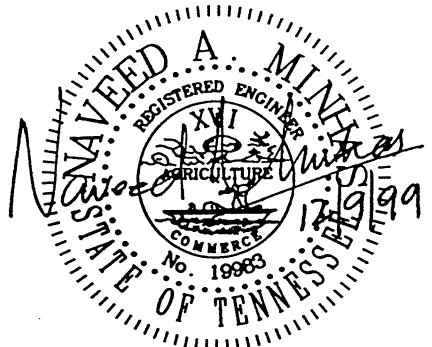


0	INITIAL ISSUE	12/10/99
NO.	REVISION	DATE


CITY OF CHATTANOOGA AND HAMILTON COUNTY
DROP INLET

DATE OF ORIGINAL ISSUE
DECEMBER 10, 1999

STANDARD NUMBER: SD-606.01

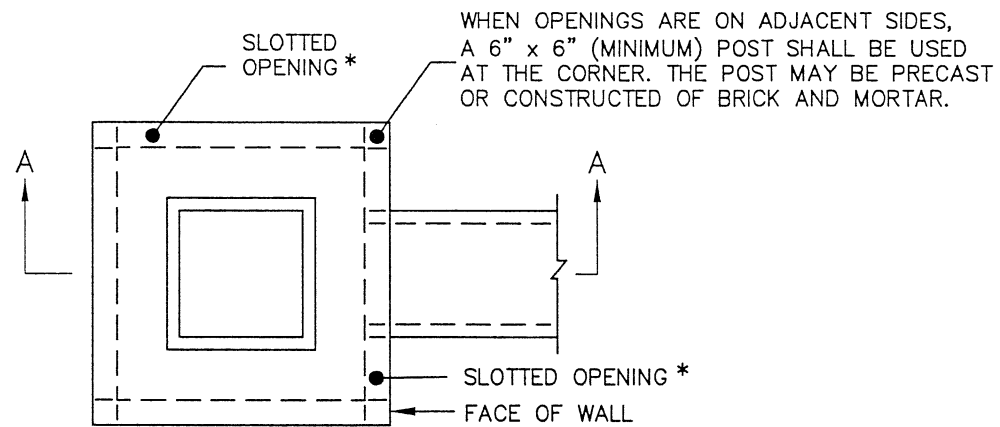


PLAN
SQUARE BASIN
(48" x 48" MINIMUM) **

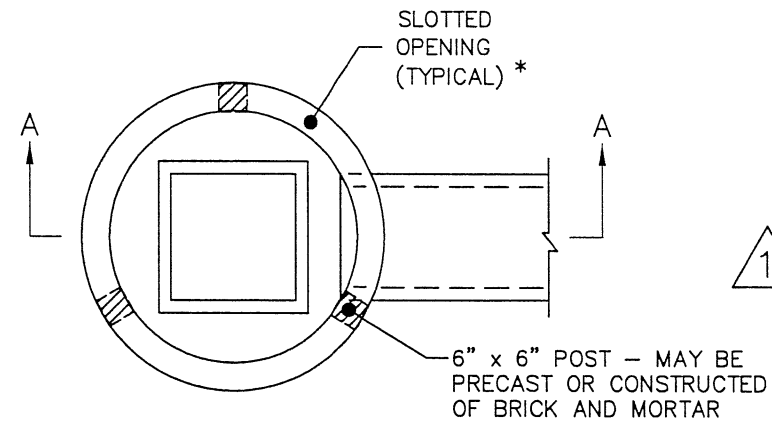


PLAN
ROUND MANHOLE TYPE
(48" DIAMETER - 96" DIAMETER)

NOTES

1. STEPS SHALL BE PROVIDED WHEN THE DEPTH OF THE STRUCTURE IS GREATER THAN 4'-0". STEPS SHALL BE PLACED ON 16" CENTERS.
2. SQUARE INLETS MAY HAVE FOUR OPENINGS AND MAY BE LOCATED ON ANY OR ALL SIDES. ROUND-MANHOLE-TYPE DROP INLETS MAY HAVE A MAXIMUM OF THREE OPENINGS.
- ** 3. SQUARE INLETS SHALL MEET A.S.T.M. C 913 REQUIREMENTS FOR WALL THICKNESS, SLAB THICKNESS, CONCRETE STRENGTH, AND STEEL REINFORCEMENT REQUIREMENTS. ROUND INLETS SHALL MEET A.S.T.M. C 478.
4. THE TOP AND ITS SUPPORTS MAY BE PRECAST AS ONE UNIT.

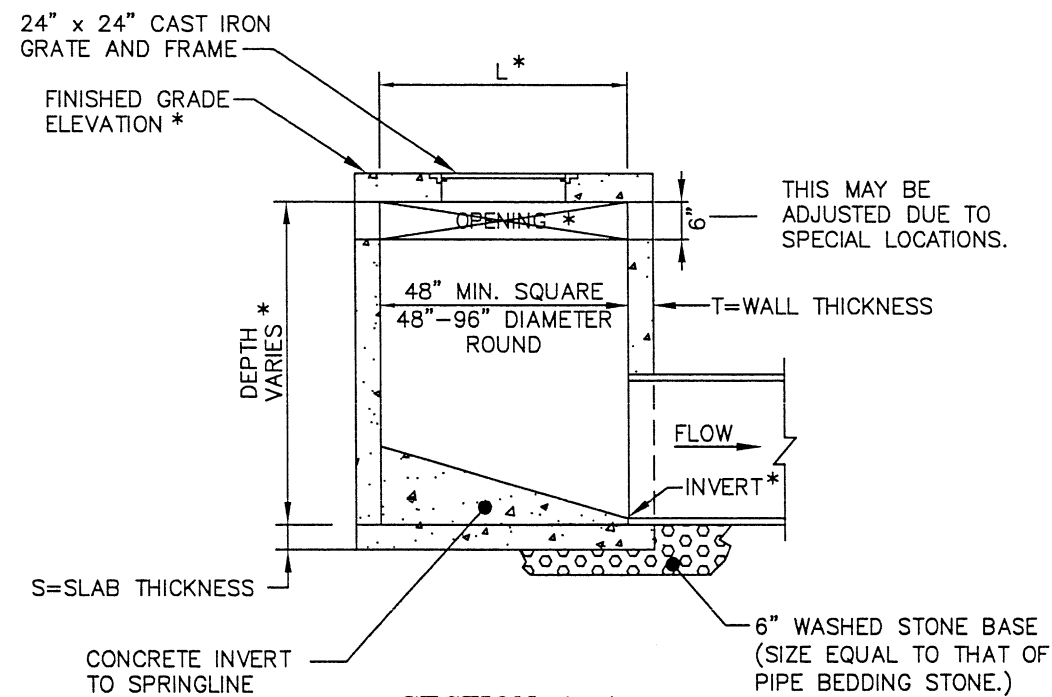

SECTION A-A

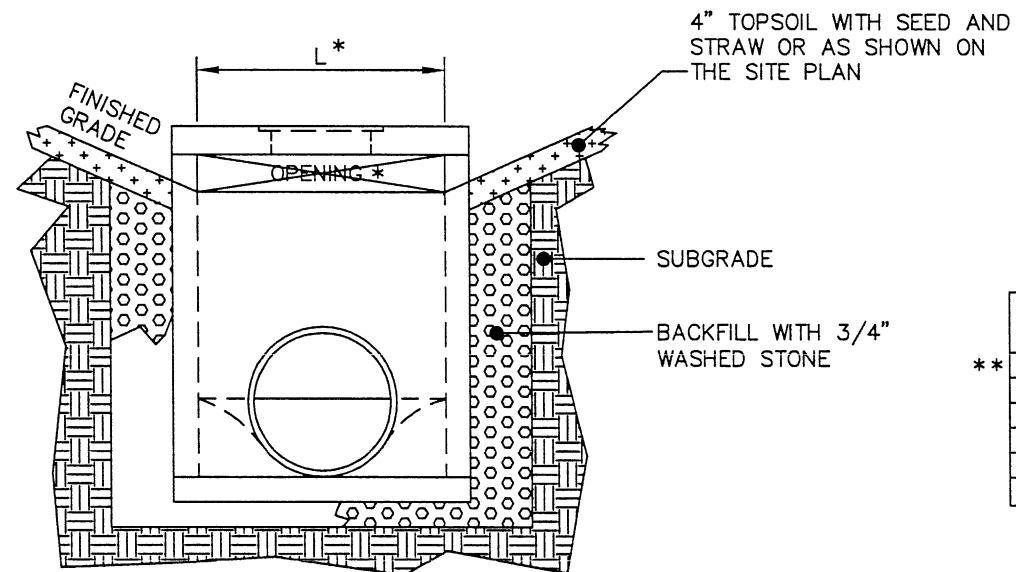

SIDE VIEW



STRUCTURE TYPE	(T) WALL THICKNESS	(S) SLAB THICKNESS
48" x 48"	8"	8"
48" DIAM.	5"	6"
60" DIAM.	6"	8"
72" DIAM.	7"	8"
84" DIAM.	8"	8"
96" DIAM.	8"	8"

* SEE SITE-SPECIFIC PLANS AND PROFILES FOR 'L', DEPTHS, ELEVATIONS, AND NUMBER AND LOCATIONS OF OPENINGS.

** LARGER SIZES MEETING A.S.T.M. C 913 REQUIREMENTS ARE AVAILABLE UPON REQUEST.




F:\New Folder\detail-1.dwg

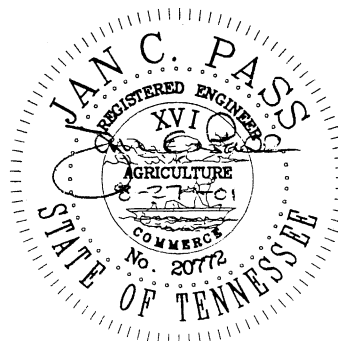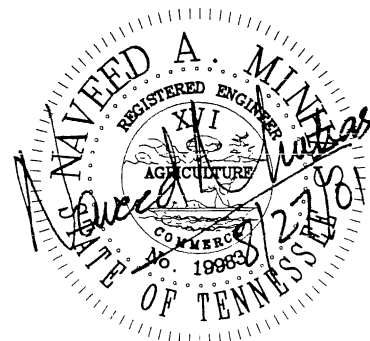


CITY OF CHATTANOOGA AND HAMILTON COUNTY			
DROP INLET (PRECAST CONCRETE)			
1	REVISIONS AS MARKED OR CLOUDED	8/24/01	DATE OF ORIGINAL ISSUE
0	INITIAL ISSUE	12/10/99	DECEMBER 10, 1999
NO.	REVISION	DATE	STANDARD NUMBER: SD-607.01

F:\STDDWG\StdCatchBasin\STDCB1_1.dwg

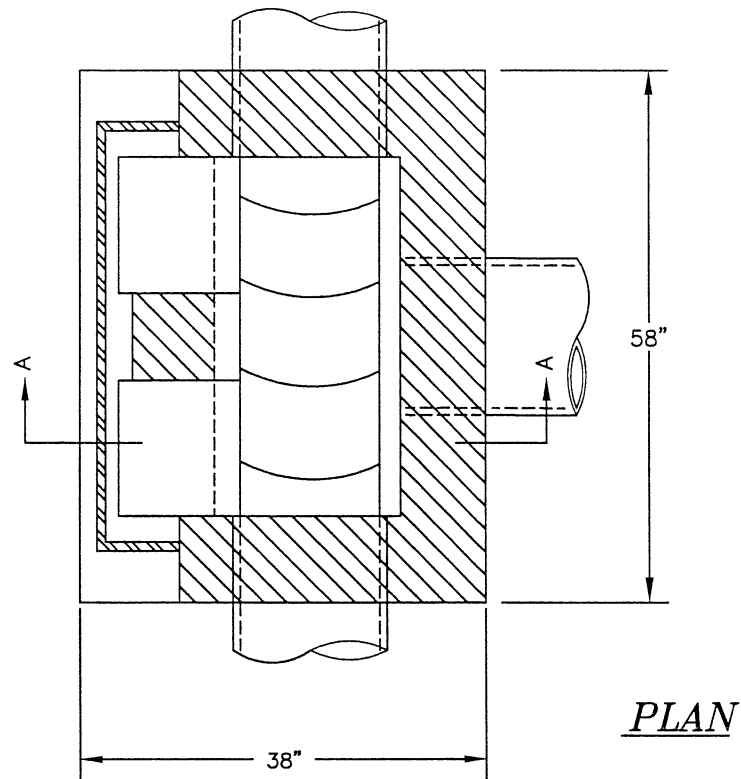


PLAN

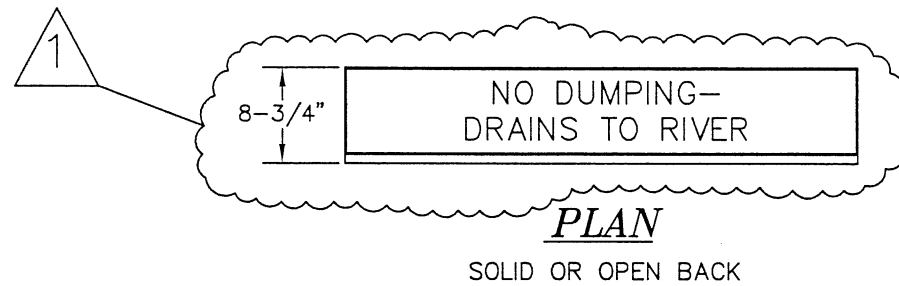


PLAN

SOLID OR OPEN BACK

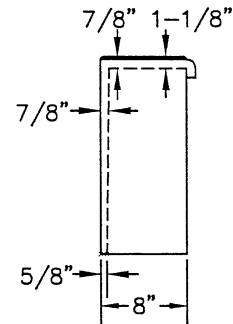


SIDE VIEW

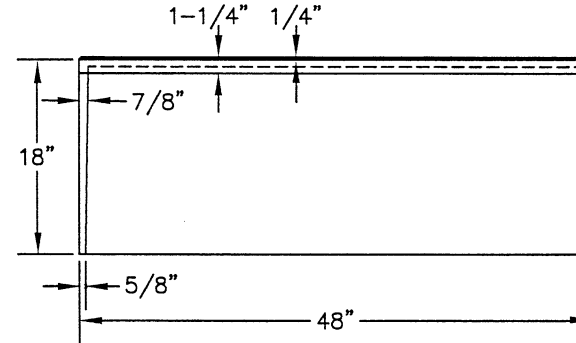


FRONT VIEW

SOLID BACK

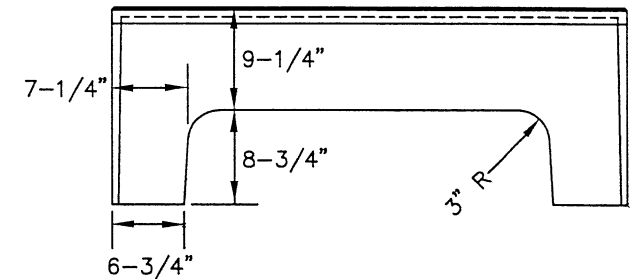

FRONT VIEW

OPEN BACK

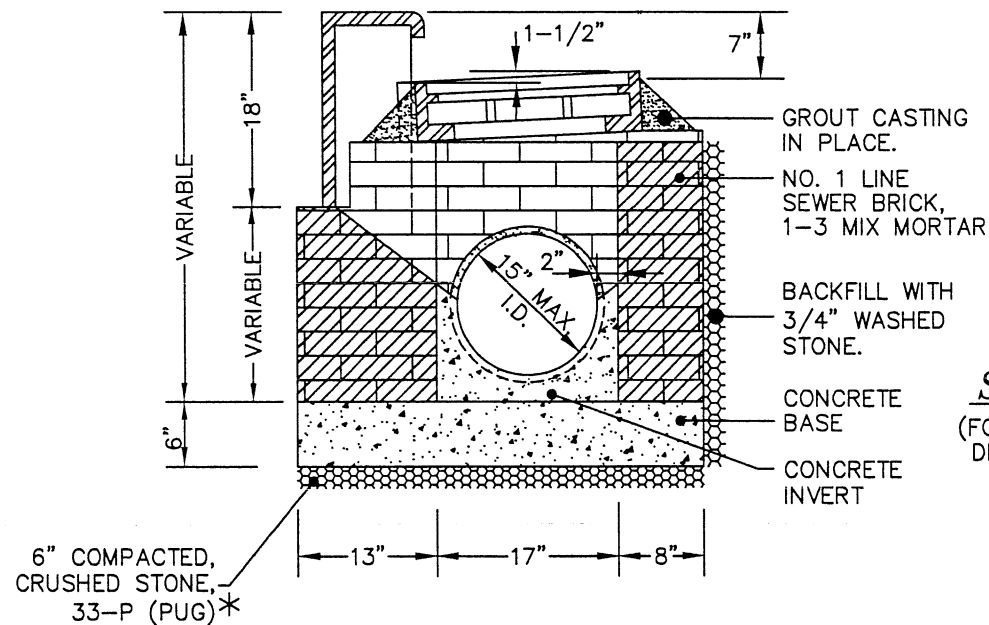

SECTION A-A

(FOR CLARITY, THE CROSS DRAIN IS NOT SHOWN.)



CURB IRON OR UPRIGHT FRAME

* "33-P (PUG)" - 303-01, TYPE A, GRADING D ("33-P"), TENNESSEE D.O.T. SPECIFICATIONS.

NOTE


FOR BRICK CONSTRUCTION, JOINTS SHALL ALWAYS BE COMPLETELY FILLED WITH MORTAR. BRICKS SHALL BE LAID WITH VERTICAL MORTAR JOINTS NOT MORE THAN 3/8" THICK AND HORIZONTAL MORTAR JOINTS NOT LESS THAN 3/8" THICK AT THE INSIDE FACE. INSIDE JOINTS SHALL BE TROWEL STRUCK, FLUSH JOINTS TO PROVIDE A SMOOTH, CLEAN SURFACE, WHILE OUTSIDE WALLS SHALL BE ENTIRELY COVERED WITH MORTAR FOR A SMOOTH, CLEAN SURFACE.

CATCH BASIN WITH BACK

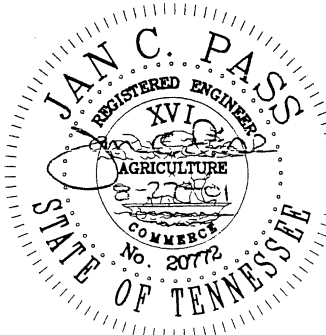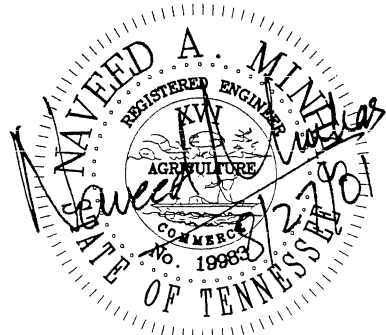


CITY OF CHATTANOOGA AND HAMILTON COUNTY			
CATCH BASIN (STANDARD), FRAME, AND GRATE			
1	REVISIONS AS MARKED OR CLOUDED	8/24/01	DATE OF ORIGINAL ISSUE
0	INITIAL ISSUE	12/10/99	DECEMBER 10, 1999
NO.	REVISION	DATE	STANDARD NUMBER: SD-608.01

F:\STDDWGS\StdCatchBasin\STDCB1_2.dwg

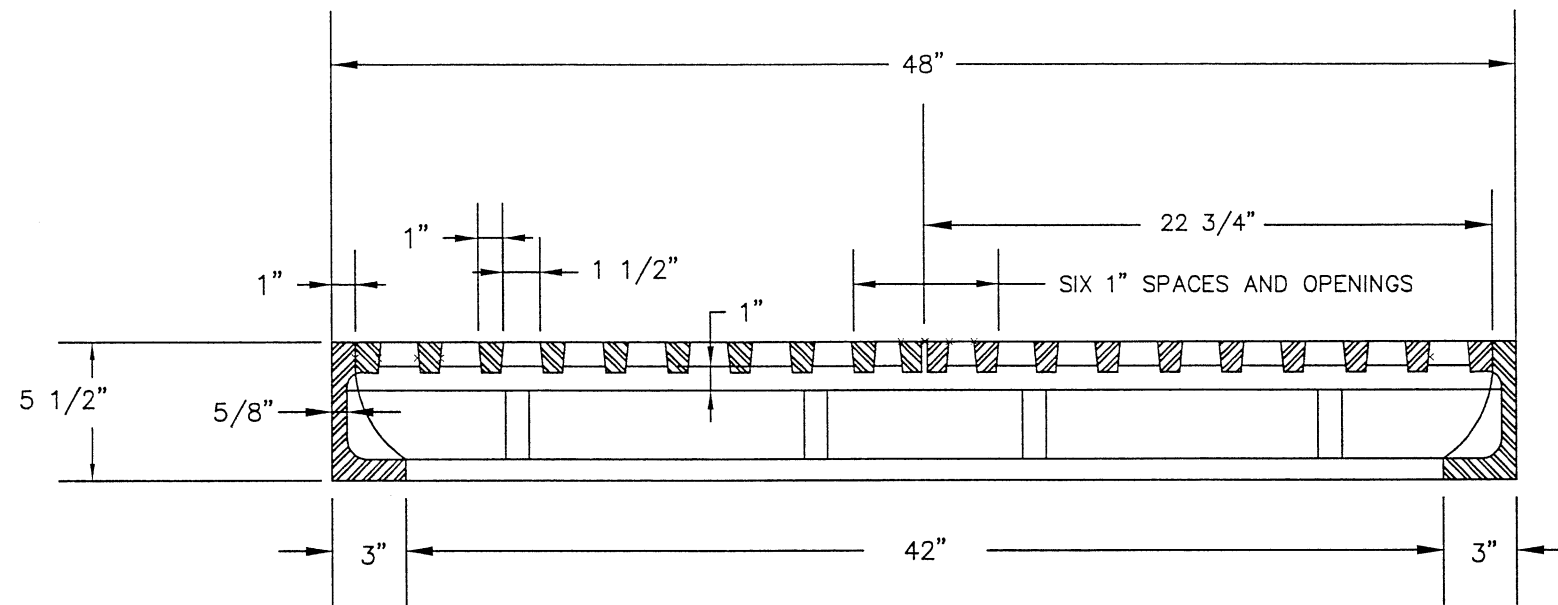

SECTION C-C

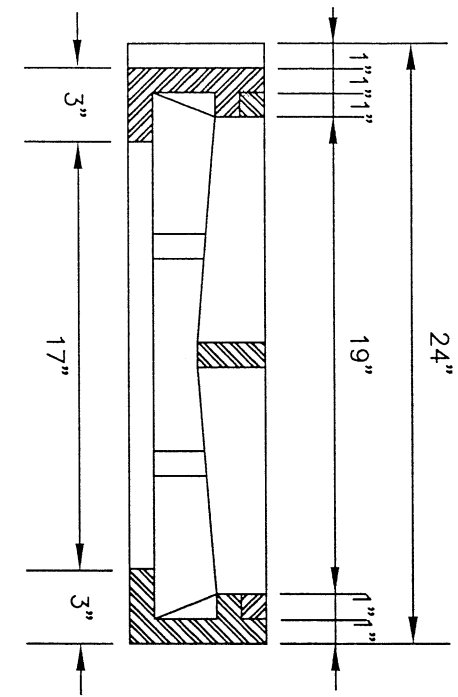

SECTION B-B


NOTES

1. BRICKS SHALL BE GRADE MA, MEDIUM HARD OR BETTER, AND SHALL CONFORM TO THE LATEST A.S.T.M. C-32.
2. CAST IRON STEPS, FRAMES, GRATES, AND CURB IRONS SHALL CONFORM TO THE MINIMUM REQUIREMENTS OF A.A.S.H.T.O. M-105.

PRECAST STRUCTURES



3. THESE MAY BE USED IN LIEU OF BRICK OR CAST-IN-PLACE CONCRETE STRUCTURES.
4. THESE SHALL HAVE MINIMUM INSIDE DIMENSIONS OF 28" X 63".
5. ACHESON (#V-4078-2) FRAME AND GRATE X 2, OR EQUAL, SHALL BE USED FOR THESE STRUCTURES.
6. WALL THICKNESS, CONCRETE STRENGTH, AND STEEL REINFORCEMENT SHALL MEET A.S.T.M. C-913.

1

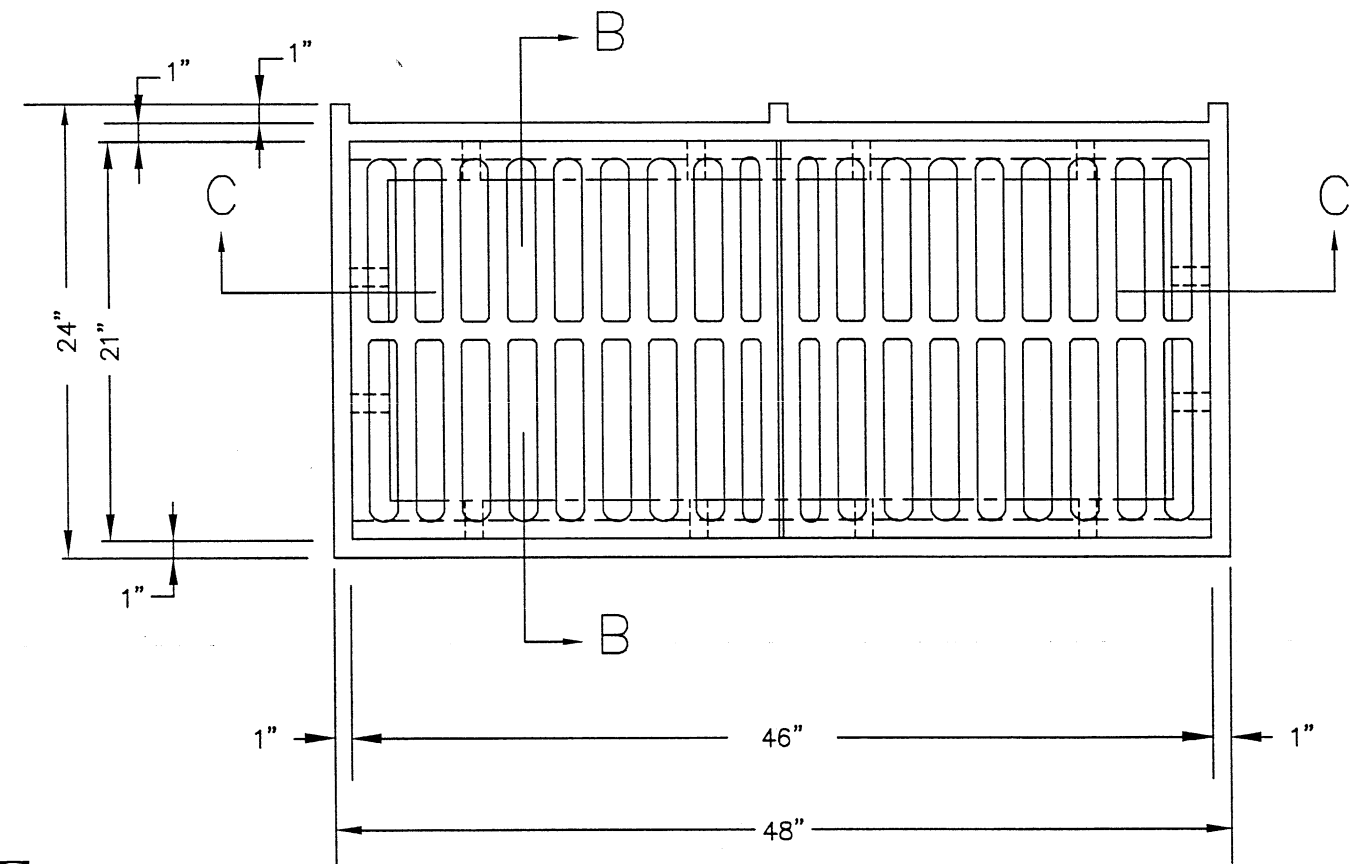


PLAN

GRATE

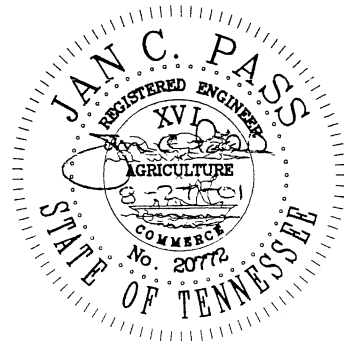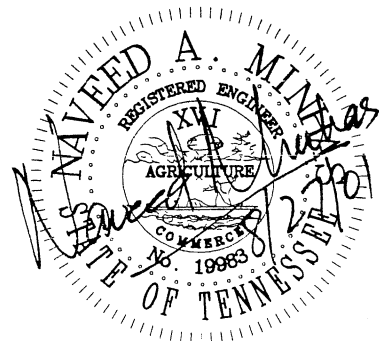

CITY OF CHATTANOOGA AND HAMILTON COUNTY			
CATCH BASIN (STANDARD), FRAME, AND GRATE			
1	REVISIONS AS MARKED OR CLOUDED	8/24/01	DATE OF ORIGINAL ISSUE
0	INITIAL ISSUE	12/10/99	DECEMBER 10, 1999
NO.	REVISION	DATE	STANDARD NUMBER: SD-608.02


F:\STDWGS\CurbInlet\C-INLET_1.dwg Wed Dec 08 15:25:39 1999 STATIONS 24

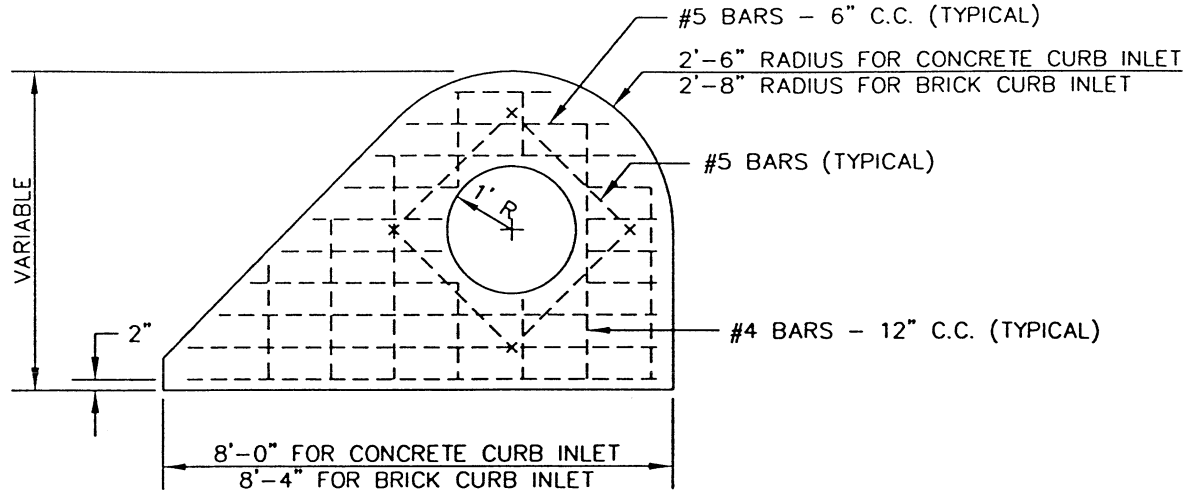


LEFT HAND TOP SLAB

(D) = 4'-0"

TOP 18" OF BARREL SHALL BE
CAST-IN-PLACE CONCRETE.
LOWER PORTION MAY BE PRECAST
OR CAST-IN-PLACE.

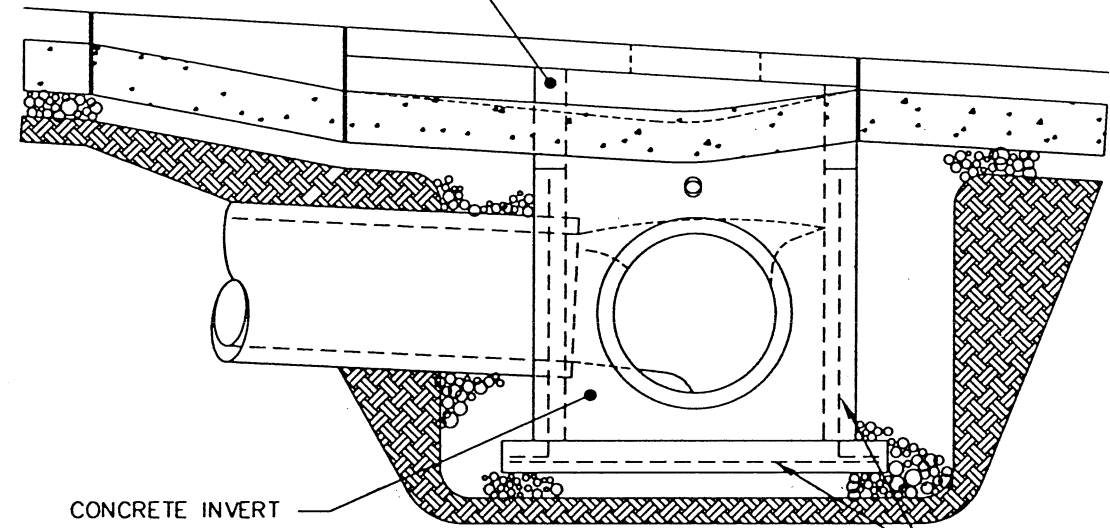

SECTION A-A

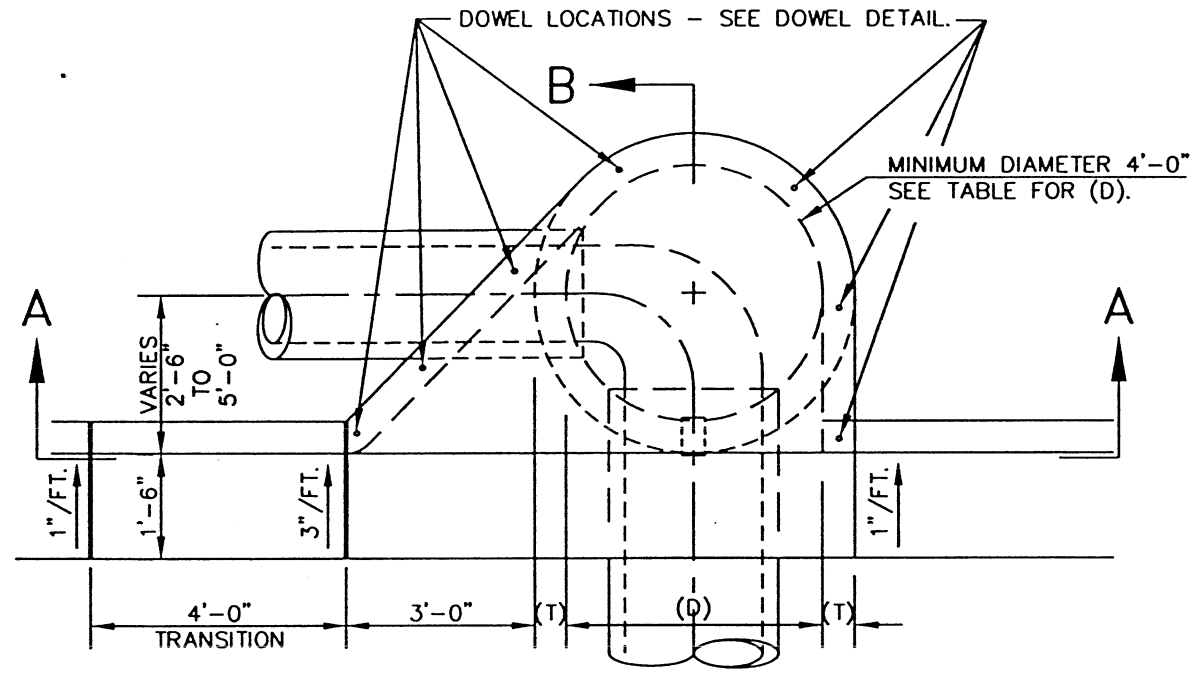


ECCENTRIC CURB INLET *


LEFT HAND PLAN - CONCRETE CONSTRUCTION
SHOWN, BUT BRICK MAY BE USED.

VARIES FROM 0'-0" TO 2'-6"
TO ACCOMODATE EXISTING PIPING
WITHIN THESE LIMITS

MAINTAIN SLOPE TO
AVOID ACCUMULATION
OF SEDIMENT.

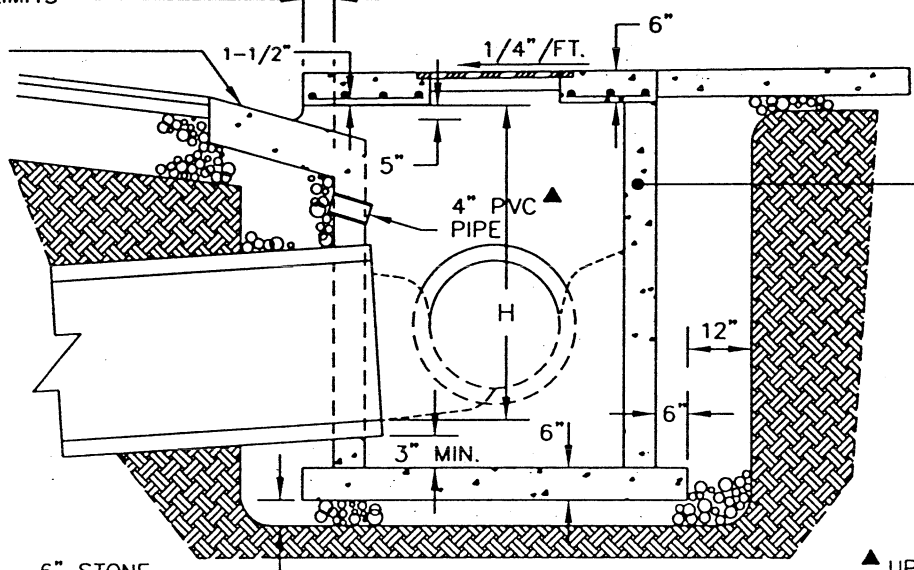


SECTION B-B

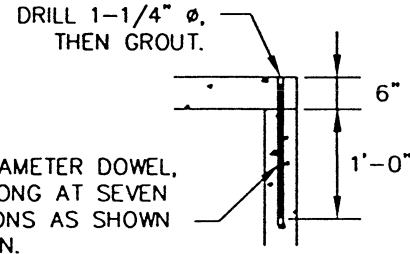


DOWEL DETAIL

5/8" DIAMETER DOWEL,
1'-4" LONG AT SEVEN
LOCATIONS AS SHOWN
ON PLAN.

* SEE "NOTE" AT
BOTTOM OF
SD-609.02.

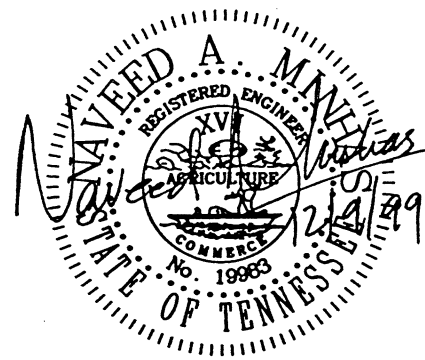


CITY OF CHATTANOOGA AND HAMILTON COUNTY			
CURB INLET (CONCRETE/BRICK)			
DATE OF ORIGINAL ISSUE		STANDARD NUMBER: SD-609.01	
DECEMBER 10, 1999			
0	INITIAL ISSUE	12/10/99	
NO.	REVISION	DATE	

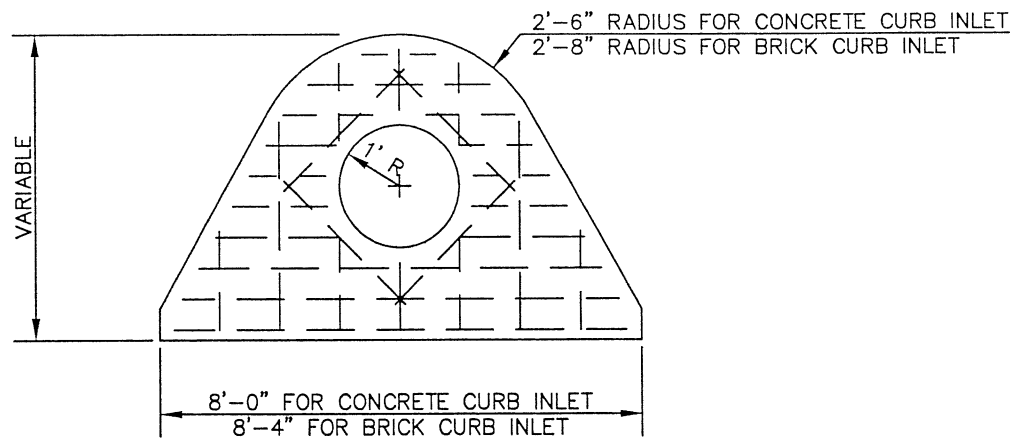

SUMP INLET TOP SLAB

(D) = 4'-0"

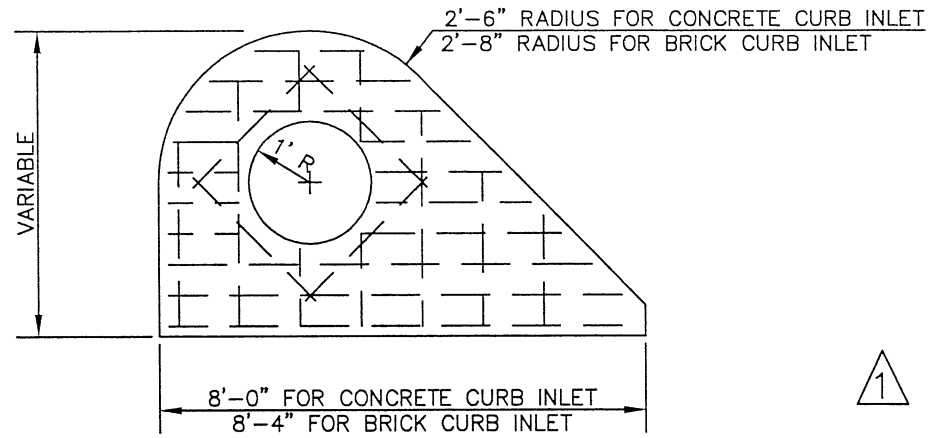


RIGHT HAND TOP SLAB

(D) = 4'-0"


NOTES

1. THE TOP COVER IS TO BE PRECAST AND ATTACHED WITH GROUTED DOWELS.
2. MANHOLE STEPS ON 16" CENTERS SHALL BE PROVIDED WHEN CURB INLET DEPTH EXCEEDS FOUR (4) FEET.
3. THE MANHOLE FRAME AND COVER SHALL BE ACHESON FOUNDRY CASTING A-2522-41C OR EQUAL.
4. THE WORDS "NO DUMPING-DRAINS TO RIVER" ARE TO BE ON THE TOP SIDE OF EACH COVER. (SEE SD-301.03.)
5. CATCH BASIN FRAMES, BACKS, AND GRATES THAT ARE REMOVED BY THE CONTRACTOR SHALL REMAIN THE PROPERTY OF THE OWNER.

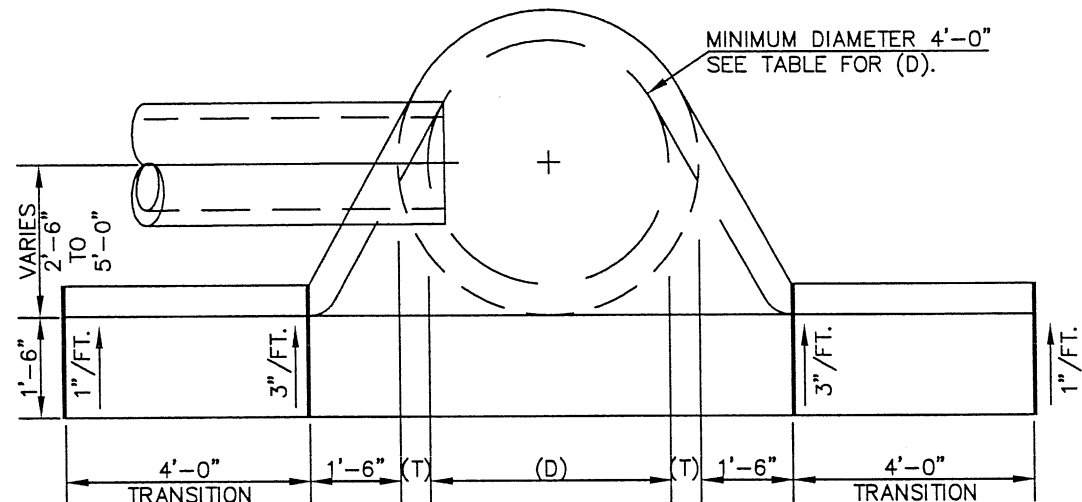

SUMP INLET *

CONCRETE CONSTRUCTION SHOWN, BUT BRICK MAY BE USED.

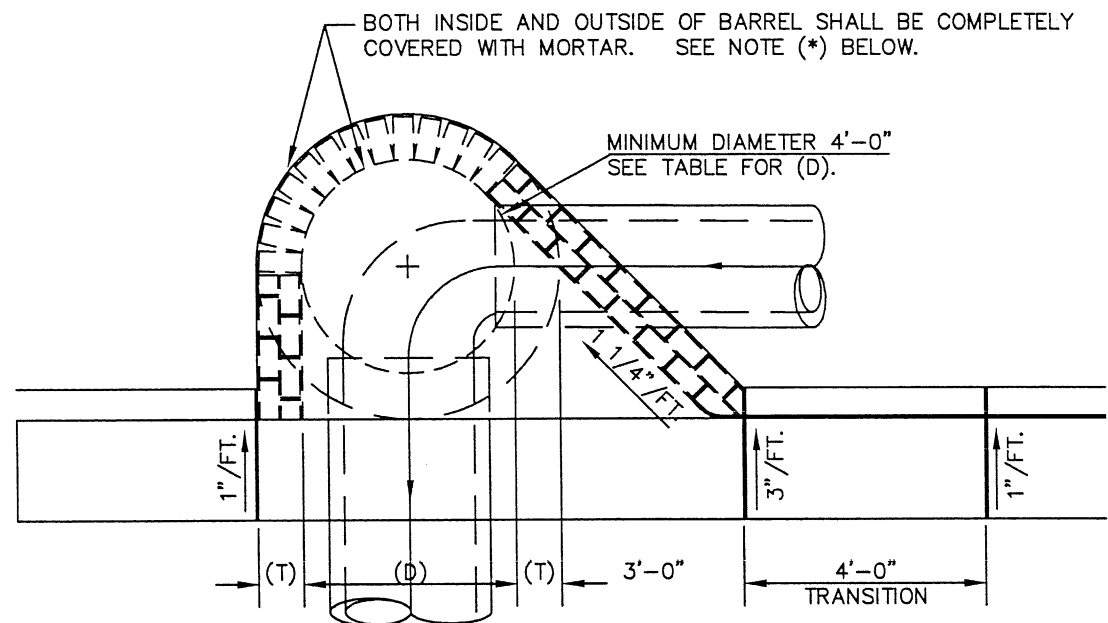



ECCENTRIC CURB INLET *

RIGHT HAND PLAN - BRICK CONSTRUCTION SHOWN, BUT CONCRETE MAY BE USED.

PIPE SIZE		(D) INLET DIAMETER	(T) WALL THICKNESS		(H) MINIMUM DEPTH
			CONC.	BRICK	
12"		4'	6"	8"	2.83'
15"		4'	6"	8"	3.10'
18"		4'	6"	8"	3.38'
21"		4'	6"	8"	3.65'
24"		4'	6"	8"	3.92'
30"		4'	6"	8"	4.46'
36"		5'	8"	12"	5.00'
42"		5'	8"	12"	5.54'
48"		6'	8"	12"	6.08'
54"		7'	8"	12"	6.63'
60"		8'	8"	12"	7.17'
SPAN	RISE				
14"	9"	4'	6"	8"	2.42'
17"	13"	4'	6"	8"	2.75'
21"	15"	4'	6"	8"	2.92'
24"	18"	4'	6"	8"	3.21'
28"	20"	4'	6"	8"	3.38'
35"	24"	5'	8"	12"	3.71'
42"	29"	5'	8"	12"	4.17'
49"	33"	6'	8"	12"	4.50'
57"	38"	6'	8"	12"	4.92'
64"	43"	7'	8"	12"	5.33'

*** NOTE**

FOR BRICK CONSTRUCTION, JOINTS SHALL ALWAYS BE COMPLETELY FILLED WITH MORTAR. BRICKS SHALL BE LAID RADially WITH VERTICAL MORTAR JOINTS NOT MORE THAN 3/8" THICK AND HORIZONTAL MORTAR JOINTS NOT LESS THAN 3/8" THICK AT THE INSIDE FACE. INSIDE JOINTS SHALL BE TROWEL STRUCK, FLUSH JOINTS TO PROVIDE A SMOOTH, CLEAN SURFACE, WHILE OUTSIDE WALLS SHALL BE ENTIRELY COVERED WITH MORTAR FOR A SMOOTH, CLEAN SURFACE.

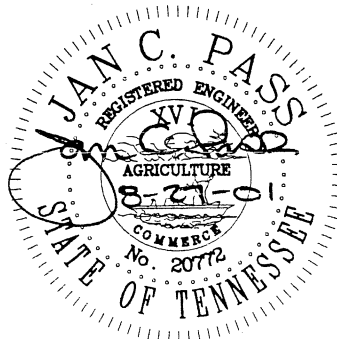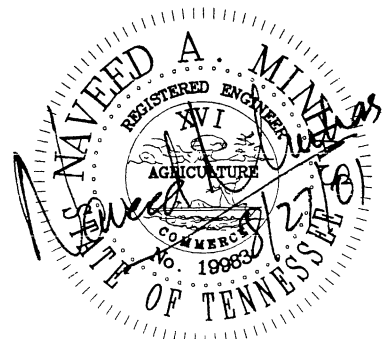


CITY OF CHATTANOOGA AND HAMILTON COUNTY
CURB INLET (CONCRETE/BRICK)


NO.	REVISION	DATE
1	REVISIONS AS MARKED OR CLOUDED	8/24/01
0	INITIAL ISSUE	12/10/99

DATE OF ORIGINAL ISSUE
DECEMBER 10, 1999


STANDARD NUMBER: **SD-609.02**

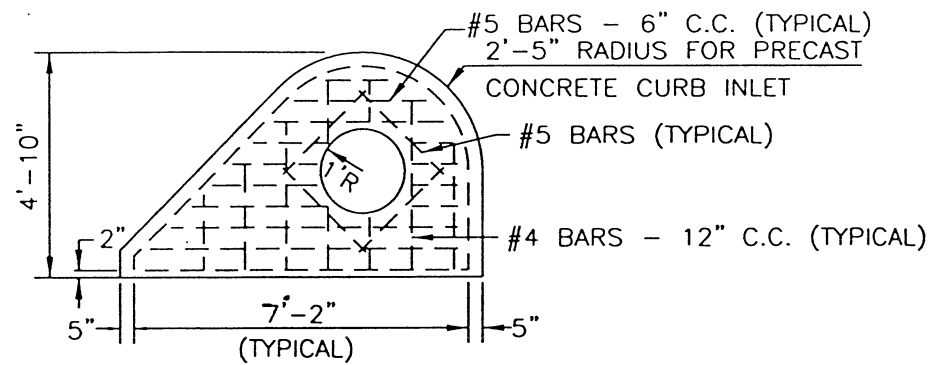


LEFT HAND TOP SECTION
(D) = 4'-8''

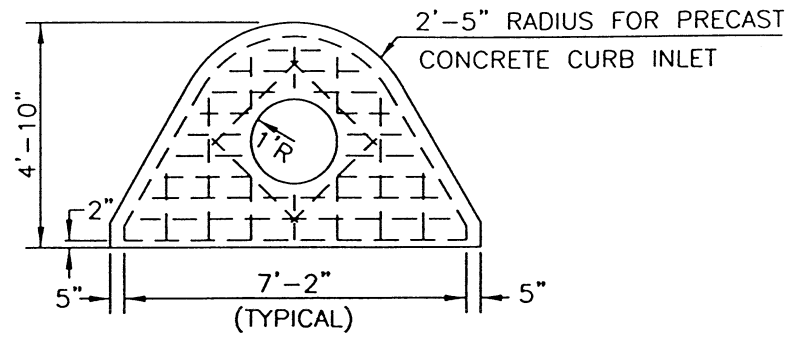


SUMP INLET TOP SECTION
(D) = 4'-8''

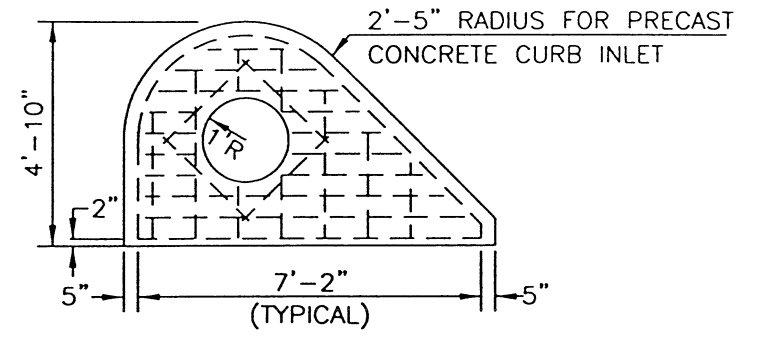


RIGHT HAND TOP SECTION
(D) = 4'-8''

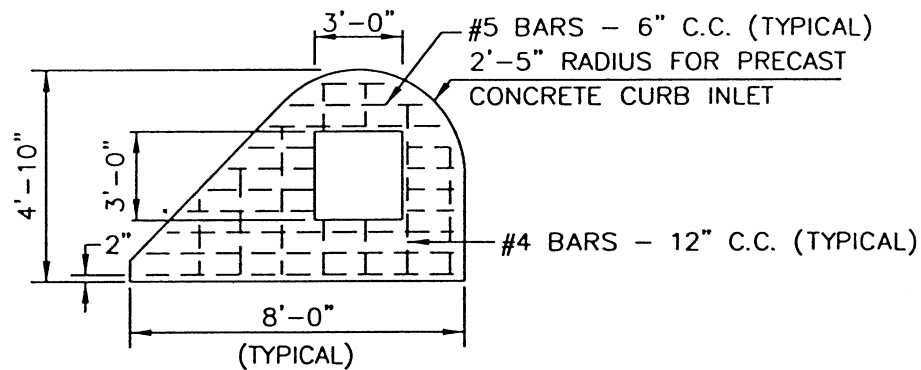


LEFT HAND BOTTOM SECTION
(D) = 4'-8''

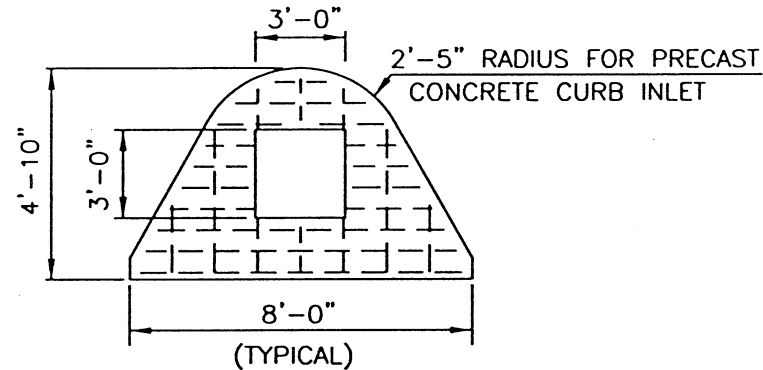


SUMP INLET BOTTOM SECTION
(D) = 4'-8''

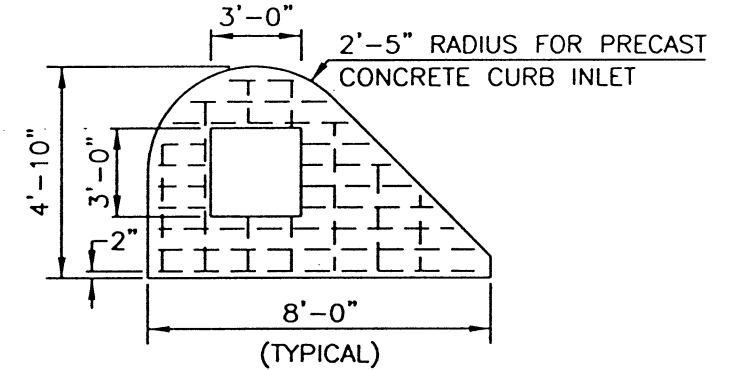


RIGHT HAND BOTTOM SECTION
(D) = 4'-8''

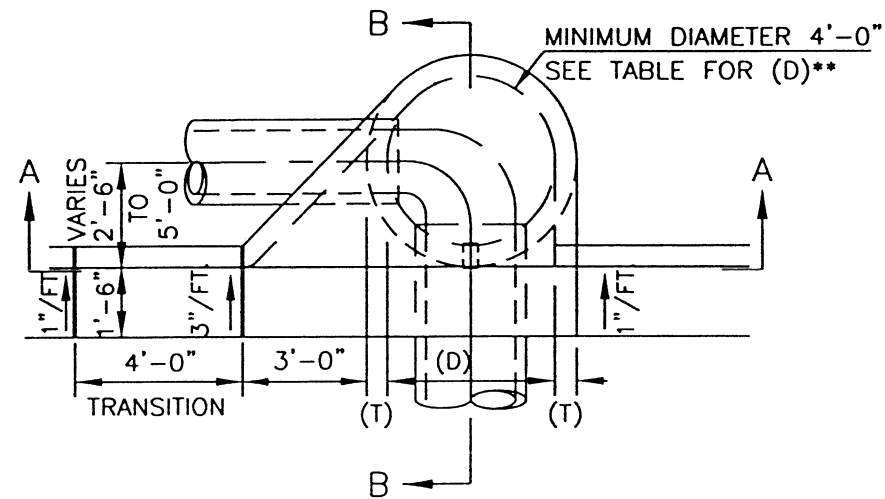

ECCENTRIC CURB INLET
LEFT HAND PLAN

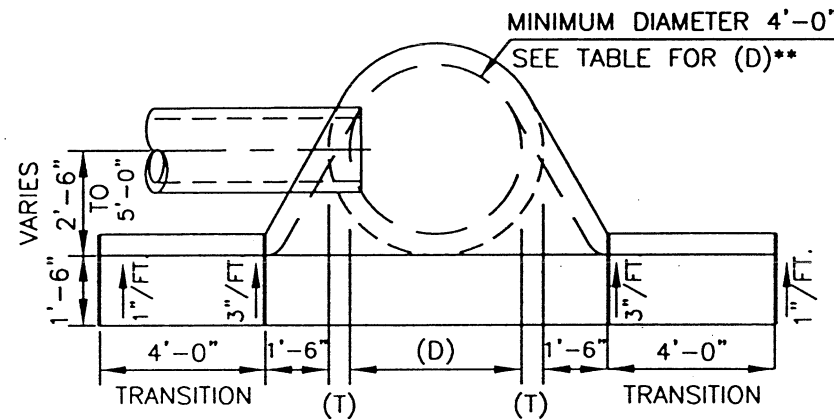

SUMP INLET

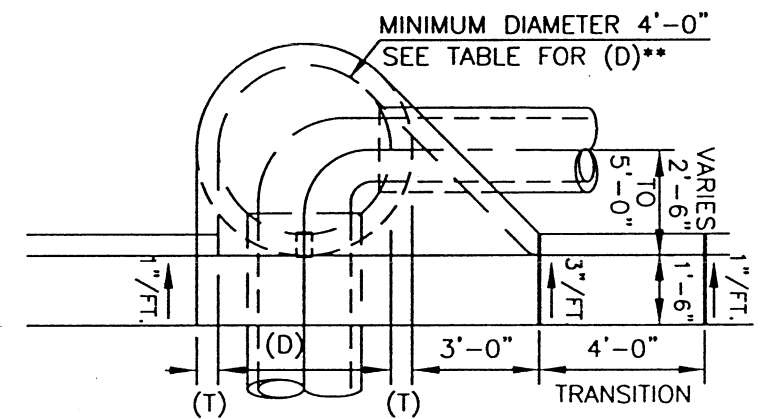



ECCENTRIC CURB INLET
RIGHT HAND PLAN

** SEE DETAILS ON SD-610.02 FOR
CROSS SECTIONS, NOTES, AND DEPTH TABLE.

CITY OF CHATTANOOGA AND HAMILTON COUNTY
CURB INLET (PRECAST CONCRETE)


DATE OF ORIGINAL ISSUE
DECEMBER 10, 1999

STANDARD NUMBER: SD-610.01

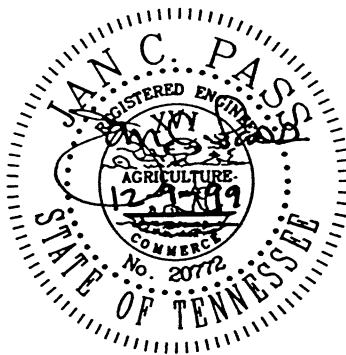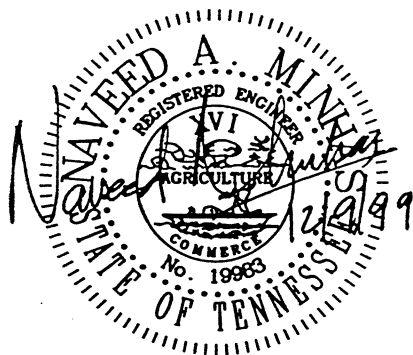


0	INITIAL ISSUE	12/10/99
NO.	REVISION	DATE

PLACE BRICK OR NON-SHRINK GROUT TO ADJUST TOP SECTION ELEVATION TO PROPERLY MEET ADJACENT TOP-OF-CURB ELEVATION.*

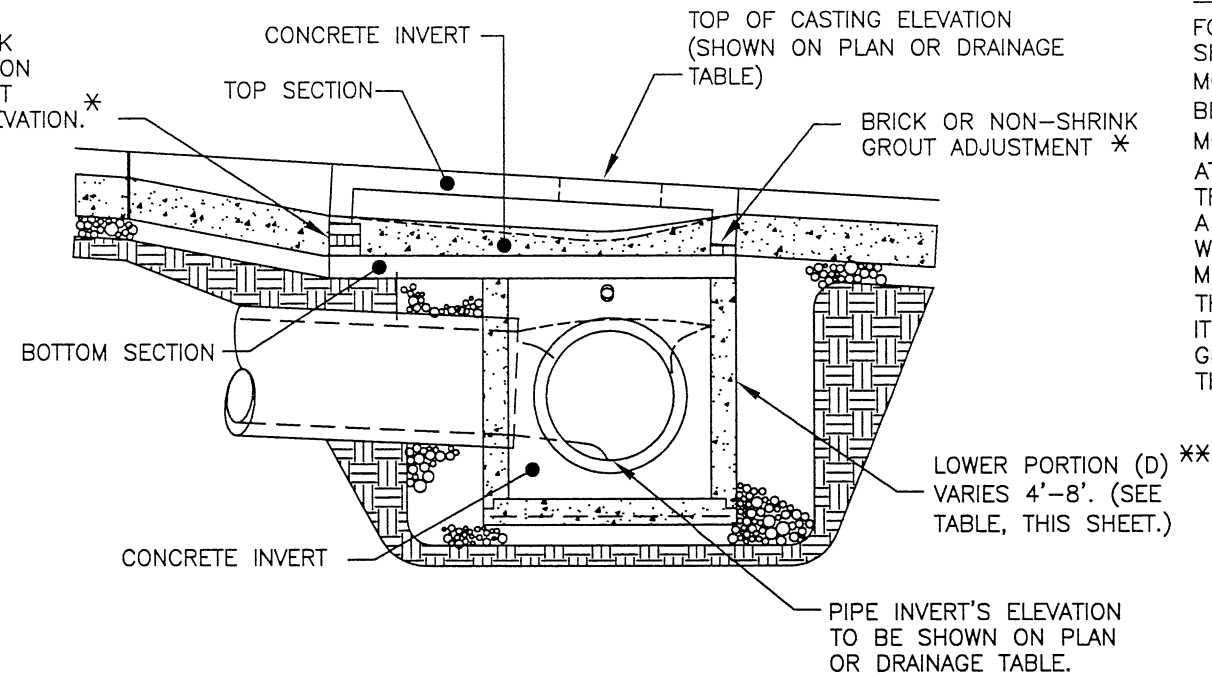

SECTION A-A

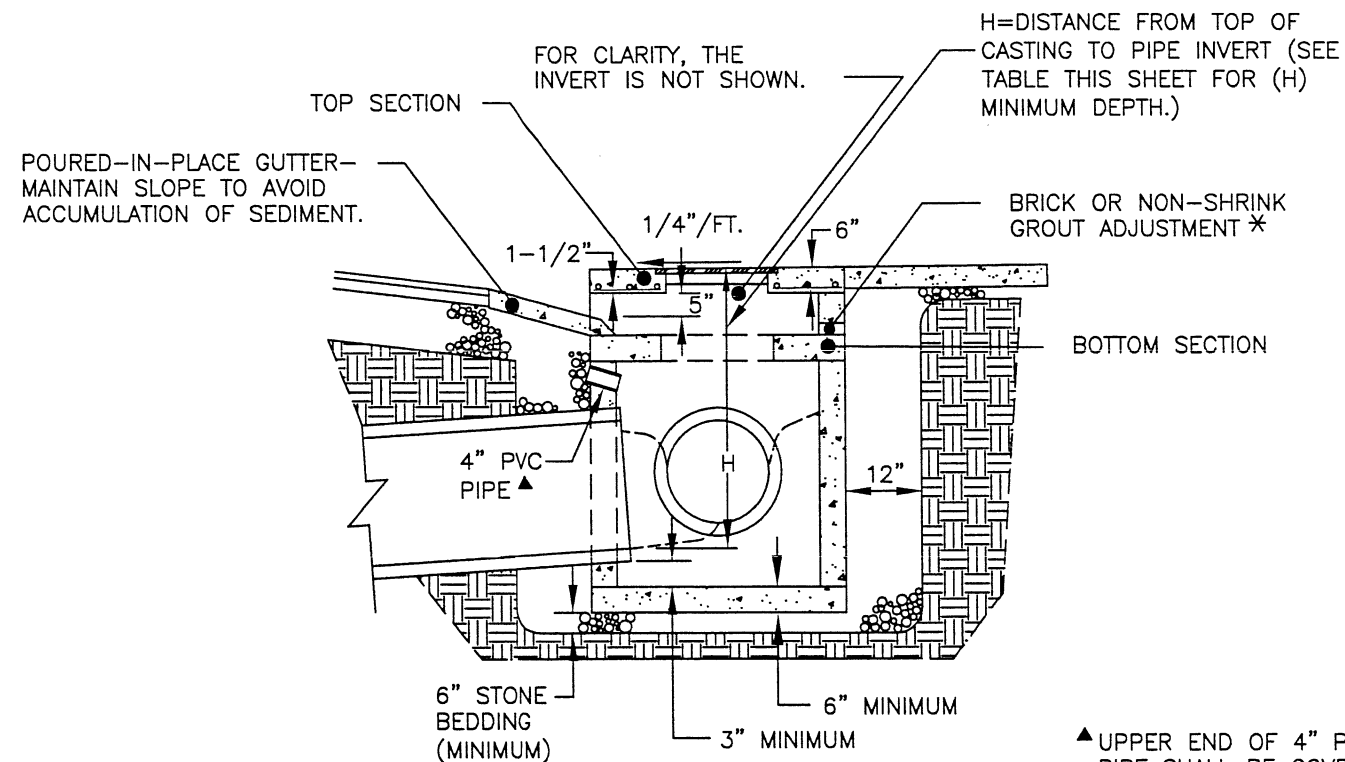

SECTION B-B

* ADJUSTMENTS

FOR BRICK ADJUSTMENT CONSTRUCTION, JOINTS SHALL ALWAYS BE COMPLETELY FILLED WITH MORTAR. VERTICAL MORTAR JOINTS SHALL NOT BE MORE THAN 3/8" THICK AND HORIZONTAL MORTAR JOINTS NOT LESS THAN 3/8" THICK AT THE INSIDE FACE. INSIDE JOINTS SHALL BE TROWEL STRUCK, FLUSH JOINTS TO PROVIDE A SMOOTH, CLEAN SURFACE, WHILE OUTSIDE WALLS SHALL BE ENTIRELY COVERED WITH MORTAR FOR A SMOOTH, CLEAN SURFACE. IF THE REQUIRED ADJUSTMENT IS LESS THAN 3", IT SHALL BE MADE BY PLACING NON-SHRINK GROUT TO OBTAIN THE PROPER ELEVATION AT THE TOP OF THE SLAB.

NOTES

1. THE LOWER PORTION (ROUND, PRE-CAST MANHOLE) SHALL BE CONSTRUCTED TO MEET A.S.T.M. C-478.
2. MANHOLE STEPS ON 16" CENTERS SHALL BE PROVIDED WHEN THE CURB INLET DEPTH EXCEEDS FOUR (4) FEET.
3. THE MANHOLE FRAME AND COVER SHALL BE ACHESON FOUNDRY CASTING A-2522-41C OR EQUAL.
4. THE WORDS "NO DUMPING-DRAINS TO RIVER" ARE TO BE ON THE TOP SIDE OF EACH COVER. (SEE SD-301.03.)
5. CATCH BASIN FRAMES, BACKS, AND GRATES THAT ARE REMOVED BY THE CONTRACTOR SHALL REMAIN THE PROPERTY OF THE OWNER.
6. THE TOP SURFACE OF THE TOP SECTION SHALL HAVE A BROOM FINISH TO MATCH THE EXISTING OR PROPOSED SIDEWALK.
7. THE BOTTOM SECTION MAY BE RECTANGULAR.

PIPE SIZE	(D) LOWER PORTION INLET DIAMETER**	(T) WALL THICKNESS	(H) MINIMUM DEPTH
		CONCRETE	
12"	4'	5"	3.75'
15"	4'	5"	4.0'
18"	4'	5"	4.25'
21"	4'	5"	4.75'
24"	4'	5"	5.0'
30"	4'	5"	5.5'
36"	5'	6"	6.75'
42"	6'	7"	7.25'
48"	6'	8"	7.75'
54"	7'	7"	8.3'
60"	8'	9"	8.8'
SPAN RISE			
23"x14"	4'	5"	4.0'
30"x19"	4'	6"	4.25'
38"x24"	5'	6"	5.75'
45"x29"	6'	7"	6.25'
53"x34"	7'	8"	6.75'
60"x38"	8'	9"	7.0'



** DIAMETER OF LOWER PORTION SHALL MEET MINIMUM DIAMETER (D) AS LISTED ABOVE. DIAMETER IS BASED ON PROPOSED PIPE SIZE. A PRECAST TRANSITION SLAB WILL BE UTILIZED TO ACCOMMODATE THE USE OF THE TOP PORTION AS SHOWN AND DIMENSIONED ON THIS DETAIL.

CITY OF CHATTANOOGA AND HAMILTON COUNTY
CURB INLET (PRECAST CONCRETE)

1	REVISIONS AS MARKED OR CLOUDED	8/24/01
0	INITIAL ISSUE	12/10/99
NO.	REVISION	DATE


DATE OF ORIGINAL ISSUE
DECEMBER 10, 1999

STANDARD NUMBER : SD-610.02

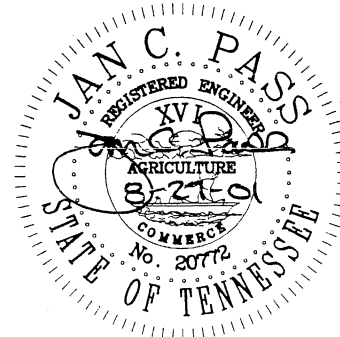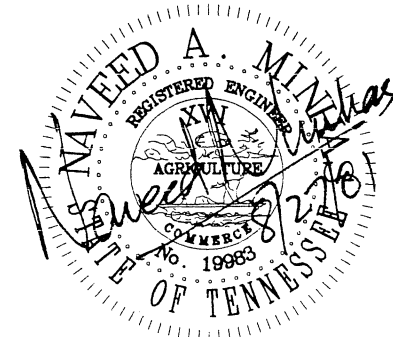


REPAIRS

F:\STDDWG\REPAIR DETAILS\REPDET(ROADWAY)_1.dwg

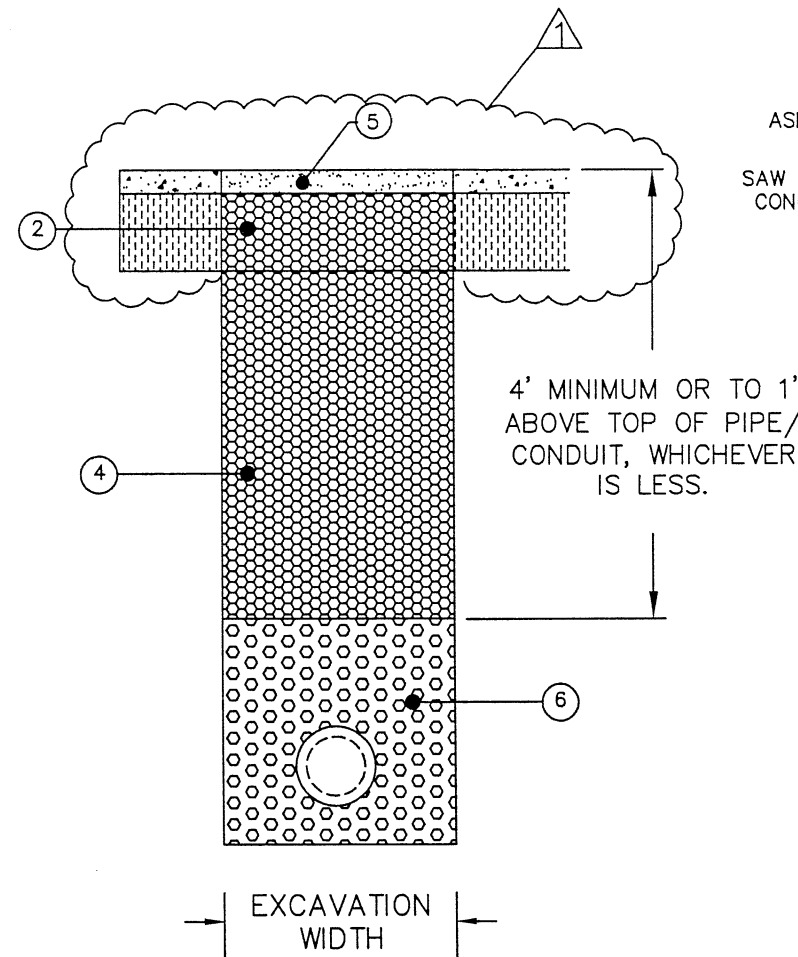

TEMPORARY REPAIR

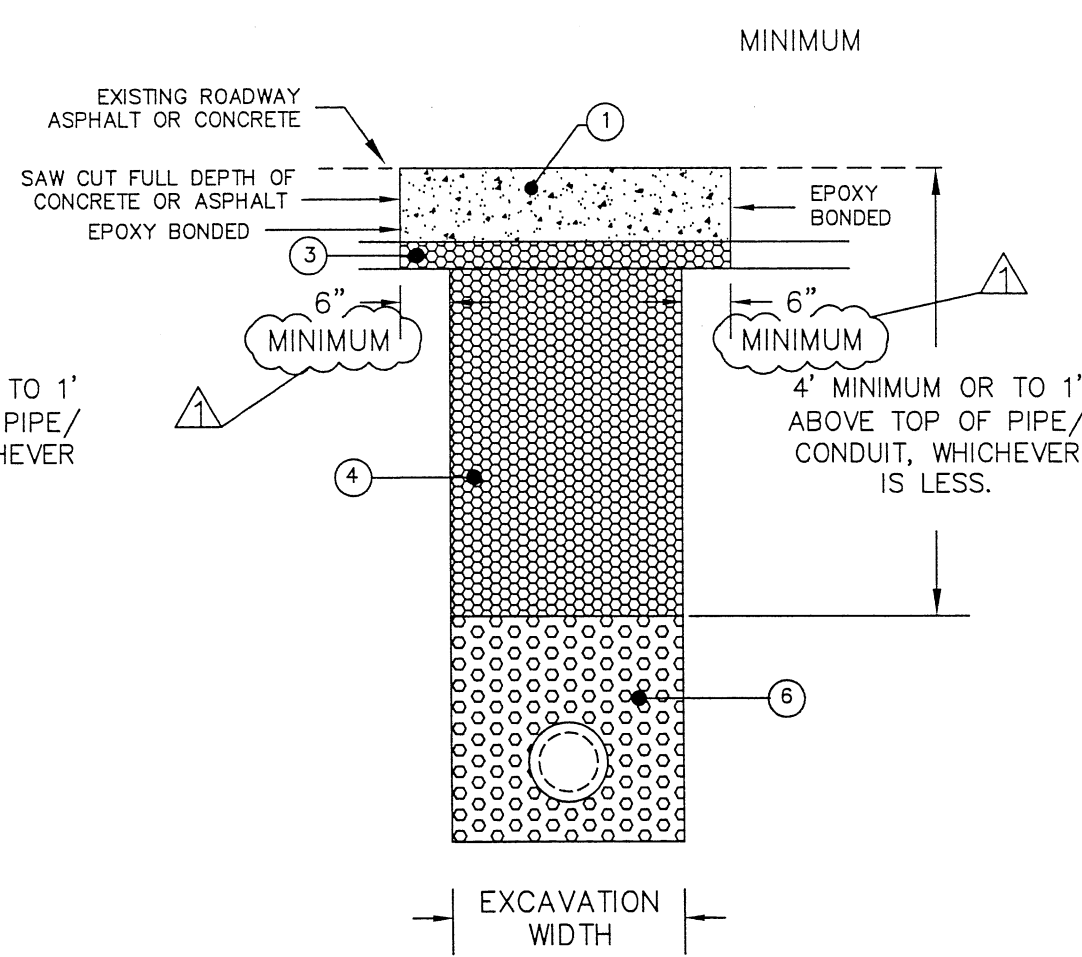

COMPLETED REPAIR



DRAWING NOTES

- ① CLASS "A" CONCRETE PAVEMENT (4,000 P.S.I. MINIMUM), 8" MINIMUM THICKNESS, COARSE BROOM FINISH – THE CONCRETE SHALL BE COLORED AND STAMPED TO MATCH THE ADJACENT CONCRETE AS REQUIRED.
- ② MINERAL AGGREGATE BASE, TYPE A, GRADING D (33-P*) – COMPACTED TO A DENSITY OF 95% STANDARD PROCTOR. THE THICKNESS SHALL BE THE GREATER OF EIGHT INCHES (8") OR THE EXISTING DEPTH OF BASE MATERIAL.
- ③ MINERAL AGGREGATE BASE, TYPE A, GRADING D (33-P*) – COMPACTED TO A DENSITY OF 95% STANDARD PROCTOR. THE THICKNESS SHALL BE THE GREATER OF FOUR INCHES (4") OR THE EXISTING DEPTH OF BASE MATERIAL.
- ④ MINERAL AGGREGATE BACKFILL, TYPE A, GRADING D (33-P*) – COMPACTED TO EIGHT INCH (8") LIFTS AND TO A DENSITY OF 95% STANDARD PROCTOR.
- ⑤ COLD MIX ASPHALT – WHEN A TEMPORARY ASPHALT PATCH IS USED, IT SHALL BE PLACED IMMEDIATELY AFTER THE CRUSHED STONE BACKFILL IS PLACED.
- ⑥ BEDDING MATERIAL – SEE SD-307.01.


GENERAL REQUIREMENTS

1. ALL STREET CUTS MUST BE REPAIRED IMMEDIATELY AFTER BACK-FILLING AND ACCORDING TO THIS STANDARD.
2. A RIGHT-OF-WAY PERMIT AND AN APPROVED TRAFFIC CONTROL PLAN ARE REQUIRED FOR ALL CUTS IN CITY STREETS.
3. WHERE LONGITUDINAL CUTS ARE MADE, THE OWNER RESERVES THE RIGHT TO REQUIRE ADDITIONAL RESURFACING BEYOND THE LIMITS OF THE REPAIR TO ENSURE THE PROPER RIDING CHARACTERISTICS AND THE STABILITY OF THE PAVEMENT.
4. ALL REFERENCES TO MATERIALS ARE DESCRIBED IN DETAIL IN THE CITY OF CHATTANOOGA'S STANDARD SPECIFICATIONS. THESE SPECIFICATIONS MUST BE USED AS A REFERENCE WHEN ORDERING MATERIALS.
5. EXISTING CONCRETE STREETS THAT HAVE BEEN OVERLAID WITH ASPHALT SHALL BE REPAIRED WITH CONCRETE HAVING A DEPTH EQUAL TO THE EXISTING CONCRETE PLUS THE ADJACENT EXISTING ASPHALT OVERLAY.
6. WHERE EXISTING CONSTRUCTION AND EXPANSION JOINTS ARE ENCOUNTERED IN CONCRETE PAVEMENT CUTS, THE ENGINEER SHALL DESIGNATE LOCATION, SIZE, AND MATERIALS TO CONSTRUCT JOINTS IN THE NEW CONCRETE SURFACE.


* "33-P (PUG)" – 303-01, TYPE A, GRADING D ("33-P"), TENNESSEE D.O.T. SPECIFICATIONS

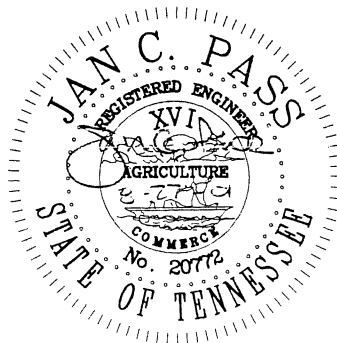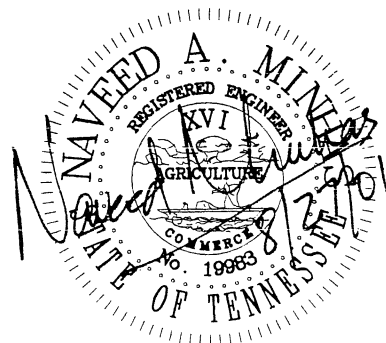

CITY OF CHATTANOOGA AND HAMILTON COUNTY			
REPAIR DETAILS (ROADWAY)			
1	REVISIONS AS MARKED OR CLOUDED	8/24/01	DATE OF ORIGINAL ISSUE DECEMBER 10, 1999
0	INITIAL ISSUE	12/10/99	
NO.	REVISION	DATE	
			STANDARD NUMBER: SD-700.01

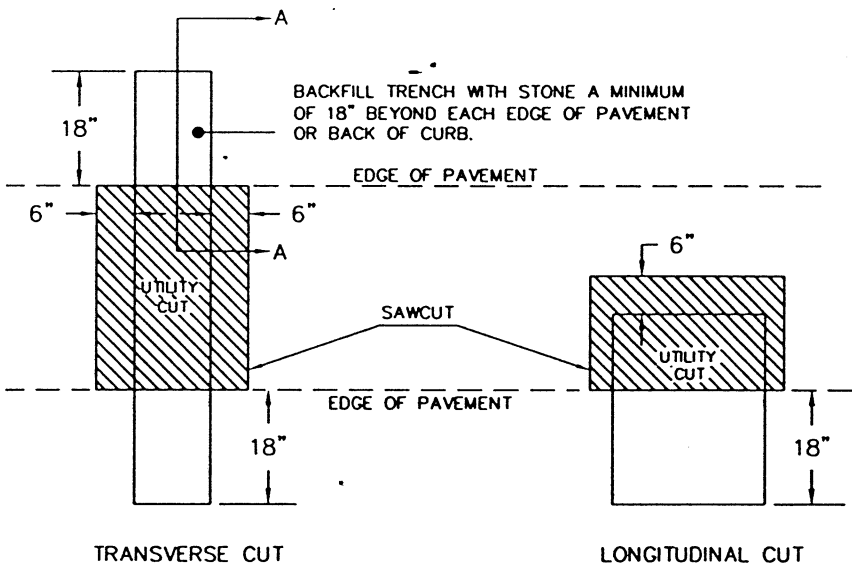

NOTE
WHERE PRACTICAL, TRANSVERSE CUTS SHALL BE PERPENDICULAR TO THE PAVEMENT CENTERLINE, AND LONGITUDINAL CUTS SHALL BE PARALLEL TO IT.

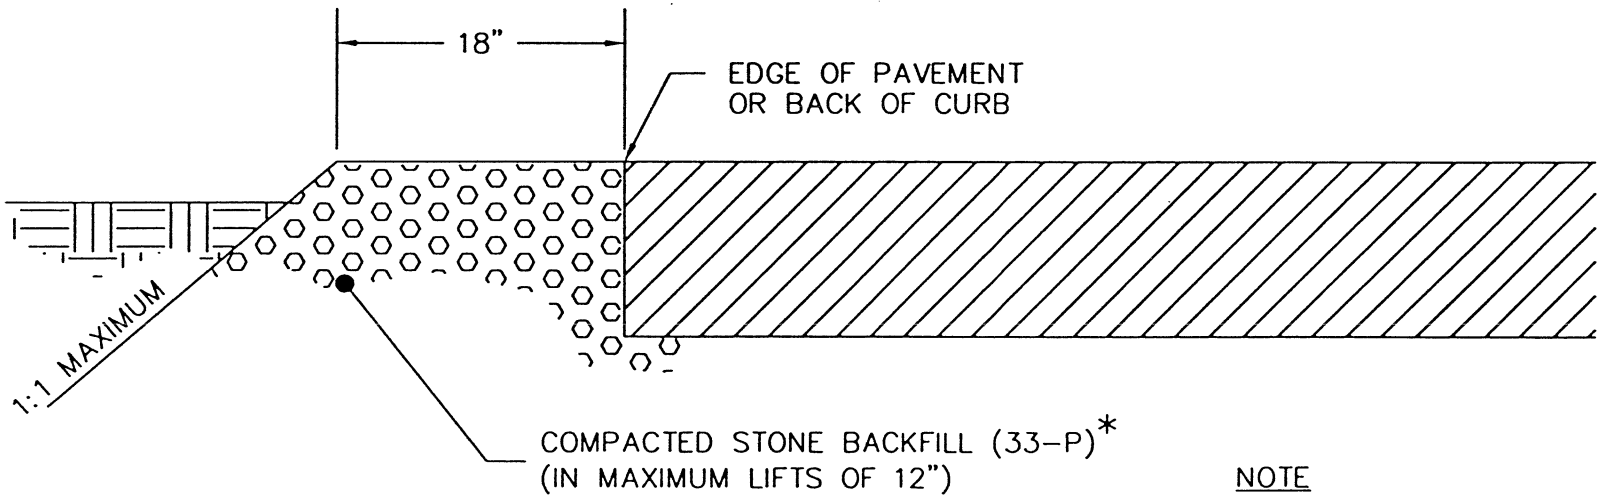


NOTE
ALL EXCAVATED, GRASS-COVERED SHOULDERS MUST BE LEVELED, AND THEN HAVE TOP SOIL AND SEED ADDED. ALL AREAS ON SHOULDERS USED FOR PARKING MUST BE BACKFILLED TO THE TOP WITH CRUSHED STONE (33-P). *


SECTION A-A

* "33-P (PUG)" - 303-01, TYPE A, GRADING D ("33-P"), TENNESSEE D.O.T. SPECIFICATIONS.


CITY OF CHATTANOOGA AND HAMILTON COUNTY
REPAIR DETAILS (ROADWAY)

0		INITIAL ISSUE	12/10/99	DATE OF ORIGINAL ISSUE	STANDARD NUMBER: SD-700.02
NO.		REVISION	DATE	DECEMBER 10, 1999	

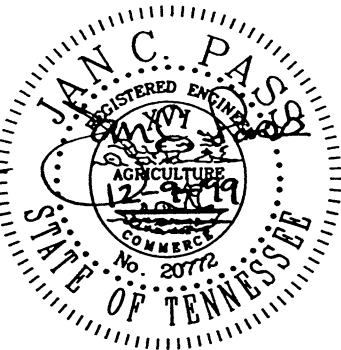


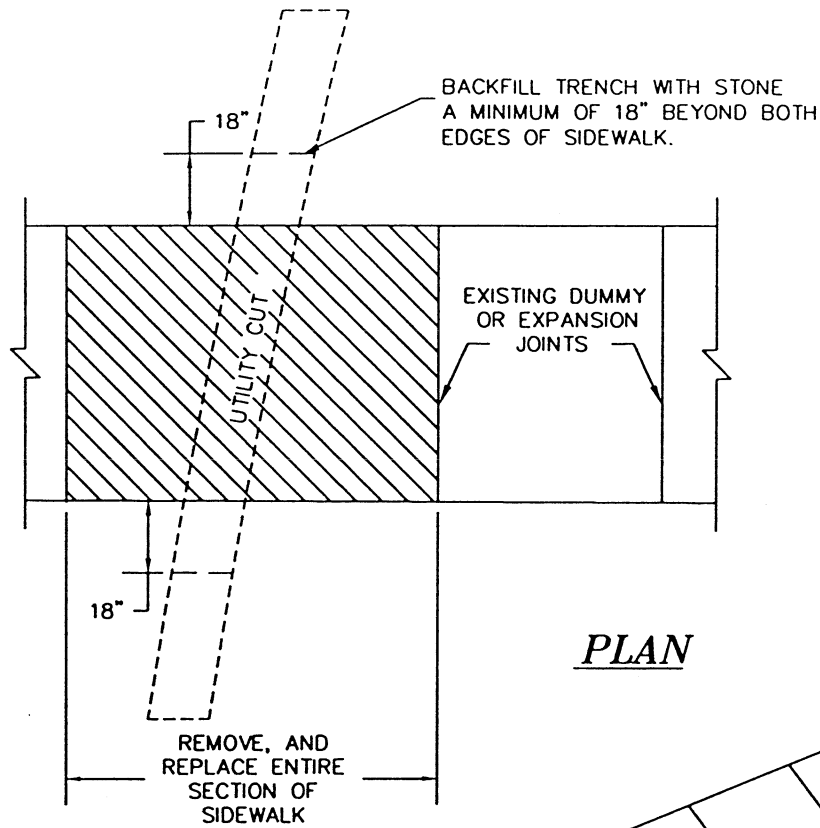


PLAN

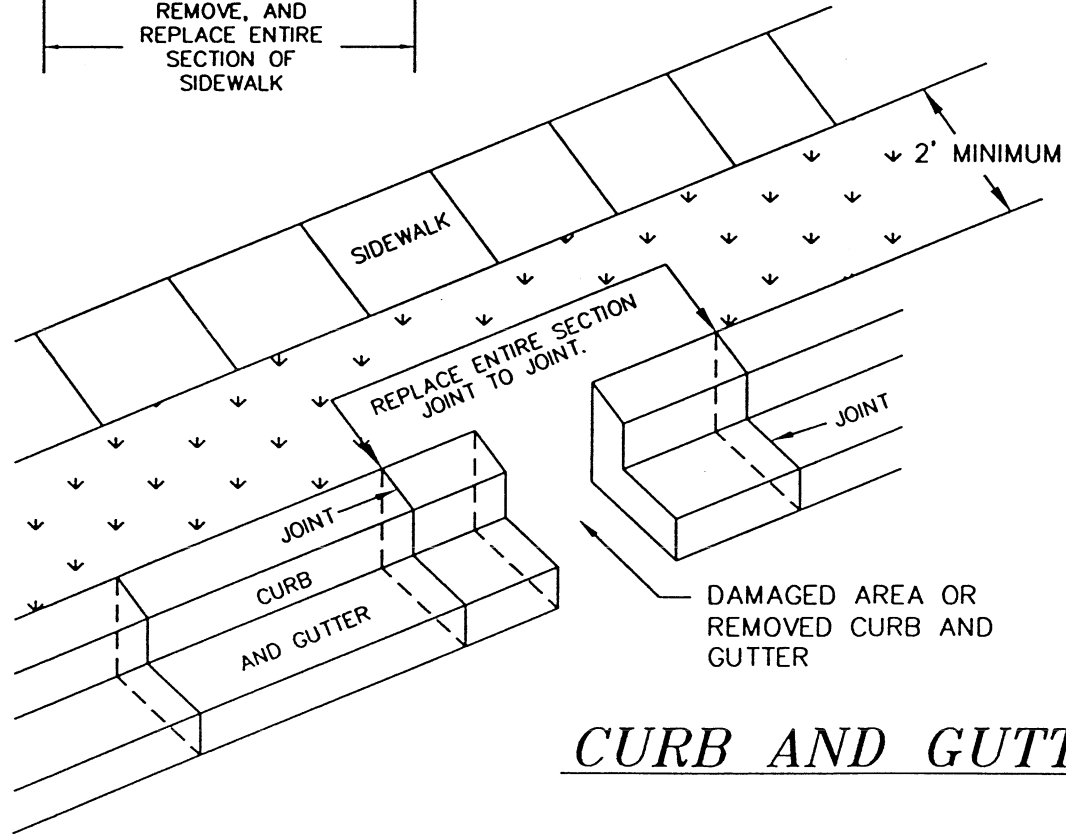

CURB AND GUTTER

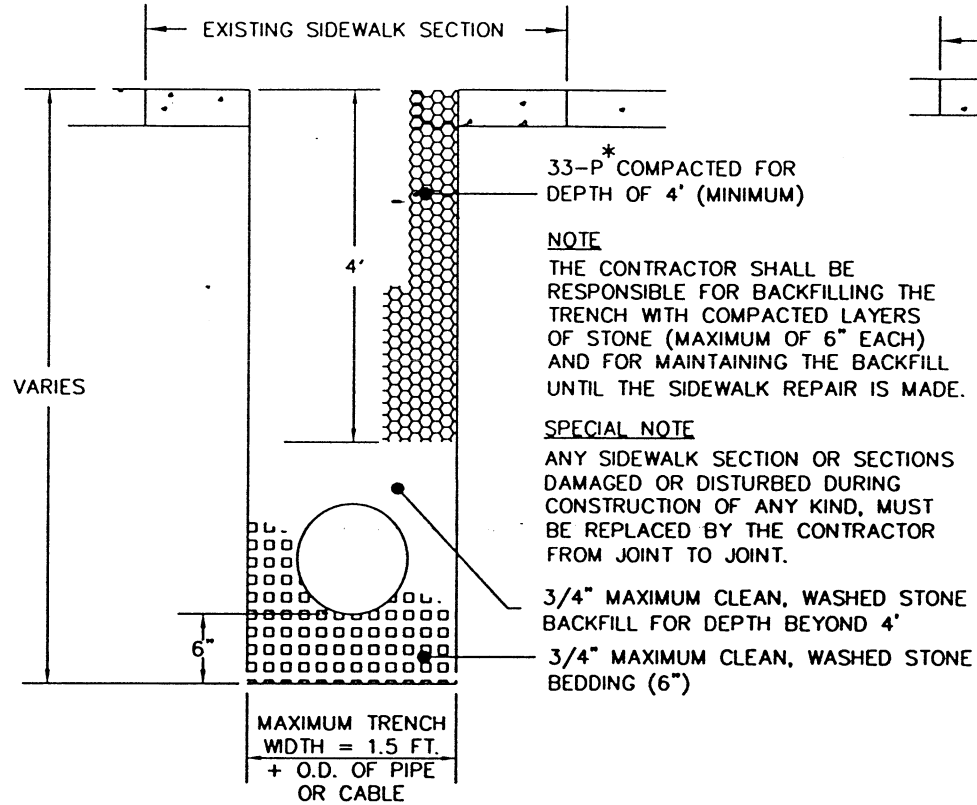

BACKFILL DETAIL

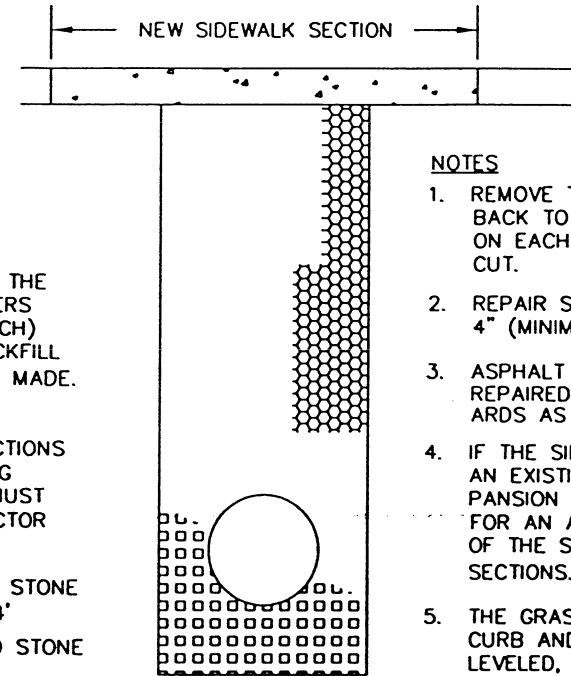

REPAIR DETAIL

NOTES


1. REMOVE THE EXISTING SIDEWALK
BACK TO THE NEAREST JOINT
ON EACH SIDE OF THE UTILITY
CUT.
2. REPAIR SHALL CONSIST OF A
4" (MINIMUM) CONCRETE SLAB.
3. ASPHALT SIDEWALKS SHALL BE
REPAIRED TO THE SAME STAND-
ARDS AS STREET CUTS.
4. IF THE SIDEWALK DOES NOT HAVE
AN EXISTING DUMMY JOINT OR EX-
PANSION JOINT, ASK THE INSPECTOR
FOR AN ACCEPTABLE REPLACEMENT
OF THE SIDEWALK SECTION OR
SECTIONS.
5. THE GRASS AREA BETWEEN THE
CURB AND THE SIDEWALK MUST BE
LEVELED, AND THEN HAVE TOP SOIL
AND SEED ADDED.

SIDEWALK

NOTES

1. ANY CURB AND GUTTER SECTION THAT IS CUT, DAMAGED,
OR DISTURBED DURING CONSTRUCTION OF ANY KIND, MUST
BE REPLACED BY THE CONTRACTOR FROM JOINT TO JOINT
USING PROPER FORMS AND CONCRETE.
2. ANY EXCAVATED OR DISTURBED GRASS AREA MUST BE
LEVELED, AND THEN HAVE TOPSOIL AND SEED ADDED.

* "33-P (PUG)" - 303-01,
TYPE A, GRADING D
("33-P"), TENNESSEE D.O.T.
SPECIFICATIONS.

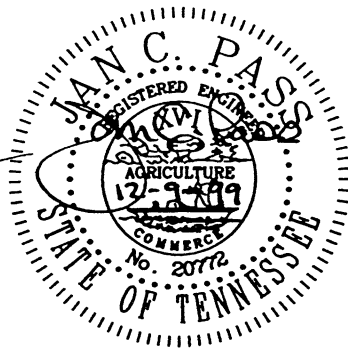

0	INITIAL ISSUE	12/10/99
NO.	REVISION	DATE

CITY OF CHATTANOOGA AND HAMILTON COUNTY


REPAIR DETAILS (CURB AND GUTTER/SIDEWALK)

DATE OF ORIGINAL ISSUE
DECEMBER 10, 1999

STANDARD NUMBER: **SD-701.01**


F:\STDDWG\sidewalkrepair (EPB)\sidewalkrepair (EPB).dwg Thu Dec 09 08:29 1999 STATIONS 24

SIDEWALK REPAIR AFTER POLE REPLACEMENT

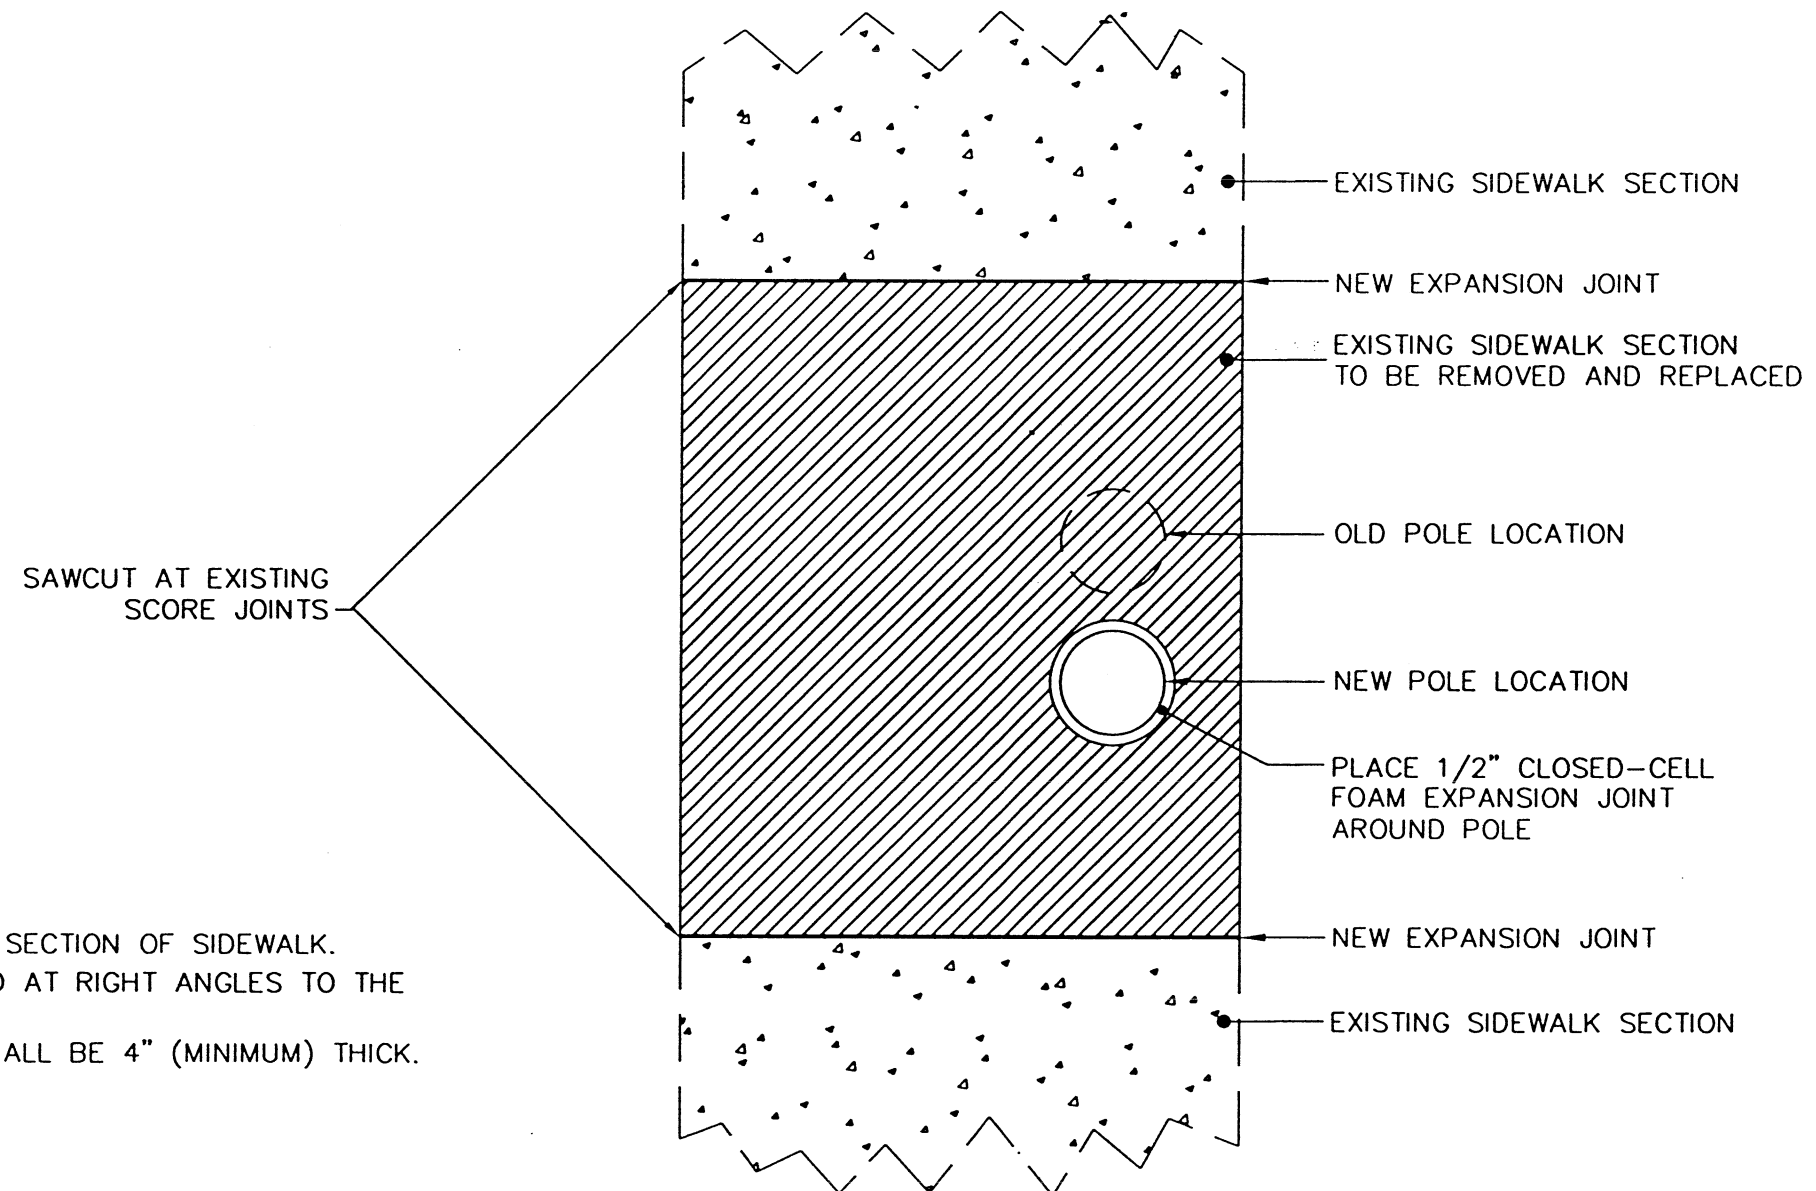

NOTES

1. REPLACE THE ENTIRE AFFECTED SECTION OF SIDEWALK.
2. ALL CUTS ARE TO BE NEAT AND AT RIGHT ANGLES TO THE SIDEWALK EDGES.
3. THE NEW CONCRETE SECTION SHALL BE 4" (MINIMUM) THICK.

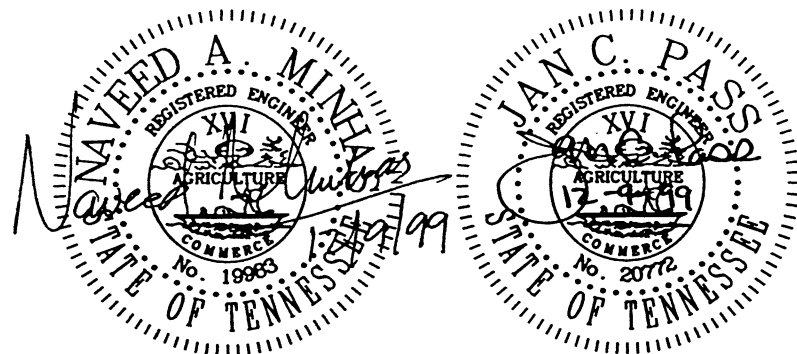

			CITY OF CHATTANOOGA AND HAMILTON COUNTY	
			REPAIR DETAIL (SIDEWALK)-POLE REPLACEMENT	
			DATE OF ORIGINAL ISSUE	
0	INITIAL ISSUE	12/10/99	STANDARD NUMBER: SD-702.01	
NO.	REVISION	DATE		


DRAWING NOTES

- ① 2" TYPE "E" ASPHALTIC SURFACE MIX
- ② 6" STONE BASE (33-P*), 95% STANDARD PROCTOR
- ③ 1 1/2" TYPE "E" ASPHALTIC SURFACE MIX
- ④ 2 1/2" MODIFIED "B" ASPHALTIC BINDER
- ⑤ 10" STONE BASE (33-P*), 95% STANDARD PROCTOR
- ⑥ 6" CLASS "A" CONCRETE, 4,000 P.S.I. MINIMUM
- ⑦ 4" STONE BASE (33-P*), 95% STANDARD PROCTOR
- ⑧ 8" CLASS "A" CONCRETE, 4,000 P.S.I. MINIMUM
- ⑨ TACK COAT - 0.05 GAL./S.Y., AC 20

GENERAL REQUIREMENTS


1. SEE SD-307.01, SD-308.01, AND SD-308.02 FOR BACKFILL REQUIREMENTS FOR THE TRENCH BELOW THE SURFACE.
2. SURFACE REPAIR SHALL BE DONE TO A SAWCUT EDGE 6" BEYOND THE TRENCH ON ALL SIDES OF THE REPAIR.
3. ALL REPAIRS SHALL MEET THE MINIMUM REQUIREMENTS AS SHOWN ON THIS DRAWING OR THOSE REQUIREMENTS OF PRESENT CONDITIONS, WHICHEVER IS GREATER.

* "33-P (PUG)" - 303-01, TYPE A, GRADING D ("33-P"), TENNESSEE D.O.T. SPECIFICATIONS

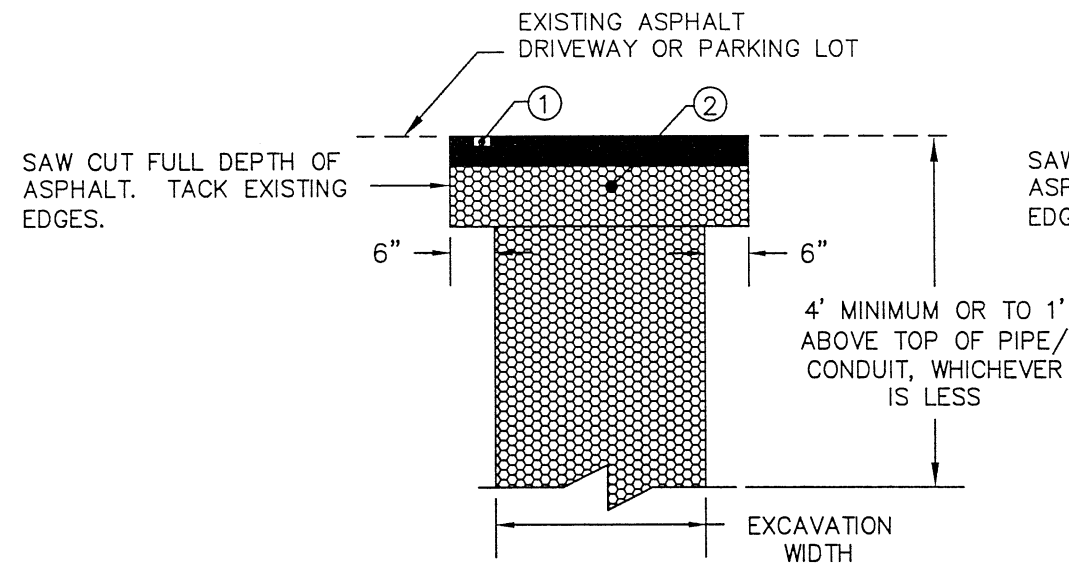


ASPHALT REPAIR

RESIDENTIAL DRIVEWAY AND
LIGHT DUTY PARKING LOT

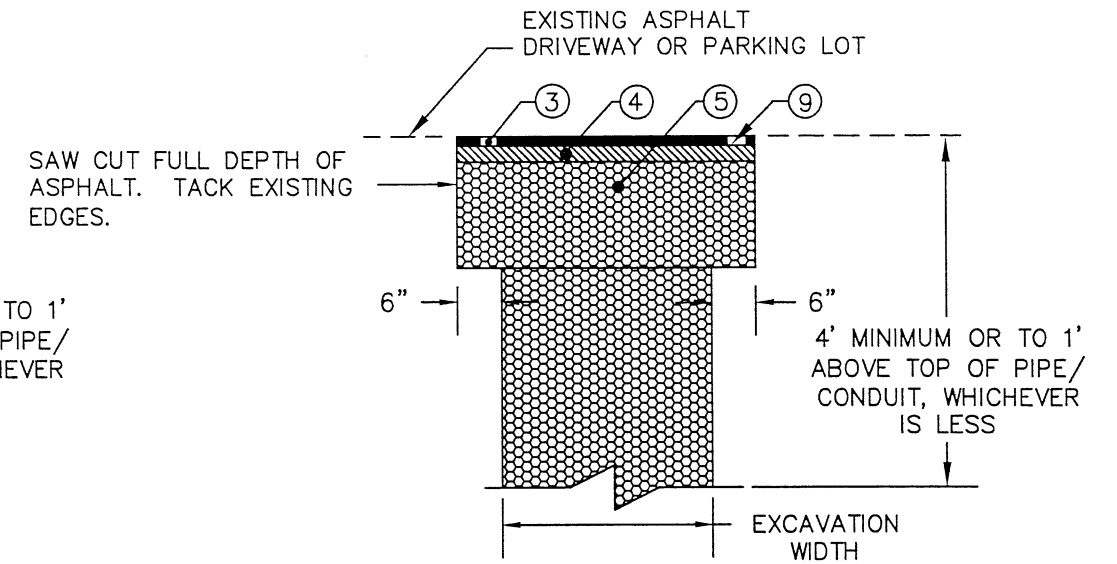


ASPHALT REPAIR

COMMERCIAL DRIVEWAY AND
HEAVY DUTY PARKING LOT

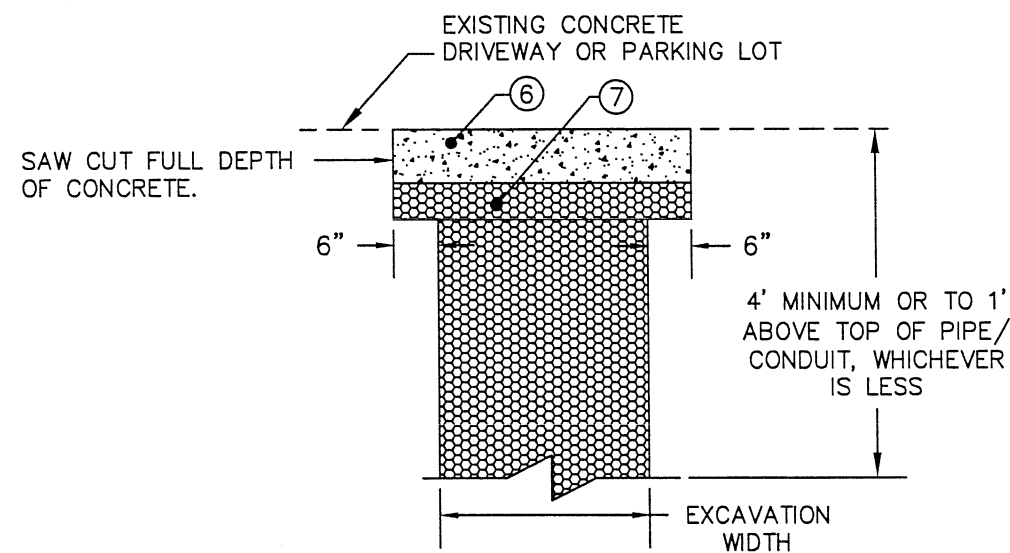



CONCRETE REPAIR

RESIDENTIAL DRIVEWAY AND
LIGHT DUTY PARKING LOT

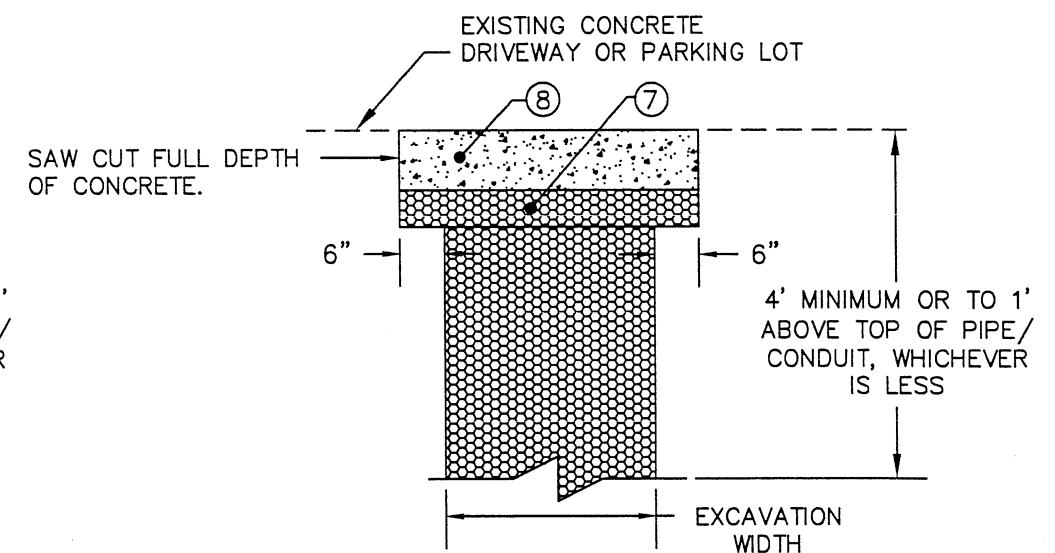

CONCRETE REPAIR

COMMERCIAL DRIVEWAY AND
HEAVY DUTY PARKING LOT

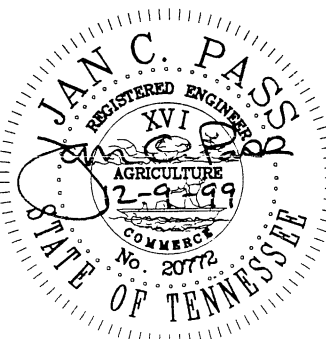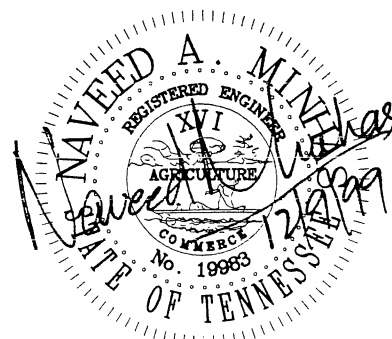

CITY OF CHATTANOOGA AND HAMILTON COUNTY
REPAIR DETAILS (DRIVEWAY/PARKING LOT)

0		INITIAL ISSUE	12/10/99	DATE OF ORIGINAL ISSUE	STANDARD NUMBER : SD-703.01
NO.		REVISION	DATE	DECEMBER 10, 1999	